


Latitude 39° 40'

Longitude 80° 15'

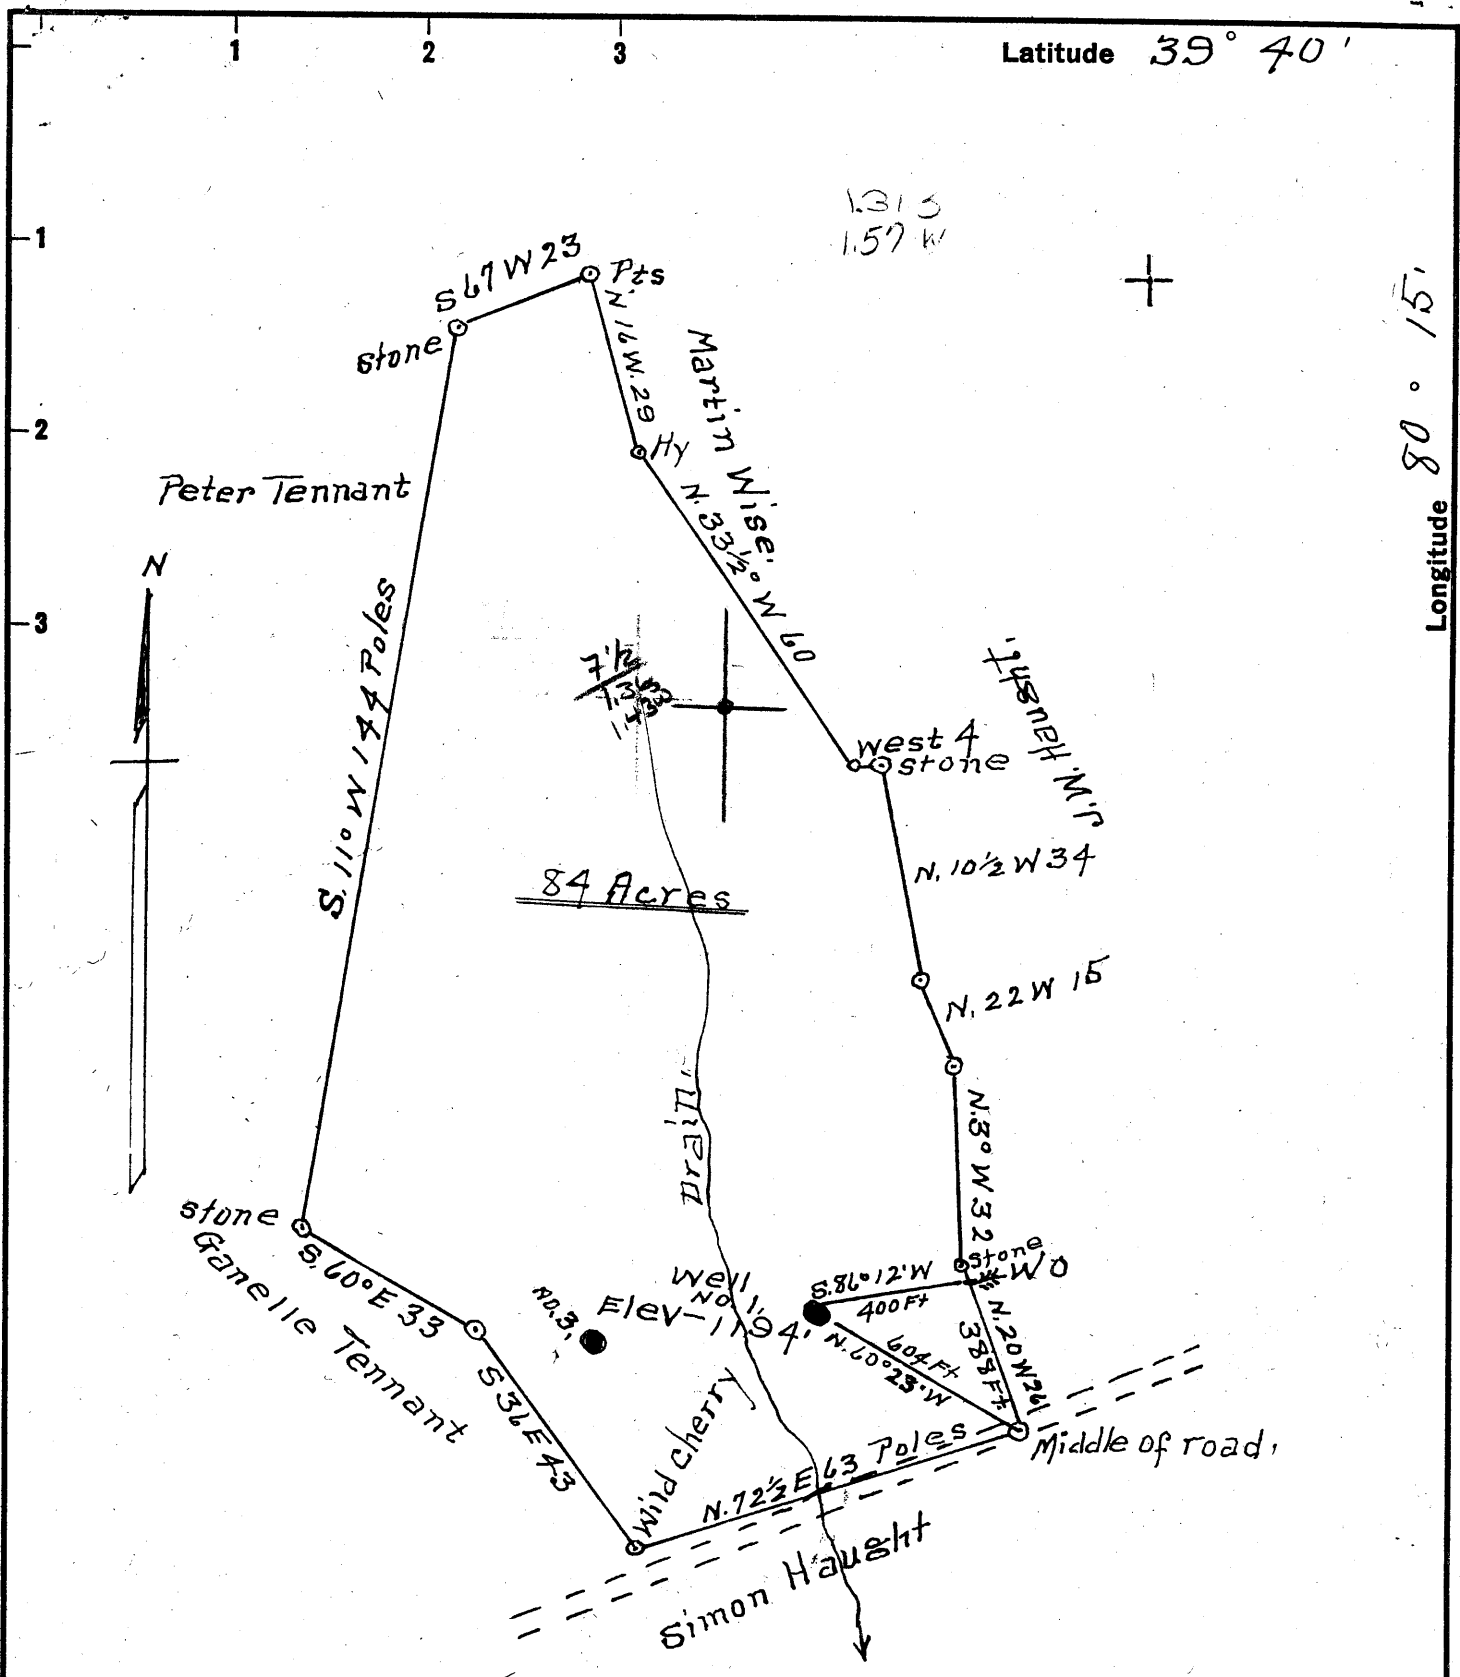

Surface = Wheeling Dollar Savings & Trust Co
Wheeling W Va.

Coal = Mountaineer Coal Co
% Ray Henderson
Box 1632 Fairmont W, Va.

Found on CNG map

- New Location
- Drill Deeper
- Abandonment

Company	Cecil Chisler & Son
Address	R# 2 Fairview, WVA.
Farm	Simon Haught
Tract	Lewis Gump Lease 1 Acres 84 Lease No.
Well (Farm) No.	1 Serial No.
Elevation (Spirit Level)	1194'
Quadrangle	Mannington
County	Monongalia District Battelle
Engineer	A. L. Headley
Engineer's Registration No.	2021
File No.	Drawing No.
Date	10-1-61 Scale 1" = 30 poles

STATE OF WEST VIRGINIA
DEPARTMENT OF MINES
OIL AND GAS DIVISION
CHARLESTON

WELL LOCATION MAP

FILE NO. Mer-651-A
W-70229

+ Denotes location of well on United States Topographic Maps, scale 1 to 62,500, latitude and longitude lines being represented by border lines as shown.

- Denotes one inch spaces on border line of original tracing.

LATITUDE 39°40'00"

88°15'00"

LONGITUDE

75'
+
70229

7'5 OGIS topo location

7.5' loc	<u>1.345</u>	15' loc	<u>1.345</u>
	<u>1.62 W</u>	(calc.)	<u>1.62 W</u>

#122 in 1912 Co Rpt

Company _____

Farm _____

Quad Wadestown (manjra EC)

County Monongalia

District Battelle

WELL LOCATION MAP

File No. 061-70229



STATE OF WEST VIRGINIA
DEPARTMENT OF MINES
OIL AND GAS DIVISION

WELL RECORD

Quadrangle Mannington
Permit No. Ab Mon - 651A

Oil or Gas Well C11
(KIND)

Company Cecil Chisler & son
Address R.#2, Fairview, W.Va.
Farm Simon Haught Acres 84
Location Edward Pump lease
Well No. Cno Elev. 1194'
District Pattelle County Monongalia
The surface of tract is owned in fee by Wheeling Dollar Savings & Trust Co. Address Wheeling, W.Va.
Mineral rights are owned by Mountain Coal Co. c/o Ray Henderson Box 1632 Fairmont, W.Va. Address
Drilling commenced _____
Drilling completed 1907
Date Shot _____ From _____ To _____
With _____
Open Flow _____ /10ths Water in _____ Inch
_____ /10ths Merc. in _____ Inch
Volume _____ Cu. Ft.
Rock Pressure _____ lbs. _____ hrs.
Oil _____ bbls., 1st 24 hrs.
WELL ACIDIZED _____
WELL FRACTURED _____

Casing and Tubing	Used in Drilling	Left in Well	Packers
Size			Kind of Packer
16			
13			
10			Size of _____
8 1/4	<u>1674'</u>	<u>(27 lbs parted)</u>	Depth set _____
6 5/8	<u>2059</u>	<u>1950'</u>	
5 3/16	<u>2307'</u>		Perf. top _____
3x4 1/2	<u>260</u>		Perf. bottom _____
2			Perf. top _____
Liners Used			Perf. bottom _____


CASING CEMENTED _____ SIZE _____ No. Ft. _____ Date _____
COAL WAS ENCOUNTERED AT 870' FEET _____ INCHES
_____ FEET _____ INCHES FEET _____ INCHES
_____ FEET _____ INCHES FEET _____ INCHES

RESULT AFTER TREATMENT

ROCK PRESSURE AFTER TREATMENT

Fresh Water _____ Feet _____ Salt Water _____ Feet _____

Formation	Color	Hard or Soft	Top	Bottom	Oil, Gas or Water	Depth	Remarks
Psh. coal			870				
Salt sand			1745-1885				
Pig Injun			2170-2360				
Water			2260				
Fifty foot			2790-2845				
Stray sand			3070-3090				
Gordon			3105-3127				
Fourth			3134-3162				
1st Pay			3148-3152				
Top of liner			2814-				
Total depth			-3162				

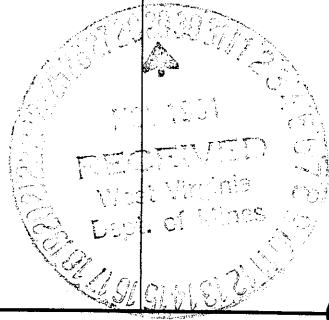

672

(over)

SIMON HAUGHT 821 - OCT 6 1962 - CECIL CHISLER & SON - MON - 651A

Formation	Color	Hard or Soft	Top	Bottom	Oil, Gas or Water	Depth Found	Remarks

Date _____, 19__

APPROVED Cecil Chisler & Son, Owner

By _____ (Title)