


6/4/67 P
LATITUDE 39° 40'

1 2 3

2.31 S
3.58 W

LONGITUDE 80° 15'

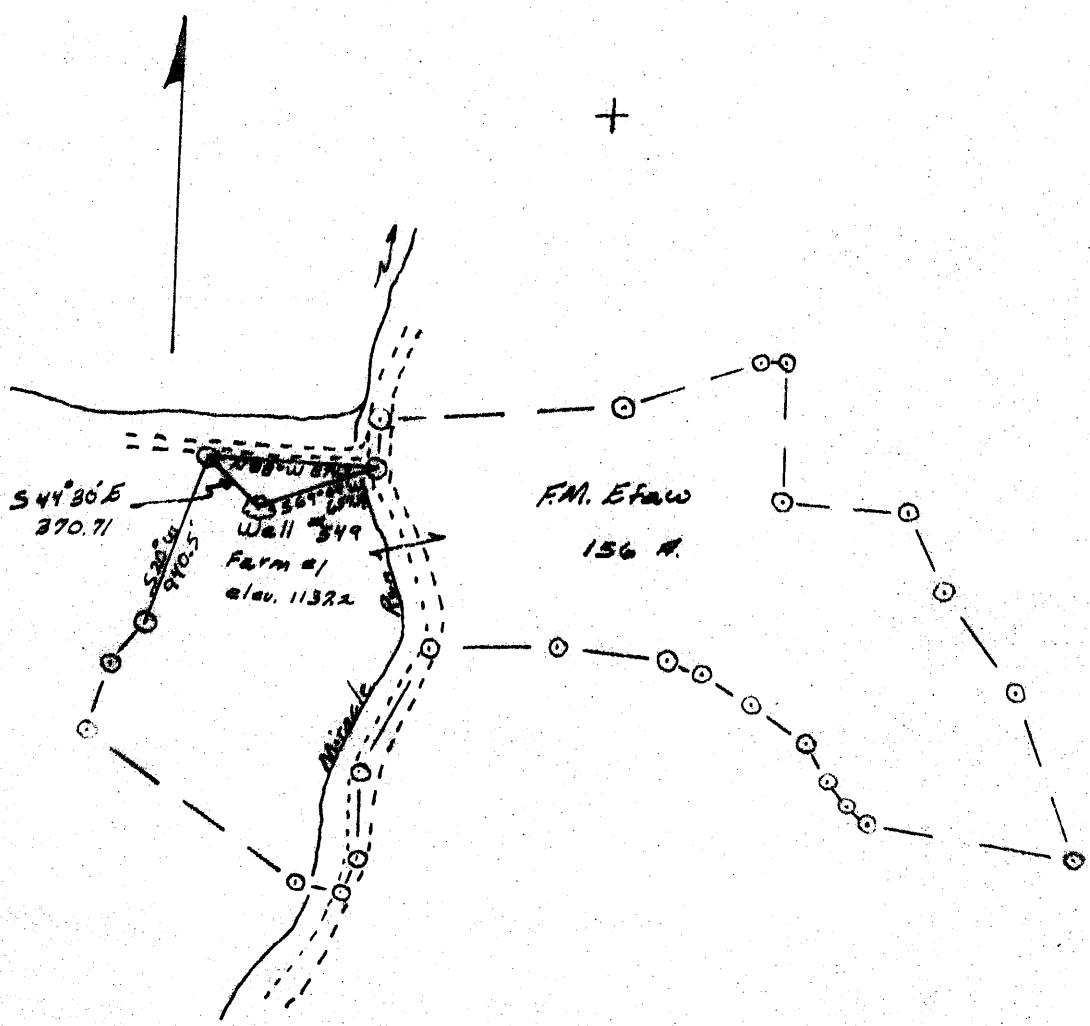

Minimum Error of Closure less than 1 in 2000

Source of Elevation State Road C.M. elev. 1137.2

Fracture

I, the undersigned, hereby certify that this map is correct to the best of my knowledge and belief and shows all the information required by paragraph 6 of the rules and regulations of the oil and gas section of the mining laws of West Virginia.

New Location

Signed: William P Foley

Drill Deeper

Squares: N S E W

Abandonment

Map No.

Company Herschel Walker
Address Wappasburg Pa.
Farm F.M. 157

STATE OF WEST VIRGINIA
DEPARTMENT OF MINES
OIL AND GAS DIVISION
CHARLESTON

Tract Acres 157 Lease No. 3146

WELL LOCATION MAP

Well (Farm) No. 524 Serial No.

FILE NO. MON-673-A

Elevation (Spirit Level) 1137.2

+ Denotes location of well on United States Topographic Maps, scale 1 to 62,500, latitude and longitude lines being represented by border lines as shown.

Quadrangle Manning E C

- Denotes one inch spaces on border line of original tracing.

County Monongalia District Battelle

Engineer William P Foley

Engineer's Registration No. 4449

File No. Drawing No.

Date 5/12/67 Scale 1" = 1000'



IMPERIAL CLOTH
TAFFORD CLOTH

74826
JUN 26 1967