


3,12 S
2.45 W

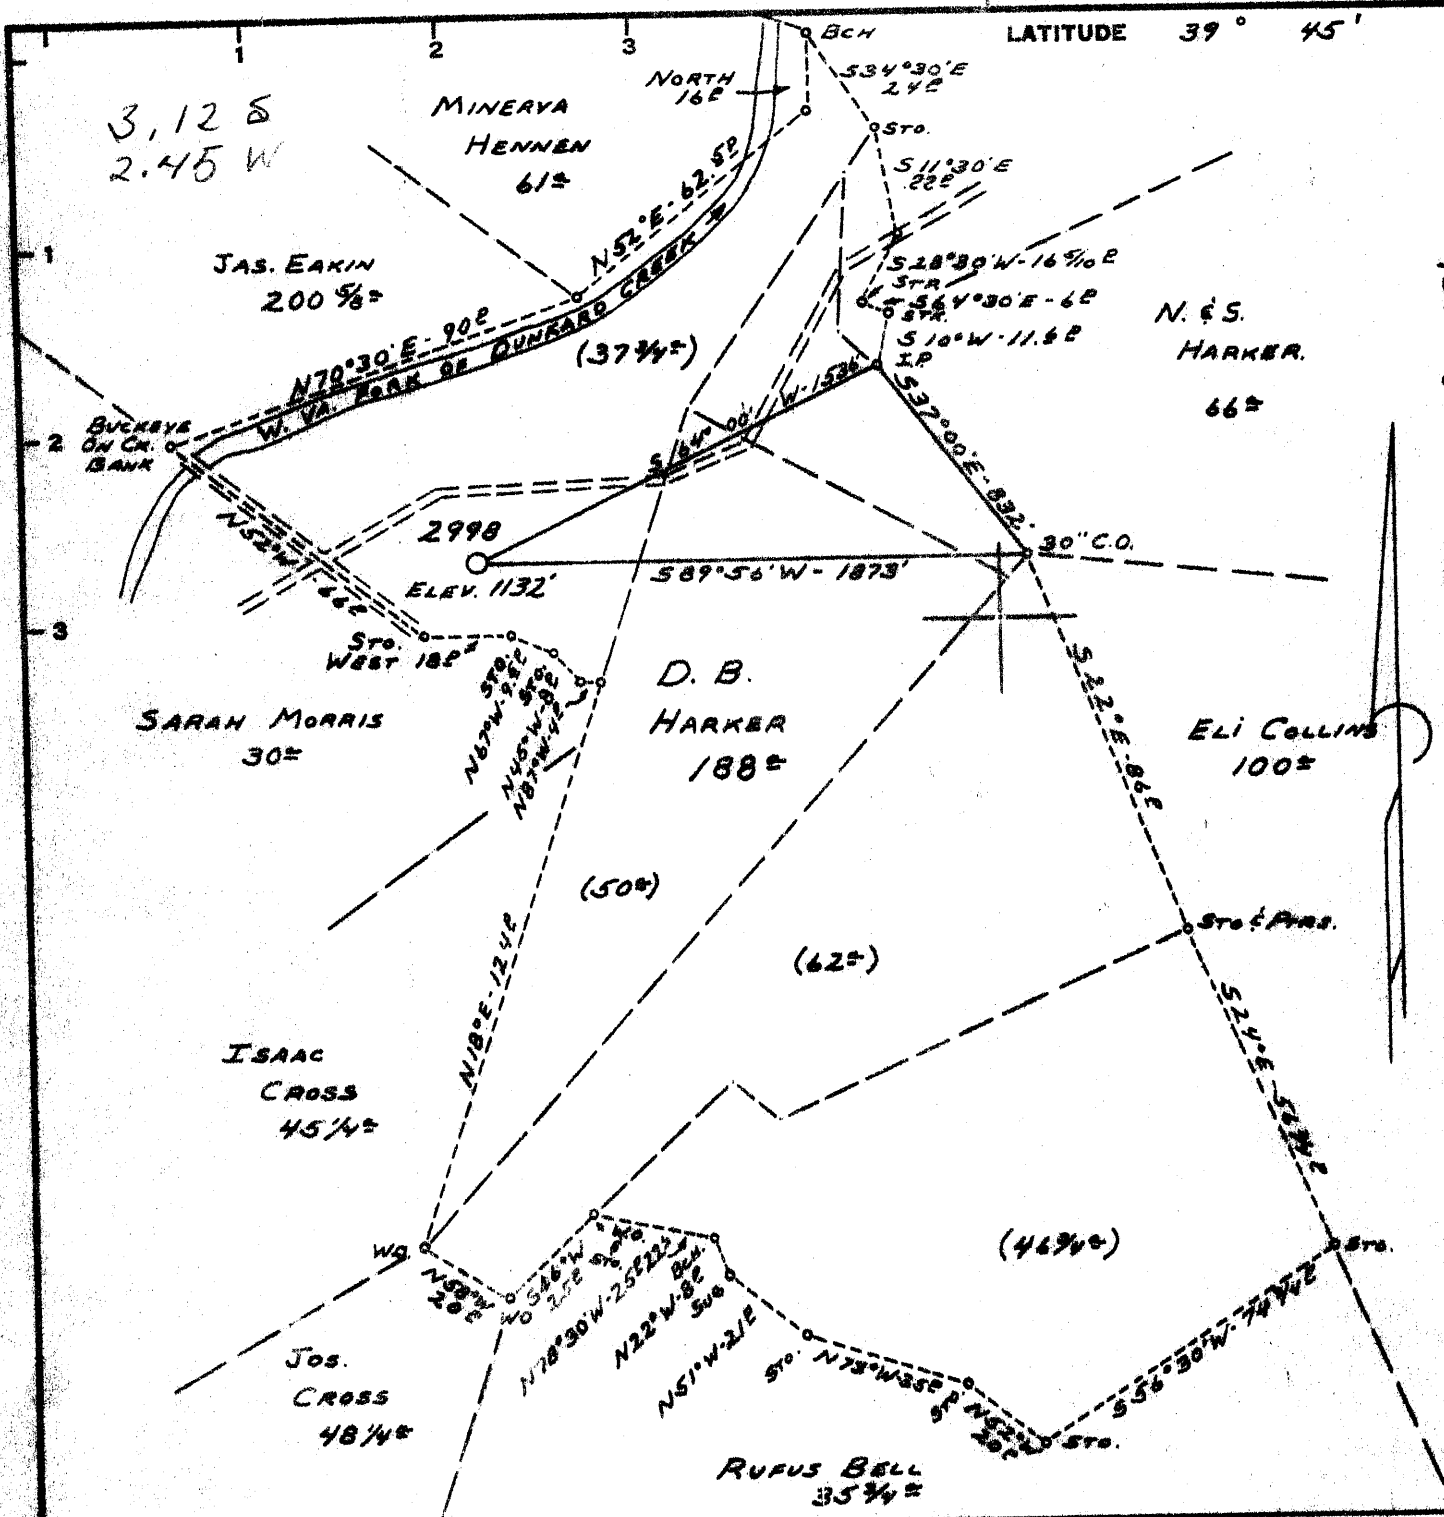

Minimum Error of Closure 1' IN 200'

Source of Elevation B.M. U.S.G.S. 1028 143-RPH-1957 WANA, W.Va.
ELEV. 1028.8'

"I, the undersigned, hereby certify that this map is correct to the best of my knowledge and belief and shows all the information required by paragraph 6 of the rules and regulations of the oil and gas section of the mining laws of West Virginia."

New Location.....
 Drill Deeper.....
 Abandonment.....

MAP SHEET 17 N-18 E-19 F.B. 1371 Pg. 20-21

Company CONSOLIDATED GAS SUPPLY CORP.
 Address CLARKSBURG, W. VA.
 Farm D. B. HARKER
 Tract _____ Acres 188± Lease No. 667
 Well (Farm) No. _____ Serial No. 2998
 Elevation (Spirit Level) 1132'
 Quadrangle MANNINGTON N.E.
 County MONONGALIA District BATTELLE
 Engineer Jackson M. Jarvis
 Engineer's Registration No. 2397
 File No. _____ Drawing No. _____
 Date 11-4-65 Scale 1" = 80±

STATE OF WEST VIRGINIA
 DEPARTMENT OF MINES
 OIL AND GAS DIVISION
 CHARLESTON

WELL LOCATION MAP
 FILE NO. MON-677-A

+ Denotes location of well on United States Topographic Maps, scale 1 to 62,500, latitude and longitude lines being represented by border lines as shown.

- Denotes one inch spaces on border line of original tracing.