


LATITUDE 39° 40'

LONGITUDE 80° 15'

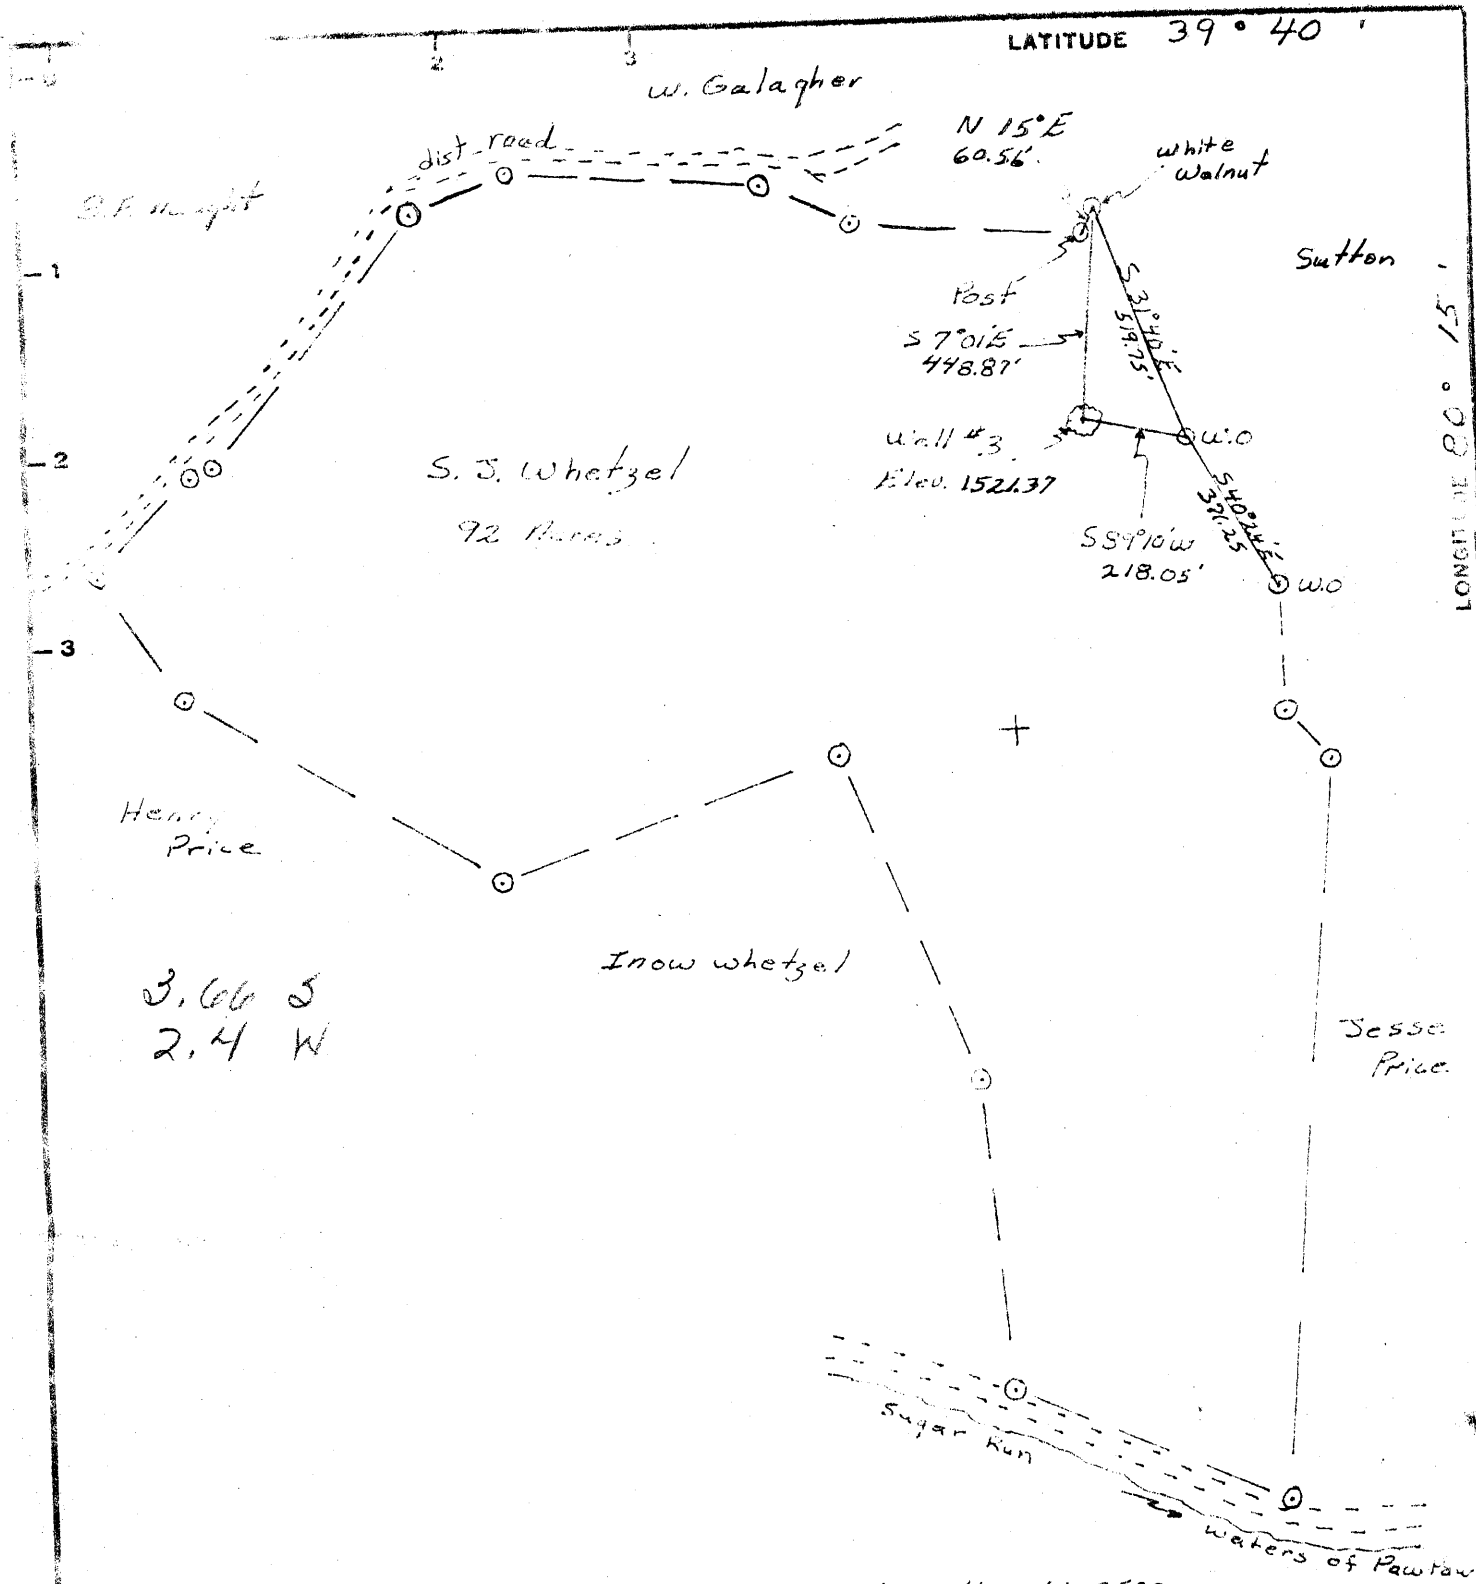

Minimum Error of Closure less than 1 in 2500

Source of Elevation U.S. B.M. 1452.4

I, the undersigned, hereby certify that this map is correct to the best of my knowledge and belief and shows all the information required by paragraph 6 of the rules and regulations of the oil and gas section of the mining laws of West Virginia.

- Fracture.....
- New Location.....
- Drill Deeper.....
- Abandonment..... 7-29-68

Signed: William P. Foley
 Squares: N S E W

Map No.

Company William Cassidy
 Address 4303 Whitford Drive, Vienna W.Va.
 Farm S. J. Whetzel
 Tract _____ Acres 92 Lease No. _____
 Well (Farm) No. #3 Serial No. _____
 Elevation (Spirit Level) 1521.37
 Quadrangle Mannington 6C
 County Menongalia District Bethelle
 Engineer William P. Foley
 Engineer's Registration No. 4449
 File No. _____ Drawing No. _____
 Date 5-23-68 Scale 1" = 400'

STATE OF WEST VIRGINIA
 DEPARTMENT OF MINES
 OIL AND GAS DIVISION
 CHARLESTON

WELL LOCATION MAP
 FILE NO. MON-685-A

+ Denotes location of well on United States Topographic Maps, scale 1 to 62,500; latitude and longitude lines being represented by border lines as shown.

- Denotes one inch spaces on border line of original tracing.

39°37'30"

Latitude



.73s
.23w

Longitude

Topo Location

7.5' Loc. _____ 15' Loc. _____
(calc.) _____

Company William Cassidy

Farm SJ Whetzel #3

15' Quad _____
(sec.)

7.5' Quad Mannington

District Battelle

WELL LOCATION PLAT

County 061 Permit 30685