


2.235  
1.54 W

Note: This well location plat made from South Penn 1" = 800' scale well map.

LONGITUDE 80° 15'

2.24 S  
1.54 W

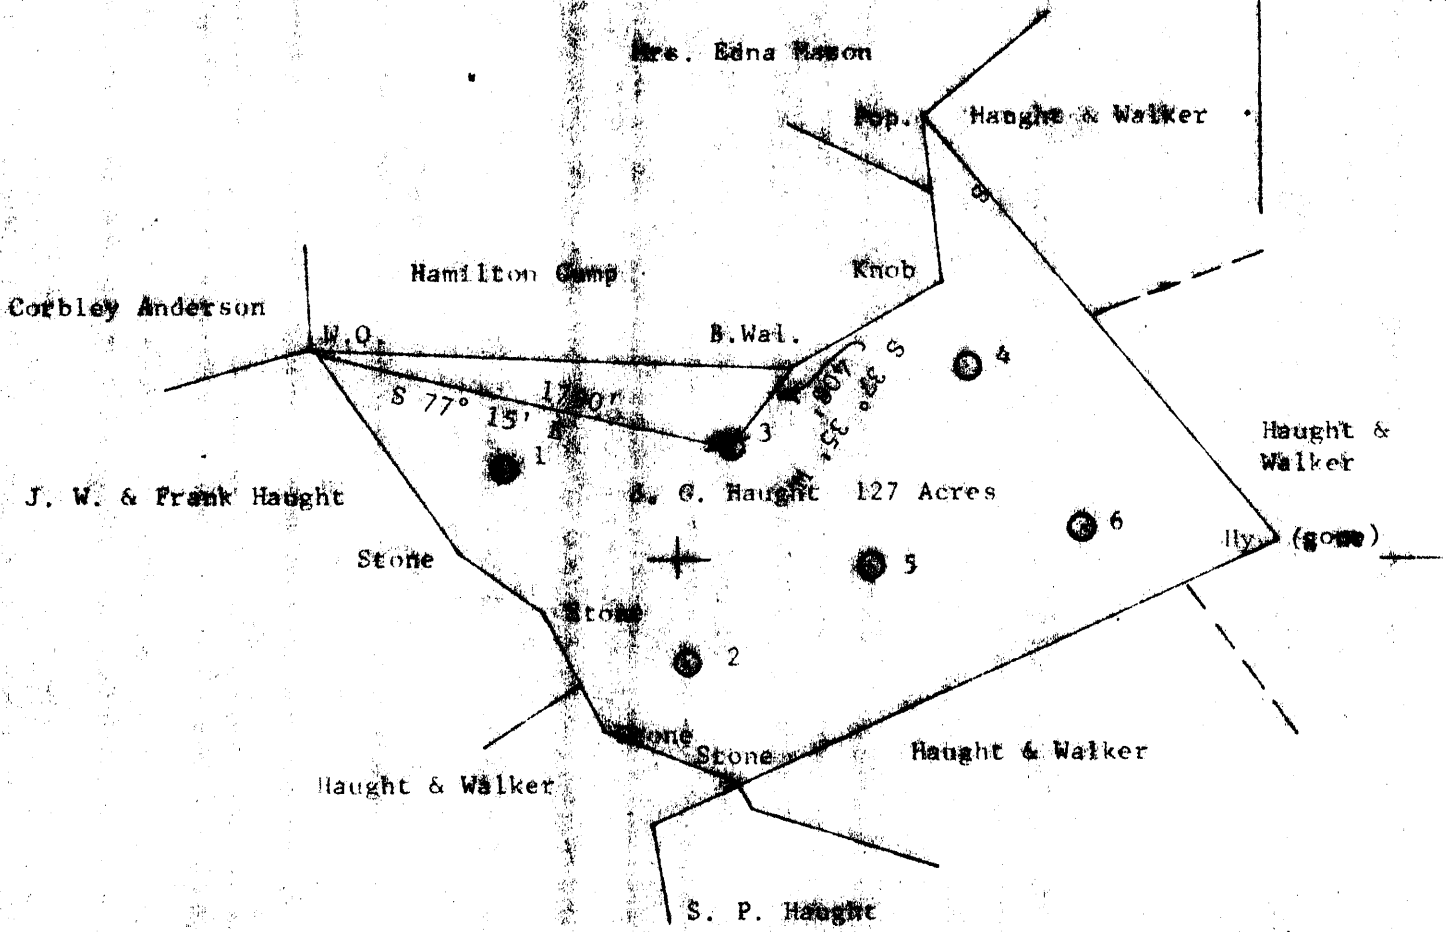

Minimum Error of Closure 1 in 200

Source of Elevation U. S. G. S. Monument

I, the undersigned, hereby certify that this map is correct to the best of my knowledge and belief and shows all the information required by paragraph 3 of the rules and regulations of the oil and gas section of the mining laws of West Virginia.

*B. J. McCormley*

Abandonment  issued 5-23-75

Company	Mountaineer Coal Company
Address	P.O. Box 1632 Fairmont, W. Va. 26554
Farm	J. G. Haught 127 Acres
Tract	Acres _____ Lease No. _____
Well (Farm) No.	Haught # 3 Serial No. _____
Elevation (Spirit Level)	1374.68 EC
Quadrangle	Wadestown 7.5' <u>Mannington</u>
County	Monongalia District Barreille
Engineer	B. J. McCormley
Registration No.	2067
File No.	_____ Drawing No. _____
Date	7/21/75 Scale 1" = 800'

STATE OF WEST VIRGINIA  
Department of Mines  
OIL AND GAS DIVISION  
CHARLESTON

FILE NO. Mon-707-A

+ Denotes location of well on United States Topographic Map, scale 1 to 24000, Latitude and Longitude lines being represented by border lines as shown.

**47-061**