


LATITUDE 39° 37' 30"

88888888

LONGITUDE

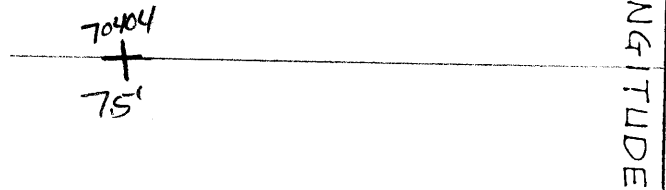

7'5 OGIS topo location

7.5' 10c	<u>1.80S</u>	15' 10c	<u>4.68S</u>
	<u>1.07W</u>	(calc.)	<u>1.07W</u>

316 in 1912 Co Rpt

Company _____

Farm _____

Quad Rivesville (Brels co)

County Monongalia

District Grant

WELL LOCATION MAP

File No. 001-70404