

west virginia department of environmental protection

Office of Oil and Gas 601 57th Street, S.E. Charleston, WV 25304 (304) 926-0450 fax: (304) 926-0452

Austin Caperton, Cabinet Secretary www.dep.wv.gov

Friday, August 24, 2018 WELL WORK PERMIT Horizontal 6A / New Drill

SWN PRODUCTION COMPANY, LLC POST OFFICE BOX 12359

SPRING, TX 773914954

Re: Permit approval for GLENN DIDRIKSEN OHI 410H 47-069-00285-00-00

This well work permit is evidence of permission granted to perform the specified well work at the location described on the attached pages and located on the attached plat, subject to the provisions of Chapter 22 of the West Virginia Code of 1931, as amended, and all rules and regulations promulgated thereunder, and to any additional specific conditions and provisions outlined in the pages attached hereto. Notification shall be given by the operator to the Oil and Gas Inspector at least 24 hours prior to the construction of roads, locations, and/or pits for any permitted work. In addition, the well operator shall notify the same inspector 24 hours before any actual well work is commenced and prior to running and cementing casing. Spills or emergency discharges must be promptly reported by the operator to 1-800-642-3074 and to the Oil and Gas Inspector.

Please be advised that form WR-35, Well Operators Report of Well Work is to be submitted to this office within 90 days of completion of permitted well work, as should form WR-34 Discharge Monitoring Report within 30 days of discharge of pits, if applicable. Failure to abide by all statutory and regulatory provisions governing all duties and operations hereunder may result in suspension or revocation of this permit and, in addition, may result in civil and/or criminal penalties being imposed upon the operators.

Per 35 CSR 4-5.2.g this permit will expire in two (2) years from the issue date unless permitted well work is commenced. If there are any questions, please feel free to contact me at (304) 926-0450.

James A. Martin

Chief

Operator's Well Number: GLENN DIDRIKSEN OHI 410H

Farm Name: GLEN DIDRIKSEN

U.S. WELL NUMBER: 47-069-00285-00-00

Horizontal 6A New Drill Date Issued: 8/24/2018

:

PERMIT CONDITIONS 4706900285

West Virginia Code § 22-6A-8(d) allows the Office of Oil and Gas to place specific conditions upon this permit. Permit conditions have the same effect as law. Failure to adhere to the specified permit conditions may result in enforcement action.

CONDITIONS

- This proposed activity may require permit coverage from the United States Army Corps of Engineers (USACE). Through this permit, you are hereby being advised to consult with USACE regarding this proposed activity.
- 2. If the operator encounters an unanticipated void, or an anticipated void at an unanticipated depth, the operator shall notify the inspector within 24 hours. Modifications to the casing program may be necessary to comply with W. Va. Code § 22-6A-5a (12), which requires drilling to a minimum depth of thirty feet below the bottom of the void, and installing a minimum of twenty (20) feet of casing. Under no circumstance should the operator drill more than one hundred (100) feet below the bottom of the void or install less than twenty (20) feet of casing below the bottom of the void.
- 3. When compacting fills, each lift before compaction shall not be more than 12 inches in height, and the moisture content of the fill material shall be within limits as determined by the Standard Proctor Density test of the actual soils used in specific engineered fill, ASTM D698, Standard Test Method for Laboratory Compaction Characteristics of Soil Using Standard Effort, to achieve 95 % compaction of the optimum density. Each lift shall be tested for compaction, with a minimum of two tests per lift per acre of fill. All test results shall be maintained on site and available for review.
- 4. Operator shall install signage per § 22-6A-8g (6) (B) at all source water locations included in their approved water management plan within 24 hours of water management plan activation.
- 5. Oil and gas water supply wells will be registered with the Office of Oil and Gas and all such wells will be constructed and plugged in accordance with the standards of the Bureau for Public Health set forth in its Legislative rule entitled *Water Well Regulations*, 64 C.S.R. 19. Operator is to contact the Bureau of Public Health regarding permit requirements. In lieu of plugging, the operator may transfer the well to the surface owner upon agreement of the parties. All drinking water wells within fifteen hundred feet of the water supply well shall be flow tested by the operator upon request of the drinking well owner prior to operating the water supply well.
- 6. Pursuant to the requirements pertaining to the sampling of domestic water supply wells/springs the operator shall, no later than thirty (30) days after receipt of analytical data provide a written copy to the Chief and any of the users who may have requested such analyses.
- 7. 24 hours prior to the initiation of the completion process the operator shall notify the Chief or his designee.
- 8. During the completion process the operator shall monitor annular pressures and report any anomaly noticed to the chief or his designee immediately.
- 9. If any explosion or other accident causing loss of life or serious personal injury occurs in or about a well or well work on a well, the well operator or its contractor shall give notice, stating the particulars of the explosion or accident, to the oil and gas inspector and the Chief, within 24 hours of said accident.
- 10. During the casing and cementing process, in the event cement does not return to the surface, the oil and gas inspector shall be notified within 24 hours.

API Number:	

PERMIT CONDITIONS 4706900285

11. The operator shall provide to the Office of Oil and Gas the dates of each of the following within 30 days of their occurrence: completion of construction of the well pad, commencement of drilling, cessation of drilling, completion of any other permitted well work, and completion of the well. Such notice shall be provided by sending an email to DEPOOGNotify@wv.gov.

API NO. 47-069 -						_
OPERATOR WELL	NO.	Gloon	Dick	SEER CH	1410H	_
Well Pad Name:	Glenn	Didri	csen (Pad		_
4706	s	0	0	2	8	5

STATE OF WEST VIRGINIA DEPARTMENT OF ENVIRONMENTAL PROTECTION, OFFICE OF OIL AND GAS WELL WORK PERMIT APPLICATION

1) Well Operator: SWN P	roduction Co., LLC	494512924	069-Ohio	Liberty	Valley Grove
		Operator ID	County	District	Quadrangle
2) Operator's Well Number	: Glenn Didriksen C	OHI 410H Well Pa	ad Name: Glen	n Didriksen	Pad
3) Farm Name/Surface Owr	ner: Glenn Didrikse	Public Ro	ad Access: Ba	ttle Run Ro	ad
4) Elevation, current ground	l: <u>1383'</u>	Elevation, proposed	d post-construct	ion: 1383'	
5) Well Type (a) Gas Other	X Oil _	Und	derground Stora	ıge	
(b)If Gas	Shallow X	Dеер			
6) Existing Pad: Yes or No	Horizontal X Yes			All	2 619.18
7) Proposed Target Formati Target Formation-Marcellus, T	on(s), Depth(s), Ant		and Expected I	Pressure(s):	
8) Proposed Total Vertical 1	Depth: 6548' at th	e toe (BHL deepe	est TVD)		
9) Formation at Total Vertic	A. 11				
10) Proposed Total Measure	ed Depth: 13,355	•			
11) Proposed Horizontal Le	eg Length: 6005.4	9'			
12) Approximate Fresh Wa	ter Strata Depths:	194'			· · · · · · · · · · · · · · · · · · ·
13) Method to Determine F	resh Water Depths:	Salinity Profile			
14) Approximate Saltwater	Depths: 1055' Sa	alinity Profile			
15) Approximate Coal Sear	n Depths: 653'				
16) Approximate Depth to	Possible Void (coal	mine, karst, other):	653' Possible	e Void	
17) Does Proposed well loo directly overlying or adjace		eams ? Yes	N	o X	
(a) If Yes, provide Mine I	nfo: Name:				
(a) It 100, provide famile i	Depth:				
	Seam:				
	Owner:				

RECEIVED Office of Oil and Gas

JUN 27 2018

Page 1 of 3

18)

CASING AND TUBING PROGRAM

TYPE	Size (in)	New or Used	Grade	Weight per ft. (lb/ft)	FOOTAGE: For Drilling (ft)	INTERVALS: Left in Well (ft)	CEMENT: Fill-up (Cu. Ft.)/CTS
Conductor	20"	New	H-40	94#	100'	100'	CTS
Fresh Water	13 3/8"	New	H-40	48#	730'	730'	679 sx/CTS
Coal	See	Surface Cooling			***************************************		
Intermediate	9 5/8"	New	J-55	36#	2034'	2034'	767 sx/CTS
Production	5 1/2"	New	HCP-110	20#	13,335'	13,335'	lead 601 to Tail that to 100 lead
Tubing							
Liners							

C. Ml 6.25.18

					1		
TYPE	Size (in)	Wellbore Diameter (in)	Wall Thickness (in)	Burst Pressure (psi)	Anticipated Max. Internal Pressure (psi)	Cement Type	Cement Yield (cu. ft./k)
Conductor	20"	30"	0.25	2120	81	Class A	1.19/50% Excess
Fresh Water	13 3/8"	17.5"	0.380	2740	633	Class A	1.19/50% Excess
Coal	See	Surface Casing					
Intermediate	9 5/8"	12 1/4"	0.395	3950	1768	Class A	1.19/50% Excess
Production	5 1/2"	8 3/4"	0.361	12360	9500	Class A	1.20/50% Excess
Tubing							
Liners							

PACKERS

Kind:		
Sizes:		
Depths Set:		

Page 2 of 3

RECEIVED Office of Oil and Gas

JUN 27 2018

WW-6B
(10/14)

API NO. 47	
OPERATOR WELL NO. Glenn Didriksen OHI 410	н
Well Pad Name: Glenn Didriksen Pad	
4706900285	:

19)	Describe p	proposed w	vell work,	including the	e drilling and	plugging	back of any	y pilot hole:
-----	------------	------------	------------	---------------	----------------	----------	-------------	---------------

Drill and stimulate any potential zones between and including the Benson to Marcellus. **If we should encounter a void place basket above and below void area- balance cement to bottom of void and grout from basket to surface or run external casing packer/cementing stage tool above void interval and perform 2 stage cementing operation dependent upon depth of void. Run casing not less than 20' below void nor more than 100' below void. (*If freshwater is encountered deeper than anticipated it must be protected, set casing a minimum of 50' below freshwater interval and cement to surface.)

20) Describe fracturing/stimulating methods in detail, including anticipated max pressure and max rate:

Well will be perforated within the target formation and stimulated with a slurry of water, sand, and chemical additives at a high rate. This will be performed in stages with the plug and perf method along the wellbore until the entire lateral has been stimulated within the target formation. All stage plugs are then drilled out and the well is flowed back to surface. The well is produced through surface facilities consisting of high pressure production unites, vertical separation units, water and oil storage tanks. Max press and anticipated max rate- 9000 lbs @ 100 barrels a minute.

- 21) Total Area to be disturbed, including roads, stockpile area, pits, etc., (acres): 9.01
- 22) Area to be disturbed for well pad only, less access road (acres): 5.79
- 23) Describe centralizer placement for each casing string:

All casing strings will be ran with a centralizer at a minimum of 1 per every 3 joints of casing.

24) Describe all cement additives associated with each cement type:

See Attachment ***

25) Proposed borehole conditioning procedures:

All boreholes will be conditioned with circulation and rotation for a minimum of one bottoms up and continuing until operator is satisfied with borehole conditions.

RECEIVED Office of Oil and Gas


JUN 27 2018

*Note: Attach additional sheets as needed.

Schlumberger Cement Additives

	Product Name	Product Use	Chemical Name	CAS Number
Surface	S001	accelerator	calcium chloride up to 3%	10043-52-4
Intermediate	5001	accelerator	calcium chloride	10043-52-4
4	D080	dispersant	sodium polynaphthalene sulfonate	9008-63-3
0 5	D801	retarder	aromatic polymer derivative	propriatary
Kick Off Plug	D047	antifoam	polypropylene glycol	25322-69-4
	D167	fluid loss	aliphatic amide polymer	propriatary
	D154	extender	non-crystalline silica	7631-86-9
	D400	gas migration	boric acid	10043-35-3
			polypropylene glycol	25322-69-4
ad	D046	antifoam	fullers earth (attapulgite)	8031-18-3
Production-Lead	T-T-		chrystalline silica	14808-60-7
E C	D201	retarder	metal oxide	propriatary
quo			sulphonated synthetic polymer	propriatary
Pro	D202	dispersant	formaldehyde (impurity)	propriatary
			polypropylene glycol	25322-69-4
	D046	antifoam	fullers earth (attapulgite)	8031-18-3
	D167	fluid loss	aliphatic amide polymer	propriatary
=		1	sodium polynaphthalene sulfonate	9008-63-3
7	D065	dispersant	sodium sulfate	7757-82-6
Production-Tall			chrystalline silica	14808-60-7
npo	D201	retarder	metal oxide	propriatary
Pro	D153	anti-settling	chrystalline silica	14808-60-7

RECEIVED Office of Oil and Gas

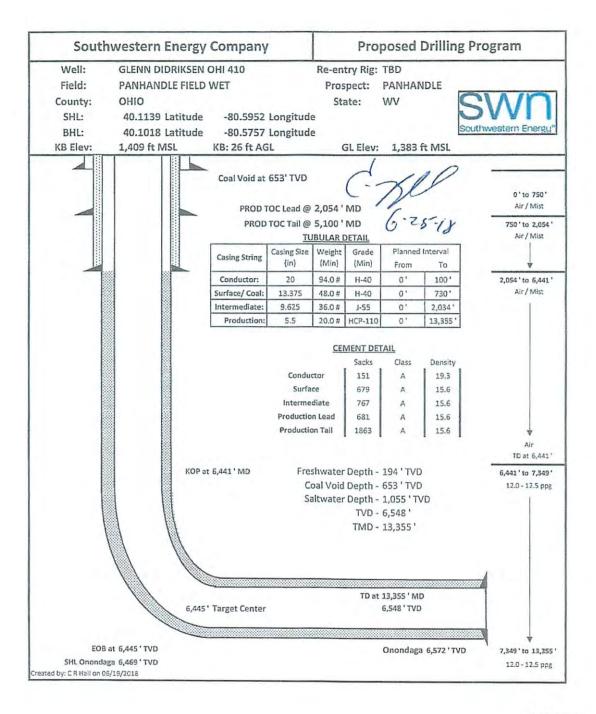

RECEIVED Office of Oil and Gas

JUN 27 2018

API	Operator	Status	Latitude	Longitude	Vertical TD	Producing Formation	Producing Zones Not Perforated
47-069-00019	SWN PRODUCTION COMPANY, LLC	ACTIVE	40.113912	-80.595067		Marcellus	
47-069-00188	SWN PRODUCTION COMPANY, LLC	ACTIVE	40.113944	-80.595039		Marcellus	
47-069-00189	SWN PRODUCTION COMPANY, LLC	ACTIVE	40.113976	-80.595012		Marcellus	
47-069-00191	SWN PRODUCTION COMPANY, LLC	ACTIVE	40.114046	-80.594953		Marcellus	
47-069-00064	SWN PRODUCTION COMPANY, LLC	ACTIVE	40.114071	-80.595018		Marcellus	
47-069-00123	SWN PRODUCTION COMPANY, LLC	ACTIVE	40.114065	-80.595112		Marcelus	

RECEIVED Office of Oil and Gas

JUN 2 7 2018

API Nu	mber 47 -		÷,,
	Operator	e Wall No	Glann Didrikson OHI 410H

STATE OF WEST VIRGINIA DEPARTMENT OF ENVIRONMENTAL PROTECTION OFFICE OF OIL AND GAS

4706 900285

FLUIDS/ CUTTINGS DISPOSAL & RECLAMATION PLAN

Operator Name SWN Production Co., LLC OP Code 494512924
Watershed (HUC 10) Upper Ohio South Quadrangle Valley Grove
Do you anticipate using more than 5,000 bbls of water to complete the proposed well work? Yes Vo
Will a pit be used? Yes No V
If so, please describe anticipated pit waste:
Will a synthetic liner be used in the pit? Yes No If so, what ml.?
Proposed Disposal Method For Treated Pit Wastes:
Land Application
Underground Injection (UIC Permit Number 34-155-22403, 34-059-24057, 34-119-28776, 34-167-23862, 34-155-23795, 34-121-23995, 34-155-21893) Reuse (at API Number at next anticipated well, API# will be included with the WR-34/DDMR &/or permit addendum.)
Off Site Disposal (Supply form WW-9 for disposal location) Other (Explain flow back fluids will be put in steel tanks and reused or taken to a permitted disposal facility
Will closed loop system be used? If so, describe: Yes
Drilling medium anticipated for this well (vertical and horizontal)? Air, freshwater, oil based, etc. Air drill to KOP, fluid drill with SOBM from KOP to TO
-If oil based, what type? Synthetic, petroleum, etc. Synthetic Oil Base
Additives to be used in drilling medium? Attachment 3A
Drill cuttings disposal method? Leave in pit, landfill, removed offsite, etc. landfill
-If left in pit and plan to solidify what medium will be used? (cement, lime, sawdust)
-Landfill or offsite name/permit number? Meadowfill SWF- 1032, Short Creek SWF-1034, Carbon Limestone MSWL018781, Wetzel County 1021 Arden Landfill 10072, Apex Sanitary Landfill 05-08438, Brooke Co SVVF-1013, Valley 100280
Permittee shall provide written notice to the Office of Oil and Gas of any load of drill cuttings or associated waste rejected at any West Virginia solid waste facility. The notice shall be provided within 24 hours of rejection and the permittee shall also disclose where it was properly disposed.
I certify that I understand and agree to the terms and conditions of the GENERAL WATER POLLUTION PERMIT issued on August 1, 2005, by the Office of Oil and Gas of the West Virginia Department of Environmental Protection. I understand that the provisions of the permit are enforceable by law. Violations of any term or condition of the general permit and/or other applicable law or regulation can lead to enforcement action. I certify under penalty of law that L have personally examined and am familiar with the information submitted on this application form and all attachments thereto and that, based on my inquiry of those individuals immediately responsible for obtaining the information, I believe that the information is true, accurate, and complete. I am aware that there are significant penalties for submitting false information, including the possibility of fine or imprisonment. Company Official Signature Company Official (Typed Name) Dee Southall Dee Southall Senior Regulatory Analyst
Subscribed and sworn before me this 315 day of 1000 , 20 8
Subscribed and sworth before the times of the day of the subscribed and sworth before the times of the day of the subscribed and sworth before the times of the day of the subscribed and sworth before the times of the day of the subscribed and sworth before the times of the day of the subscribed and sworth before the times of the day of the subscribed and sworth before the times of the day of the subscribed and sworth before the times of the subscribed and subscrib
My commission expires William Jun 2 7 2018
and the state of t

SWN Production Co., LLC	1 - 1 9 01	D	7069002
Proposed Revegetation Treatment: Acres Distu		Prevegetation pl	
Lime as determined by pH test min. 2 Tons/acre or	to correct to pH 3.79		
Fertilizer type 10-20-20			
Fertilizer amount 600	lbs/acre		
Mulch Hay/Straw 2.5	Tons/acre		
	Seed Mixtures		
Temporary		Perma	nent
Seed Type Ibs/acre Attachment 3B		Seed Type	lbs/acre
Attach: Drawing(s) of road, location, pit and proposed a provided) Photocopied section of involved 7.5' topographi		ess engineered plans in	cluding this info have been
Plan Approved by:	64-18		
Comments:			
_{Title:} Oil and Gas Inspector	Date:	6.4.18	
	Bute	0	

JUN 2 7 2018

Attachment 3A

Drilling Mediums

Surface/Coal(if present)/Freshwater Intervals:

Intermediate/Coal (if present):

Air

Brine (In Gas Storage areas)

Organophilic Bentonite

Production Hole:

Air

Synthetic Oil (Base Fluid for mud system)

Barite

Calcium Chloride

Lime

Organophilic Bentonite

Primary and Secondary Emulsifiers

Gilsonite

Calcium Carbonate

Friction Reducers

RECEIVED Office of Oil and Gas

JUN 2 7 2018



WVD Seeding Specification



To Order Seed contact Lyndsi Eddy Flippo office 570-996-4271 cell 501-269-5451 lyndsi_eddy@swn.com

50lbs per acre of Winter Wheat

(please allow 7 to 10 days for delivery)

NON-ORGANIC PROPERTIES	ION-ORGANIC PROPERTIES				
Seed Mixture: ROW Mix	SWI	N Supplied			
Orchardgrass	40%				
Timothy	15%				
Annual Ryegrass	15%				
Brown Top Millet	5%				
Red Top	5%				
Medium Red Clover	5%	All legumes are			
White Clover	5%	innoculated at 5x normal			
Birdsfoot Trefoil	5%	rate			
Rough Bluegrass	5%				
Apply @ 100lbs per acre April 16th- Oct. 14th	(Apply @ 200lbs per acre Oct. 15th- April 15th PLUS			

S	0	IL	A	VI	Eľ	ND	M	EI	V	rs	

10-20-20 Fertilizer *Apply @ 500lbs per Acre
Pelletized Lime Apply @ 2 Tons per Acre
*unless otherwise dictated by soil test results

Seeding Calculation Information:

1452' of 30' ROW/LOD is One Acre 871' of 50' ROW/LOD is One Acre 622' of 70' ROW/LOD is One Acre

Synopsis:

Every 622 linear feet in a 70' ROW/LOD, you should be using (2) 50lb bags of seed, (4) 50lb bags of fertilizer and (80) 50lb bags of Lime (2x seed in winter months + 50lb Winter Wheat/ac).

Special Considerations:

Landowner Special Considerations including CREP program participants require additional guidance that is not given here. Discuss these requirements with SWN supervision at the beginning of the project to allow time for special seed delivery.

SWN Supplied
50%
60%
60%
50%
Apply @ 200lbs per acre
Oct. 15th- April 15th
Pelletized Lime @ 2 Tons per Acre

Seed Mixture: Wetland Mix	SWN S	upplied	
VA Wild Ryegrass	20%		
Annual Ryegrass	20%		
Fowl Bluegrass	20%		
Cosmos 'Sensation'	10%	RECEIVED Office of Oil and G	as
Redtop	5%	Office of off and o	
Golden Tickseed	5%	JUN 2 7 2018	3
Maryland Senna	5%		4
Showy Tickseed	5%	WV Department Environmental Prote	of ection
Fox Sedge	2.5%	LITTE	C
Soft Rush	2.5%		0
Woolgrass	2.5%		0
Swamp Verbena	2.5%		0
Apply @ 25lbs per acre		Apply @ 50lbs per acre	0
April 16th- Oct. 14th		Oct. 15th- April 15th	N
NO FERTILIZER OR LI	ME INSIDE WET	LAND LIMITS	00

MARCELLUS WELL DRILLING PROCEDURES AND WELL SITE SAFETY PLAN



SWN Production Company, LLC 179 Innovation Drive Jane Lew, West Virginia 26378

API NO. 47-XXX-XXXXX
WELL NAME: Glenn Didriksen OHI 410H
Valley Grove QUAD
Liberty DISTRICT
Ohio COUNTY, WEST VIRGINIA


	,	AALOI AIIKOIIA
Submitted by: Dee Southall Title: Sk. Rogulating Auctor	_ Date:	_5/22/2018 roduction Co., LLC
Approvéd by: Title: Oil + Ga Inga	_ Date:	6.4.18
Approved by:		
	Date:	
Title:	_	


SWN PRODUCTION COMPANY, LLC - CONFIDENTIAL

Office of Oil and Gas

JUN 2 7 2018

WV Department of Environmental Protection

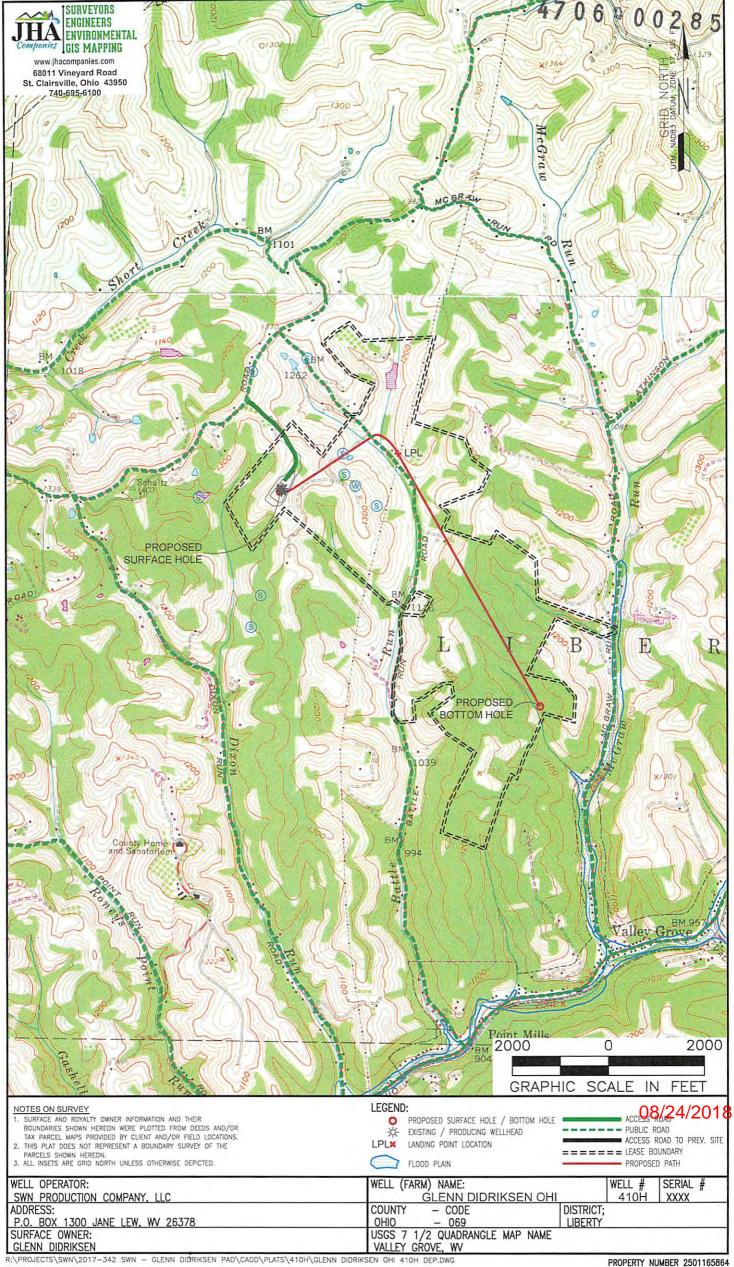

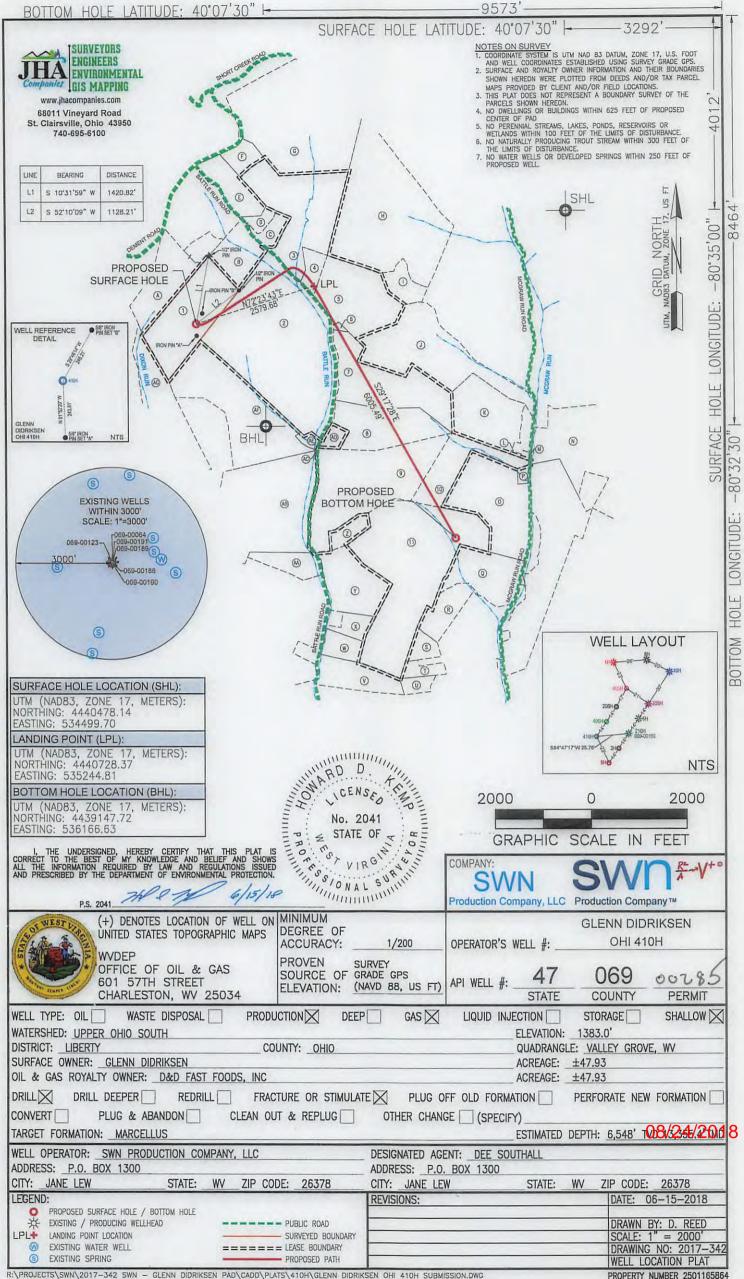

	WELL BORE TABLE FOR SURFACE / ROYALTY O	WNERS
TRACT	SURFACE OWNER (S) / ROYALTY OWNER (R)	TAX PARCEL
1	GLENN DIDRIKSEN (S) D&D FAST FOODS, INC (R)	03-L7-0042-0000
TRACT	SURFACE OWNER	TAX PARCEL
2	ROBERT WALTER LASCH AND DONNA LASCH (LE); BARBARA JO HINERMAN (RE)	03-L10-0040-0000
3	TUNNEL RIDGE LLC	03-L7-0045-0000
4	B. EILEEN GILMORE	03-L7-0046-0000
5	PAUL J ROBRECHT	03-L7-0047-0000
6	PAUL ROBRECHT	03-L10-0041-0002
7	FAYE J. TAGGART (LE); LINVILLE R. TAGGART (RE)	03-L10-0041-0000
8	WILLIAM H. TAGGART	03-L10-0041-0001
9	C. DWAINE AND LINDA J. BUTTS	03-L10-0043-0000
10	DAVID J. AND BETTY J. MILLER	03-L11-0008-0000
11	ERIC W. LYTTLE	03-L10-0049-0000

ACT	SURFACE OWNER	TAX PARCEL
A	GLENN DIDRICKSEN	03-L7-0037-0000
В	DENISE KNOUSE-SNYDER AND STEPHEN P. SNYDER	03-L7-0042-0001
С	TUNNEL RIDGE LLC	03-L7-0044-0000
D	MICHAEL A. AND STEPHANIE L. HOCKENBERRY	03-L7-0043-0000
E	MARY LOU HUDNALL	03-L7-0040-0000
F	KALEIGH J. PARSONS	03-L7-0041-0000
G	JAMES A. AND CAROL L. PARSONS	03-L7-0011-0000
Н	JOHN L., II, AND JOAN MARIE SMITH	03-L7-0048-0000
1	JOHN L. SMITH, II, AND DANIEL RAY GUTHOERL	03-L7-0048-0003
J	FAYE J TAGGART (LE) AND CHRISTINE J. TAGGART (RI)	03-L11-0003-0000
K	HOWARD G. TAYLOR AND DORA E. TAYLOR, TRUSTEES FOR THE HOWARD G. TAYLOR AND DORA E. TAYLOR IRREVOCABLE TRUST DATED OCTOBER 29, 2010	03-L11E-0021-0000
L	TONYA I. LEMASTERS	03-L11E-0024-0000
М	HOWARD J. BERTRAM	03-L11E-0001-0000
N	ALICE MAE EDGE	03-L11-0024-0000
0	MICHAEL D. & MELISSA JEAN VARGO	03-L11-0010-0000
P	SHARON L. EDGE	03-L11-0009-0000
Q	RYAN C. AND HEATHER R. BLAKELY	03-L11-0011-0000
R	EARL P. JR FARMER	03-L11-0017-0001
S	EARL JR & HEATHER NAVE FARMER	03-L11-0018-0000
T	JOANNE L. ROSE	03-L11-0018-0001
U	KATHRYN POMPEO WHALEN; MICHAEL J. POMPEO; JAMES P. POMPEO; RICHARD P. POMPEO AND JOSEPH D. POMPEO	03-L11N-0030-0000
٧	RODNEY A. DIERINGER AND CATHERINE A. EVANS	03-L10-0045-0001
W	MEGAN L. BEAVER	03-L10-0045-0000
X	MEGAN L. BEAVER	03-L10-0045-0003
Y	BETH A. MARTIN NELSON; MICHAEL W. MARTIN AND WILLIAM D. MARTIN	03-L10-0044-0000
Z	C. DWAINE AND LINDA J. BUTTS	03-L10-0043-0001
AA	HANK D. DAVIS AND NIKI L. EWING-DAVIS	03-L10-0037-0001
AB	J. MATTHEW AND JUDITH M. PADDEN	03-L10-0038-0000
AC	ROBERT WALTER AND DONNA LASCH (LE); LINDA JEAN STONE (RI)	03-L10-0038-0001
AD	RICHARD J. AND KAREN SUE SCOTT	03-L10-0042-0000
AE	RONALD M. & MARGO L. SCOTT	03-L10-0040-0001
AF	ROBERT WALTER AND DONNA LASCH (LE); LINDA JEAN STONE (RI)	03-L10-0039-0000
AG	MICHAEL R. AND KATHERINE A. PARSONS	03-L10-0035-0003

REVISIONS:	COMPANY:	SWN Production Company, LLC	S	tion Company™
	OPERATOR'S WELL #:	GLEN DIDE		DATE: 06-15-2018
		OHI 41		DRAWN BY: D. REED
	DISTRICT: LIBERTY	COUNTY: OHIO	STATE: WV	SCALE: N/A DRAWING NO: 2017-342 WELL LOCATION PLAT

INFORMATION SUPPLIED UNDER WEST VIRGINIA CODE Chapter 22, Article 6A, Section 5(a)(5)

4706900285

IN LIEU OF FILING LEASE(S) AND OTHER CONTINUING CONTRACT(S)

Under the oath required to make the verification on page 1 of this Notice and Application, I depose and say that I am the person who signed the Notice and Application for the Applicant, and that

- the tract of land is the same tract described in this Application, partly or wholly depicted in the accompanying plat, and described in the Construction and Reclamation Plan;
- (2) the parties and recordation data (if recorded) for lease(s) or other continuing contract(s) by which the Applicant claims the right to extract, produce or market the oil or gas are as follows:

Lease Name or Number

Grantor, Lessor, etc.

Grantee, Lessee, etc.

Royalty

Book/Page

See Exhibit

Acknowledgement of Possible Permitting/Approval In Addition to the Office of Oil and Gas

The permit applicant for the proposed well work addressed in this application hereby acknowledges the possibility of the need for permits and/or approvals from local, state, or federal entities in addition to the DEP, Office of Oil and Gas, including but not limited to the following:

- WV Division of Water and Waste Management
- WV Division of Natural Resources WV Division of Highways
- · U.S. Army Corps of Engineers
- U.S, Fish and Wildlife Service
- County Floodplain Coordinator

The applicant further acknowledges that any Office of Oil and Gas permit in no way overrides, replaces, or nullifies the need for other permits/approvals that may be necessary and further affirms that all needed permits/approvals should be acquired from the appropriate authority before the affected activity is initiated.

Well Operator: SWN Production Company, LLC.

By:

Its:

Landman

Page 1 of

Office of Oil and Gas

JUN 2 7 2018

EXHIBIT "A"

Attached to and made a part of the State of West Virginia Oil and Gas Permit Form, WW-6A1, by SWN Production Company, L.L.C., Operator
Glenn Didriksen OHI 410H
Ohio County, West Virginia

#	TMP	LEASE #	LESSOR	LESSEE	ROYALTY	BK/PG
1)	3-L7-42	725114-000	D&D Fast Food, Inc.	Chesapeake Appalachia, L.L.C.	12.50%	791/455
•				SWN Production Company, LLC		885/248
2)	3-L10-40	729271-000	Robert Walter & Donna Jean Lasch, H/W	Great Lakes Energy Partners, L.L.C.	15.50%	768/793
•						770/13
				Chesapeake Appalachia, L.L.C.		820/657
						820/665
				SWN Production Company, LLC		884/73
3)	3-L7-45	17-16271	Alliance Resource GP, LLC	SWN Production Company, L.L.C.	18.00%	927/384
4)	3-L7-46	734028-000	B. Eileen Gilmore, a/k/a B. Eileen Blake, a married woman	NPAR, LLC	18.00%	815/405
•			acting in her sole and separate property	Chevron U.S.A. Inc.		827/269
				Chesapeake Appalachia, L.L.C.		867/713
				SWN Production Company, LLC		883/742
5)	3-L7-47	733987-000	Paul J. Robrecht, a/k/a Paul Robrecht, and Kathy A.	NPAR, LLC	18.00%	816/503
			Robrecht, his wife	Chevron U.S.A. Inc.		827/299
				Chesapeake Appalachia, L.L.C.		867/713
				SWN Production Company, LLC		883/623
6)	3-L10-41.2	733987-000	Paul J. Robrecht, a/k/a Paul Robrecht, and Kathy A.	NPAR, LLC	18.00%	816/503
- •			Robrecht, his wife	Chevron U.S.A. Inc.		827/299
				Chesapeake Appalachia, L.L.C.		867/713
				SWN Production Company, LLC		883/623
7)	3-L10-41	734829-000	Faye J. Taggart, a widow	Chesapeake Appalachia, L.L.C.	18.00%	862/156
•				SWN Production Company, LLC		883/776

EXHIBIT "A"

Attached to and made a part of the State of West Virginia Oil and Gas Permit Form, WW-6A1, by SWN Production Company, L.L.C., Operator Glenn Didriksen OHI 410H

Ohio County, West Virginia

8)	3-L10-41.1	733986-000	William H. Taggart, a married man acting in his sole and	NPAR, LLC	18.00%	816/643
			separate property	Chevron U.S.A. Inc.		827/269
				Chesapeake Appalachia, L.L.C.		867/713
				SWN Production Company, LLC		883/623
9)	3-L10-43	729273-000	C. Dwaine Butts and Linda J. Butts, husband and wife	Great Lakes Energy Partners, L.L.C.	15.50%	766/543
ł				Chesapeake Appalachia, L.L.C.		820/657
				SWN Production Company, LLC		820/665
						884/73
10)	3-L11-8	724934-000	David J. Miller, a single man	Chesapeake Appalachia, L.L.C.	12.50%	790/233
				SWN Production Company, LLC		885/248
11	3-L10-49	733991-001	Eric W. Lyttle, a married man acting in his sole and separate	NPAR, LLC	18.00%	816/651
			property	Chevron U.S.A. Inc.		827/269
				Chesapeake Appalachia, L.L.C.		867/701
				SWN Production Company, LLC		883/623



SWN Production Company, LLC P O Box 12359 Spring, Texas 77391-2359 www.swn.com

4706900285

June 18, 2018

Ms. Laura Adkins WV DEP Office of Oil & Gas 601 57th St., SE Charleston, WV 25304

RE: SWN's proposed New Well: Glenn Didriksen OHI 410H in Ohio County, West Virginia, Drilling under Battle Run Road.

Dear Ms. Adkins:

SWN Production Company, LLC ("SWN") is applying for a drilling permit for the above referenced well. The State of West Virginia has raised some concern as to SWN's right to drill under Battle Run Road. Please be advised that SWN has leased all mineral owners under said route as it relates to the above-referenced well and unit.

Thank you.

Sincerely,

Bradley Wilson

Landman

SWN Production Company, LLC

PO Box 12359

Spring, TX 77391-2359

10000 Energy Drive Spring, TX 77389-4954 RZ-20V+"

The Right People doing the Right Things, wisely investing the cash flow from our underlying Assets, will create Value+¹⁰

Office of Oil and Gas

JUN 2 7 2018

WW Department of Environmental Protection

08/24/2018

Date of Notice Certification:

STATE OF WEST VIRGINIA DEPARTMENT OF ENVIRONMENTAL PROTECTION, OFFICE OF OIL AND GAS NOTICE CERTIFICATION

API No. 47-

Operator's Well No. Glenn Didriksen OHI 410H

		Well I	Pad Name: Glenn D	oldliksell Fad	
	been given:				
		§ 22-6A, the Operator has provided th	ne required parties v	with the Notice Forms listed	
State:	tract of land as follows:	Easting	g: 534500		
County:	069-Ohio	UTM NAD 83 Northi	0.		
District:	Liberty	Public Road Access:	Battle Run Road		
Quadrangle:	Valley Grove	Generally used farm nan			
Watershed:	Upper Ohio South		77		
prescribed by it has provid information r of giving the requirements Virginia Cod of this article	the secretary, shall be verified and ed the owners of the surface descrequired by subsections (b) and (c), so surface owner notice of entry to so of subsection (b), section sixteen (e) § 22-6A-11(b), the applicant shall have been completed by the applicant		n: (14) A certificati subsection (b), see the requirement was tion ten of this arti g by the surface over tary that the notice	on from the operator that (ction ten of this article, the deemed satisfied as a resu cle six-a; or (iii) the notice when; and Pursuant to We	
	West Virginia Code § 22-6A, the O erator has properly served the requir	perator has attached proof to this Noti	ice Certification		
	ECK ALL THAT APPLY	ed parties with the following:		OOG OFFICE USE ONLY	
				10000000	
☐ 1. NO	TICE OF SEISMIC ACTIVITY OF	NOTICE NOT REQUIRED BE SEISMIC ACTIVITY WAS CONI		RECEIVED/	
		(Alex (), [1] : "하다 가능하는 경영이 다양하다 됐다는 그리겠다.	DUCTED		
□ 2. NO		SEISMIC ACTIVITY WAS CONI	DUCTED AS CONDUCTED ECAUSE	NOT REQUIRED	
□ 2. NO	TICE OF ENTRY FOR PLAT SUR	SEISMIC ACTIVITY WAS COND VEY or NO PLAT SURVEY WA NOTICE NOT REQUIRED BE NOTICE OF ENTRY FOR PLATS	OUCTED AS CONDUCTED ECAUSE SURVEY	NOT REQUIRED RECEIVED	
□ 2. NO ■ 3. NO	TICE OF ENTRY FOR PLAT SUR	SEISMIC ACTIVITY WAS CONDUCTED OF ENTRY FOR PLATS WAS CONDUCTED OF WRITTEN WAIVER BY SUITE OF ENTRY BY SUITE OF WAS CONDUCTED OF	OUCTED AS CONDUCTED ECAUSE SURVEY	NOT REQUIRED RECEIVED RECEIVED	
□ 2. NO ■ 3. NO ■ 4. NO	TICE OF ENTRY FOR PLAT SUR TICE OF INTENT TO DRILL or	SEISMIC ACTIVITY WAS CONDUCTED OF ENTRY FOR PLATS WAS CONDUCTED OF WRITTEN WAIVER BY SUITE OF ENTRY BY SUITE OF WAS CONDUCTED OF	OUCTED AS CONDUCTED ECAUSE SURVEY	NOT REQUIRED RECEIVED RECEIVED NOT REQUIRED	

Required Attachments:

The Operator shall attach to this Notice Certification Form all Notice Forms and Certifications of Notice that have been provided to the required parties and/or any associated written waivers. For the Public Notice, the operator shall attach a copy of the Class II Legal Advertisement with publication date verification or the associated Affidavit of Publication. The attached Notice Forms and Certifications of Notice shall serve as proof that the required parties have been noticed as required under West Virginia Code § 22-6A. Pursuant to West Virginia Code § 22-6A-11(b), the Certification of Notice to the person may be made by affidavit of personal service, the return receipt card or other postal receipt for certified mailing.

RECEIVED Office of Oil and Gas

Certification of Notice is hereby given:

THEREFORE, I , have read and understand the notice requirements within West Virginia Code § 22-6A. I certify that as required under West Virginia Code § 22-6A, I have served the attached copies of the Notice Forms, identified above, to the required parties through personal service, by registered mail or by any method of delivery that requires a receipt or signature confirmation. I certify under penalty of law that I have personally examined and am familiar with the information submitted in this Notice Certification and all attachments, and that based on my inquiry of those individuals immediately responsible for obtaining the information, I believe that the information is true, accurate and complete. I am aware that there are significant penalties for submitting false information, including the possibility of fine and imprisonment.

Address:

Well Operator:

By:
Dee Southall

Its:
Senior Regulatory Analyst
Telephone:
304-884-1610

Senior Regulatory Analyst Facsimile: 304-884-1690
304-884-1610 Email: Dee_Southall@swn.com

NOTARY ISEAL

Notary Public. State of West Virginia

BRITTANY R WOODY

3392 Old Elkins Road

Euckhannon. WV 26201

My commission expires November 27, 2022

Subscribed and sworn before me this 315+ day of 1015

My Commission Expires 1179

P.O. Box 1300

Jane Lew, WV 26378

Oil and Gas Privacy Notice:

The Office of Oil and Gas processes your personal information, such as name, address and telephone number, as part of our regulatory duties. Your personal information may be disclosed to other State agencies or third parties in the normal course of business or as needed to comply with statutory or regulatory requirements, including Freedom of Information Act requests. Our office will appropriately secure your personal information. If you have any questions about our use or your personal information, please contact DEP's Chief Privacy Officer at deprivacyofficer@wv.gov.

Office of Oil and Gas

Notary Public

JUN 2 7 2018

WW-6A (9-13) API NO. 47-4 7 0 6 9 0 0 2 8 5

OPERATOR WELL NO. Glenn Didriksen OHI 410H

Well Pad Name: Glenn Didriksen Pad

STATE OF WEST VIRGINIA DEPARTMENT OF ENVIRONMENTAL PROTECTION, OFFICE OF OIL AND GAS NOTICE OF APPLICATION

Notice Time Requ	uirement: notice shall be prov	vided no later that	n the filing date of permit application.	
	Date Permit Applic	ation Filed: 🔱	un 168	
Notice of:	X.			
✓ PERMIT FO	D ANY D CERTIE	CATE OF ADD	ROVAL FOR THE	
WELL WOR	RK CONST	RUCTION OF A	AN IMPOUNDMENT OR PIT	
Delivery method	pursuant to West Virginia C	Code § 22-6A-10	(b)	
☐ PERSONAL	✓ REGISTERED	☐ METHO	OD OF DELIVERY THAT REQUIRES A	
SERVICE	MAIL		PT OR SIGNATURE CONFIRMATION	
registered mail or be sediment control ple the surface of the troil and gas leaseho described in the erroperator or lessee, more coal seams; (a well work, if the su impoundment or picture have a water well, sprovide water for comproposed well work subsection (b) of the records of the sheriprovision of this ar Code R. § 35-8-5.7	by any method of delivery that re- lan required by section seven of ract on which the well is or is pro- land being developed by the propo- posion and sediment control plan in the event the tract of land on 4) The owners of record of the surface tract is to be used for the it as described in section nine of spring or water supply source loonsumption by humans or dome activity is to take place. (c)(1) his section hold interests in the later of the section of the surface to the contrary, notice to a section of the section of the section hold interests in the later of the section has a section hold interest of the section has a section h	equires a receipt of this article, and the roposed to be local osed well work, if submitted pursual which the well proposed tract or tracplacement, construct from the article; (5) A reated within one testic animals; and If more than three ands, the applican resuant to section elien holder is not received.	as required by this article shall deliver, by person r signature confirmation, copies of the application well plat to each of the following persons: (1) Ted; (2) The owners of record of the surface tract of the surface tract is to be used for roads or other laint to subsection (c), section seven of this article; (coposed to be drilled is located [sic] is known to be cets overlying the oil and gas leasehold being develoution, enlargement, alteration, repair, removal or my surface owner or water purveyor who is known thousand five hundred feet of the center of the well (6) The operator of any natural gas storage field we tenants in common or other co-owners of interest may serve the documents required upon the persight, article one, chapter eleven-a of this code. (2) notice to a landowner, unless the lien holder is the ovide the Well Site Safety Plan ("WSSP") to the sas provided in section 15 of this rule.	the erosion and the owners of record of or tracts overlying the and disturbance as the coal owner, and the coal owner, and the coal owner oped by the proposed abandonment of any to the applicant to all pad which is used to within which the test described in the Notwithstanding any clandowner. W. Va.
☐ Application No	otice 🛮 WSSP Notice 🖾 E	&S Plan Notice	☑ Well Plat Notice is hereby provided to:	
SURFACE OW				RECEIVED
Name: Glenn Didrikse			☑ COAL OWNER OR LESSEE Name: Alliance Resources GP, LLC	Office of Oil and Gas
Address: 200 Didriks		-	Address: 2596 Battle Run Road	UNI 0 77 0010
Triadelphia, WV 26059	isi Di.	-	Triadelhpia, WV 26059	JUN 2 7 2018
Name:		-		
Addison		-	COAL OPERATOR	WV Department of Environmental Protection
Address:		_	Name:	
T SUDEACE OW	NER(s) (Road and/or Other D	i atuulta u aa l	Address:	
			ECLIDEA OF ONDIED OF WATER WELL	
Address.		_	SURFACE OWNER OF WATER WELL	
			AND/OR WATER PURVEYOR(s)	
M		_	Name: See Attachment	
Name:		_	Address:	
Address:		_	TORES LEGO OF AN ELECTRIC CO.	00 / 00 PM: 5
= CLIDE LOR OUT	NIED/AVI		OPERATOR OF ANY NATURAL GAS ST	
LI SUKFACE OW	NER(s) (Impoundments or Pit	S)	Name:	
Name:		_	Address:	
Address:		-		
			*Please attach additional forms if necessary	

RECEIVED

JUN 2 7 2018

WV Department of Environmental Protection 4706900285

API NO. 47-OPERATOR WELL NO. Glenn Didriksen OHI 410H Well Pad Name: Glenn Didriksen Pad

Notice is hereby given:

WW-6A

(8-13)

Pursuant to West Virginia Code § 22-6A-10(b), notice is hereby given that the undersigned well operator has applied for a permit for well work or for a certificate of approval for the construction of an impoundment or pit.

This Notice Shall Include:

Pursuant to W. Va. Code § 22-6A-10(b), this notice shall include: (1) copies of the application; (2) the erosion and sediment control plan required by section seven of this article; and (3) the well plat.

Pursuant to W. Va. Code § 22-6A-10(f), this notice shall include: (1) a statement of the time limits for filing written comments; (2) who may file written comments; (3) the name and address of the secretary for the purpose of filing the comments and obtaining additional information; and (4) a statement that the persons may request, at the time of submitting written comments, notice of the permit decision and a list of persons qualified to test water.

Pursuant to W. Va. Code R. § 35-8-5.7.a, the operator shall provide the Well Site Safety Plan to the surface owner and any water purveyor or surface owner subject to notice and water testing as provided in section 15 of this rule.

Pursuant to W. Va. Code R. § 35-8-15.2.c, this notice shall: (1) contain a statement of the surface owner's and water purveyor's right to request sampling and analysis; (2) advise the surface owner and water purveyor of the rebuttable presumption for contamination or deprivation of a fresh water source or supply; advise the surface owner and water purveyor that refusal to allow the operator to conduct a pre-drilling water well test constitutes a method to rebut the presumption of liability; (3) advise the surface owner and water purveyor of his or her independent right to sample and analyze any water supply at his or her own expense; advise the surface owner and water purveyor whether or not the operator will utilize an independent laboratory to analyze any sample; and (4) advise the surface owner and or water purveyor that he or she can obtain from the Chief a list of water testing laboratories in the subject area capable of and qualified to test water supplies in accordance with standard acceptable methods.

Additional information related to horizontal drilling may be obtained from the Secretary, at the WV Department of Environmental Protection headquarters, located at 601 57th Street, SE, Charleston, WV 25304 (304-926-0450) or by visiting www.dep.wv.gov/oiland-gas/pages/default.aspx.

Well Location Restrictions

Pursuant to W. Va. Code § 22-6A-12, Wells may not be drilled within two hundred fifty feet measured horizontally from any existing water well or developed spring used for human or domestic animal consumption. The center of well pads may not be located within six hundred twenty-five feet of an occupied dwelling structure, or a building two thousand five hundred square feet or larger used to house or shelter dairy cattle or poultry husbandry. This limitation is applicable to those wells, developed springs, dwellings or agricultural buildings that existed on the date a notice to the surface owner of planned entry for surveying or staking as provided in section ten of this article or a notice of intent to drill a horizontal well as provided in subsection (b), section sixteen of this article was provided, whichever occurs first, and to any dwelling under construction prior to that date. This limitation may be waived by written consent of the surface owner transmitted to the department and recorded in the real property records maintained by the clerk of the county commission for the county in which such property is located. Furthermore, the well operator may be granted a variance by the secretary from these distance restrictions upon submission of a plan which identifies the sufficient measures, facilities or practices to be employed during well site construction, drilling and operations. The variance, if granted, shall include terms and conditions the department requires to ensure the safety and protection of affected persons and property. The terms and conditions may include insurance, bonding and indemnification, as well as technical requirements. (b) No well pad may be prepared or well drilled within one hundred feet measured horizontally from any perennial stream, natural or artificial lake, pond or reservoir, or a wetland, or within three hundred feet of a naturally reproducing trout stream. No well pad may be located within one thousand feet of a surface or ground water intake of a public water supply. The distance from the public water supply as identified by the department shall be measured as follows: (1) For a surface water intake on a lake or reservoir, the distance shall be measured from the boundary of the lake or reservoir. (2) For a surface water intake on a flowing stream, the distance shall be measured from a semicircular radius extending upstream of the surface water intake. (3) For a groundwater source, the distance shall be measured from the wellhead or spring. The department may, in its discretion, waive these distance restrictions upon submission of a plan identifying sufficient measures, facilities or practices to be employed during well site construction, drilling and operations to protect the waters of the state. A waiver, if granted, shall impose any permit conditions as the secretary considers necessary. (c) Notwithstanding the foregoing provisions of this section, nothing contained in this section prevents an operator from conducting the activities permitted or authorized by a Clean Water Act Section 404 permit or other approval from the United States Army Corps of Engineers within any waters of the state or within the restricted areas referenced in this section. (d) The well location restrictions set forth in this section shall not apply to any well on a multiple well pad if at least one of the wells was permitted prior to the effective date of this article. (e) The secretary shall, by December 31, 2012, report to the Legislature on the noise, light, dust and volatile organic compounds generated by the drilling of horizontal wells as they relate to the well location restrictions regarding occupied dwelling structures pursuant to this section. Upon a finding, if any, by the secretary that the well location restrictions regarding occupied dwelling structures are inadequate or otherwise require alteration to address the items

WW-6A (8-13) API NO. 47-4706900285

OPERATOR WELL NO. Glonn Didriksen OHI 410H
Well Pad Name: Glenn Didriksen Pad

examined in the study required by this subsection, the secretary shall have the authority to propose for promulgation legislative rules establishing guidelines and procedures regarding reasonable levels of noise, light, dust and volatile organic compounds relating to drilling horizontal wells, including reasonable means of mitigating such factors, if necessary.

Water Well Testing:

Pursuant to West Virginia Code § 22-6A-10(d), notification shall be made, with respect to surface landowners identified in subsection (b) or water purveyors identified in subdivision (5), subsection (b) of this section, of the opportunity for testing their water well. The operator shall provide an analysis to such surface landowner or water purveyor at their request.

Water Testing Laboratories:

Pursuant to West Virginia Code § 22-6A-10(i), persons entitled to notice pursuant to subsection (b) of this section may contact the department to ascertain the names and locations of water testing laboratories in the subject area capable and qualified to test water supplies in accordance with standard accepted methods. In compiling that list of names the department shall consult with the state Bureau for Public Health and local health departments. A surface owner and water purveyor has an independent right to sample and analyze any water supply at his or her own expense. The laboratory utilized by the operator shall be approved by the agency as being certified and capable of performing sample analyses in accordance with this section.

Rebuttable Presumption for Contamination or Deprivation of a Fresh Water Source or Supply:

W. Va. Code § 22-6A-18 requires that (b) unless rebutted by one of the defenses established in subsection (c) of this section, in any action for contamination or deprivation of a fresh water source or supply within one thousand five hundred feet of the center of the well pad for horizontal well, there is a rebuttable presumption that the drilling and the oil or gas well or either was the proximate cause of the contamination or deprivation of the fresh water source or supply. (c) In order to rebut the presumption of liability established in subsection (b) of this section, the operator must prove by a preponderance of the evidence one of the following defenses: (1) The pollution existed prior to the drilling or alteration activity as determined by a predrilling or prealteration water well test. (2) The landowner or water purveyor refused to allow the operator access to the property to conduct a predrilling or prealteration water well test. (3) The water supply is not within one thousand five hundred feet of the well. (4) The pollution occurred more than six months after completion of drilling or alteration activities. (5) The pollution occurred as the result of some cause other than the drilling or alteration activity. (d) Any operator electing to preserve its defenses under subdivision (1), subsection (c) of this section shall retain the services of an independent certified laboratory to conduct the predrilling or prealteration water well test. A copy of the results of the test shall be submitted to the department and the surface owner or water purveyor in a manner prescribed by the secretary. (e) Any operator shall replace the water supply of an owner of interest in real property who obtains all or part of that owner's supply of water for domestic, agricultural, industrial or other legitimate use from an underground or surface source with a comparable water supply where the secretary determines that the water supply has been affected by contamination, diminution or interruption proximately caused by the oil or gas operation, unless waived in writing by that owner. (f) The secretary may order the operator conducting the oil or gas operation to: (1) Provide an emergency drinking water supply within twenty-four hours; (2) Provide temporary water supply within seventy-two hours; (3) Within thirty days begin activities to establish a permanent water supply or submit a proposal to the secretary outlining the measures and timetables to be used in establishing a permanent supply. The total time in providing a permanent water supply may not exceed two years. If the operator demonstrates that providing a permanent replacement water supply cannot be completed within two years, the secretary may extend the time frame on case-by-case basis; and (4) Pay all reasonable costs incurred by the real property owner in securing a water supply. (g) A person as described in subsection (b) of this section aggrieved under the provisions of subsections (b), (e) or (f) of this section may seek relief in court... (i) Notwithstanding the denial of the operator of responsibility for the damage to the real property owner's water supply or the status of any appeal on determination of liability for the damage to the real property owner's water supply, the operator may not discontinue providing the required water service until authorized to do so by the secretary or a court of competent jurisdiction.

Written Comment:

Pursuant to West Virginia Code § 22-6A-11(a), all persons described in subsection (b), section ten of this article may file written comments with the secretary as to the location or construction of the applicant's proposed well work within thirty days after the application is filed with the secretary. All persons described in West Virginia Code § 22-6A-10(b) may file written comments as to the location or construction of the applicant's proposed well work to the Secretary at:

RECEIVED

Office of Oil and Gas

Chief, Office of Oil and Gas
Department of Environmental Protection
601 57th St. SE
Charleston, WV 25304
(304) 926-0450

JUN 2 7 2018

WV Department of Environmental Protection

Such persons may request, at the time of submitting written comments, notice of the permit decision and a list of persons qualified to test water. NOTE: YOU ARE NOT REQUIRED TO FILE ANY COMMENT.

WW-6A (8-13) API NO. 47-4706900285

OPERATOR WELL NO. Glenn Didriksen OHI 410H

OPERATOR WELL NO. Glenn Didriksen OHI 410H
Well Pad Name: Glenn Didriksen Pad

Time Limits and Methods for Filing Comments.

The law requires these materials to be served on or before the date the operator files its Application. You have THIRTY (30) DAYS after the filing date to file your comments. Comments must be filed in person or received in the mail by the Chief's office by the time stated above. You may call the Chief's office to be sure of the date. Check with your postmaster to ensure adequate delivery time or to arrange special expedited handling. If you have been contacted by the well operator and you have signed a "voluntary statement of no objection" to the planned work described in these materials, then the permit may be issued at any time.

Pursuant to West Virginia Code § 22-6A-11(c)(2), Any objections of the affected coal operators and coal seam owners and lessees shall be addressed through the processes and procedures that exist under sections fifteen, seventeen and forty, article six of this chapter, as applicable and as incorporated into this article by section five of this article. The written comments filed by the parties entitled to notice under subdivisions (1), (2), (4), (5) and (6), subsection (b), section ten of this article shall be considered by the secretary in the permit issuance process, but the parties are not entitled to participate in the processes and proceedings that exist under sections fifteen, seventeen or forty, article six of this chapter, as applicable and as incorporated into this article by section five of this article.

Comment Requirements

Your comments must be in writing and include your name, address and telephone number, the well operator's name and well number and the approximate location of the proposed well site including district and county from the application. You may add other documents, such as sketches, maps or photographs to support your comments.

Disclaimer: All comments received will be placed on our web site http://www.dep.wv.gov/oil-and-gas/Horizontal-Permits/Pages/default.aspx and the applicant will automatically be forwarded an email notice that such comments have been submitted. The applicant will be expected to provide a response to comments submitted by any surface owner, water purveyor or natural gas storage operator noticed within the application.

Permit Denial or Condition

The Chief has the power to deny or condition a well work permit. Pursuant to West Virginia Code § 22-6A-8(d), the permit may not be issued or be conditioned, including conditions with respect to the location of the well and access roads prior to issuance if the director determines that:

- (1) The proposed well work will constitute a hazard to the safety of persons;
- (2) The plan for soil erosion and sediment control is not adequate or effective;
- (3) Damage would occur to publicly owned lands or resources; or
- (4) The proposed well work fails to protect fresh water sources or supplies.

A permit may also be denied under West Virginia Code § 22-6A-7(k), the secretary shall deny the issuance of a permit if the secretary determines that the applicant has committed a substantial violation of a previously issued permit for a horizontal well, including the applicable erosion and sediment control plan associated with the previously issued permit, or a substantial violation of one or more of the rules promulgated under this article, and in each instance has failed to abate or seek review of the violation within the time prescribed by the secretary pursuant to the provisions of subdivisions (1) and (2), subsection (a), section five of this article and the rules promulgated hereunder, which time may not be unreasonable.

Pursuant to West Virginia Code § 22-6A-10(g), any person entitled to submit written comments to the secretary pursuant to subsection (a), section eleven of this article, shall also be entitled to receive from the secretary a copy of the permit as issued or a copy of the order modifying or denying the permit if the person requests receipt of them as a part of the written comments submitted concerning the permit application. Such persons may request, at the time of submitting written comments, notice of the permit decision and a list of persons qualified to test water.

RECEIVED Office of Oil and Gas

JUN 2 7 2018

API NO, 47OPERATOR WELL NO, Glenn Didriksen OHI 410H
WILL RAD Game: Glenn Didriksen Fact

Notice is hereby given by:

Well Operator: SWN Production Co., LLC

Telephone: 304-884-1610 Email: Dee_Southall@swn.com Address: P.O. Box 1300 Jane Lew, WV 26378

Facsimile: 304-884-1690

Oil and Gas Privacy Notice:

The Office of Oil and Gas processes your personal information, such as name, address and telephone number, as part of our regulatory duties. Your personal information may be disclosed to other State agencies or third parties in the normal course of business or as needed to comply with statutory or regulatory requirements, including Freedom of Information Act requests. Our office will appropriately secure your personal information. If you have any questions about our use or your personal information, please contact DEP's Chief Privacy Officer at depprivacyofficer@wv.gov.



Subscribed and sworn before me this

_ day of _

Notary Public

My Commission Expires

Office of Oil and Gas


JUN 27 2018

GLEN DIDRIKSEN PAD WATER SOURCES ATTACHMENT 13


PARCEL_ID	OWNER	ADDRESS	CITY_STATE_ZIP	WATERSOURCES
03 L10004000000000	LASCH ROBT W & DONNA	2605 BATTLE RUN RD	TRIADELPHIA, WV 26059	3

RECEIVED Office of Oil and Gas

JUN 2 7 2018

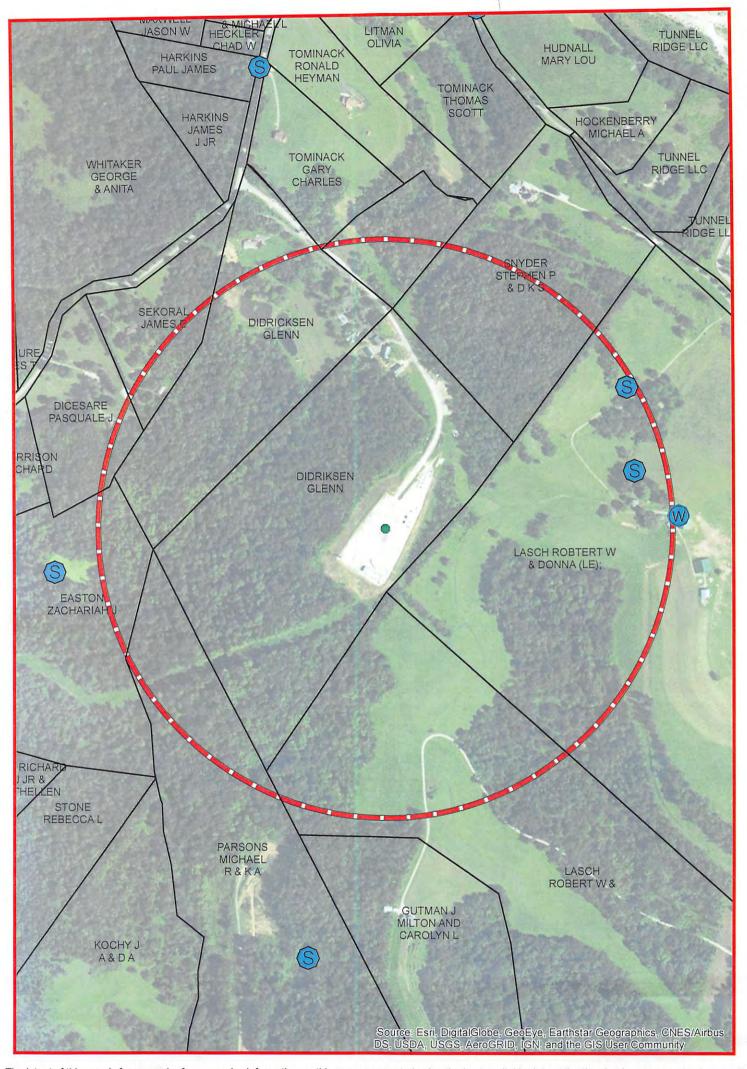

The intent of this map is for general reference only. Information on this map was created using the best available data at the time but is not guaranteed accurate. 08/24/2018

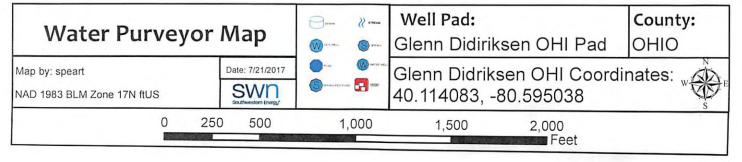

WW-6A4 (1/12)

STATE OF WEST VIRGINIA DEPARTMENT OF ENVIRONMENTAL PROTECTION, OFFICE OF OIL AND GAS NOTICE OF INTENT TO DRILL

Pursuant to W. Va. Code § 22-6A-16(b), the Notice of Intent to Drill is only required if the notice requirements of W. Va. Code § 22-6A-10(a) have NOT been met or if the Notice of Intent to Drill requirement has NOT been waived in writing by the surface owner.

Notice Time F Date of Notice	Requirement: Notice shall be provided a 05/23/2018 Date Pe	at least TEN (10) days prior to filing a rmit Application Filed:	permit application. PECEIVED Office of Oil and Gas	
Delivery meth	od pursuant to West Virginia Code §	22-6A-16(b)	JUN 27 2018	
☐ HAND	CERTIFIED MAIL		W Department of	
DELIVE	RY RETURN RECEIPT RE	QUESTED	Environmental rrutection	
receipt request drilling a horiz of this subsecti subsection may and if available Notice is her	ed or hand delivery, give the surface ow contal well: <i>Provided</i> , That notice giver on as of the date the notice was provide by be waived in writing by the surface ow c, facsimile number and electronic mail and eby provided to the SURFACE ON	mer notice of its intent to enter upon the pursuant to subsection (a), section ted to the surface owner: <i>Provided, howerer</i> . The notice, if required, shall included address of the operator and the operator with the company of the operator and the operator with the company of the operator and the operator with the company of the operator and the operator with the company of the operator and the operator with the company of the operator and the operator with the company of the operator and the operator with the company of the operator and the operator with the company of the operator and the operator with the company of the operator and the operator with the operator wit		
Name: Glenn Did		Name:		
Address: 200 Di		Address:		
State: County: District:	West Virginia Ohio Liberty	UTM NAD 83 Easting: Northing: Public Road Access:	534,499.70 4,440,478.14 Battle Run Road Glenn Didriksen OHI	
	Valley Grove, WV	Generally used farm name:		
	Upper Ohio South	Generally used farm name.	Olem Didirison of it	
Pursuant to W facsimile num related to hori:	ber and electronic mail address of the zontal drilling may be obtained from the	operator and the operator's authorize ne Secretary, at the WV Department of	ess, telephone number, and if available, and representative. Additional information of Environmental Protection headquarters, p.wv.gov/oil-and-gas/pages/default.aspx.	
	eby given by: SWN Production Company, LLC	Authorized Representative:	Ready Orahura	
Address:	PO Box 1300, 179 Innovation Drive	Address:	PO Box 1300, 179 Innovation Drive	
. Addiess.	Jane Lew, WV 26378	1 touress.	Jane Lew, WV 26378	
Telephone:	304-439-1532	Telephone:	304-439-1532	
Email:	Randy Orsburn@swn.com	Email:	Randy Orsburn@swn.com	
Facsimile:	304-884-1691	Facsimile:	304-884-1691	
	25. 301. 301			

Oil and Gas Privacy Notice:

The Office of Oil and Gas processes your personal information, such as name, address and telephone number, as part of our regulatory duties. Your personal information may be disclosed to other State agencies or third parties in the normal course of business or as needed to comply with statutory or regulatory requirements, including Freedom of Information Act requests. Our office will appropriately secure your personal information. If you have any questions about our use or your personal information, please contact DEP's Chief Privacy Officer at depprivacyofficer@wv.gov.

WW-6A5 (1/12)

STATE OF WEST VIRGINIA 4706900285 DEPARTMENT OF ENVIRONMENTAL PROTECTION, OFFICE OF OIL AND GAS NOTICE OF PLANNED OPERATION

	e Requirement: notice shall be provided notice: 05/23/2018 Date Permit Ap	later than the filing oplication Filed:	date of permit	application.
Delivery me	ethod pursuant to West Virginia Code § 2	22-6A-16(c)		
■ CERT	IFIED MAIL	HAND		
	RN RECEIPT REQUESTED	DELIVERY		
return receip the planned required to b drilling of a damages to t (d) The notic of notice. Notice is he (at the addre Name: Glenn I Address: 200 Triadelphia, WV Notice is he Pursuant to operation on	operation. The notice required by this subserved provided by subsection (b), section ten of horizontal well; and (3) A proposed surfact the surface affected by oil and gas operation ces required by this section shall be given to be provided to the SURFACE OWNER as listed in the records of the sheriff at the to Didriksen Dr. 26059 Treby given: West Virginia Code § 22-6A-16(c), notice in the surface owner's land for the purpose of	ce owner whose land absection shall includ if this article to a surfa ace use and compens as to the extent the da to the surface owner a R(s) time of notice): Name: Address as hereby given that the	I will be used for the company of th	or the drilling of a horizontal well notice of of this code section; (2) The information see land will be used in conjunction with the at containing an offer of compensation for pensable under article six-b of this chapter. Sted in the records of the sheriff at the time well operator has developed a planned act of land as follows:
State: County:	West Virginia Ohio	UTM NAD 8	3 Easting: Northing:	534,499.70 4,440,478.14
District:	Liberty	Public Road		Battle Run Road
Quadrangle:			ed farm name:	Glenn Didríksen OHI
Watershed:	Upper Ohio South			
Pursuant to to be provide horizontal we surface affect information	vell; and (3) A proposed surface use and co cted by oil and gas operations to the exten related to horizontal drilling may be obta s, located at 601 57th Street, SE, Charl	surface owner whose mpensation agreement the damages are co- ined from the Secret	e land will be on the containing are compensable und cary, at the WV	code section; (2) The information required used in conjunction with the drilling of a n offer of compensation for damages to the der article six-b of this chapter. Additional Department of Environmental Protection or by visiting www.dep.wv.gov/oil-and-damages-number-10">www.dep.wv.gov/oil-and-damages-number-10">www.dep.wv.gov/oil-and-damages-number-10">www.dep.wv.gov/oil-and-damages-number-10">www.dep.wv.gov/oil-and-damages-number-10">www.dep.wv.gov/oil-and-damages-number-10">www.dep.wv.gov/oil-and-damages-number-10">www.dep.wv.gov/oil-and-damages-number-10">www.dep.wv.gov/oil-and-damages-number-10">www.dep.wv.gov/oil-and-damages-number-10"
Well Operat	OF: SWN Production Company, LLC	Address:	DO Pay 1200 1701	Inneviation Priva
Telephone:	304-439-1532	Addiess.	PO Box 1300, 179 I Jane Lew, WV 2637	pro-
Email:	Randy_Orsburn@swn.com	Facsimile:	Sub-interestate a service service	
Oil and Gas	s Privacy Notice:			

The Office of Oil and Gas processes your personal information, such as name, address and telephone number, as part of our regulatory duties. Your personal information may be disclosed to other State agencies or third parties in the normal course of business or as needed to comply with statutory or regulatory requirements, including Freedom of Information Act requests. Our office will appropriately secure your personal information. If you have any questions about our use or your personal information, please contact DEP's Chief Privacy Officer at depprivacyofficer@wv.gov.

Office of Oil and Gas

JUN 27 2018



WEST VIRGINIA DEPARTMENT OF TRANSPORTATION

Division of Highways

1900 Kanawha Boulevard East • Building Five • Room 110 Charleston, West Virginia 25305-0430 • (304) 558-3505

Reissued May 24, 2018

Thomas J. Smith, P. E. Secretary of Transportation/ Commissioner of Highways

Jill M. Newman Deputy Commissioner

James A. Martin, Chief Office of Oil and Gas Department of Environmental Protection 601 57th Street, SE Charleston, WV 25304

Subject: DOH Permit for the Glen Didriksen Pad Well Sites, Ohio County

Glen Didriksen OHI 410H

Dear Mr. Martin,

The West Virginia Division of Highways has transferred Permit #06-2011-0016 for the subject site to Southwest Energy for access to the State Road for the well site located off of Ohio County Route 33 SLS.

The operator has signed an OIL AND GAS ROAD MAINTENANCE BONDING AGREEMENT and provided the required Bond. This operator is currently in compliance with the DOH OIL AND GAS POLICY dated January 3, 2012.

Very Truly Yours,

Gary K. Clayton P.E. Regional Maintenance Engineer

Central Office Oil &Gas Coordinator

Dans K. Clayton

Cc: Dee Southall

Chesapeake Appalachia, LLC

CH, OM, D-6

File

RECEIVED Office of Oil and Gas

JUN 2 7 2018

FRAC ADDITIVES 4706900285				
Product Name	Product Use	Chemical Name	CAS Number	
		Hydrogen Peroxide	7722-84-1	1
EC6734A (Champion Technologies)	Biocide	Acetic Acid	64-19-7	1
, ,		Peroxyacetic Acid	79-21-0	1
		Methanol	67-56-1	i
GYPTRON T-390 (Champion Technologies)	Scale Inhibitor	Nonylphenol Ethoxylate	Proprietary	1
		Glutaraldehyde	111-30-8	1
Bactron K-139 (Champion Technologies)	Biocide	Quaternary Ammonium Compounds, Benzyl-C12- 16-Alkyldimethyl, Chlorides	68424-85-1	
		Ethanol	64-17-5	1
Bactron K-219 (Champion Technologies)	Biocide	Methanol	67-56-1	
,		Quaternary Ammonium Compounds, Benzyl-C12- 16-Alkyldimethyl, Chlorides	68424-85-1	
EC6486A (Nalco Champion)	Scale Inhibitor	Amine Triphosphate	Proprietary	1
ECOTOOA (Naico Champion)	Jeale Hillibitul	Ethylene Glycol	107-21-1	
WFRA-2000 (U.S. Well Services)	Anionic Friction Reducer	Hydrotreated light distillate (petroleum)	64742-47-8	I
VVI TVA-2000 (0.5. Well Services)	Amonic inction reducer	Propenoic acid, polymer with propenamide	9003-06 9	
		Ethylene glycol	107-21 1	ŀ
		Cinnamaldehyde	104-55 2	
AI-303 (U.S. Well Services)	Mixture	Butyl cellosolve	111-76 2	
A1-303 (0.3. Well Services)	IVIIXture	Formic acid	64-18 6	
		Polyether	Proprietary	
		Acetophenone, thiourea, formaldehyde polymer	68527-49 1	
AP ONE (U.S. Well Services)	Breaker	Ammonium persulfate	7727-54-0	
OPTI-FLEX (U.S. Well Services)	Viscosifying Agent	Distillates, petroleum, hydrotreated light	64742-47-8	1
		Methanol	67-56-1	
		Oxyalkylated fatty acid	68951-67-7	
		Fatty acids	61790-12-3	
Econo-Cl200 (swn Well Services)	Corrosion Inhibitor	Modified thiourea polymer	68527-49-1	
200110 01200 (5000 0001500005)		Water	7732-18-5	
		Hydrochloric acid	7647-01-0	
		Potassium acetate	127-08-2	
		Formaldehyde	50-00-0	ļ
_	_	Acetic Acid	64-19-7	l
Ecopol-FEAC (SWN Well Services)	Iron Control	Citric Acid	77-92-9	l
		Water	7732-18-5	Gas
HCL (SWN Well Services)	Hydrocholic Acid	Hydrochloric Acid	7647-01-0	9
FLOURT DDD 1120V		Water	7732-18-5	E SE
FLOJET DRP 1130X (SWN Well Services)	Friction Reducer	Proprietary	Proprietary	RECEIVED Office of Oil and
		Distillates (petroleum) hydrotreated light	64674-47-8	문 ₀
SLOJET DROCE LEE	Estable D. 1	Ethylene Glycol	107-21-1	Į Ķ
FLOJET DR900 LPP (SWN Well Services)	Friction Reducer	Alcohols, C12-16, Exoxylated propoxylated	68213-24-1	ľ
		Fatty Alcohols ethoxylated Water	Proprietary 7732-18-5	ł
				ł
FR-76 (Halliburton)	Friction Reducer	Hydrotreated light petroleum distillate Inorganic Salt	64742-47-8 Proprietary	ł
HAI-150E (Halliburton)	Corrosion Inhibitor	No hazardous substance	N/A	ł
Tien 2000 (Hamburton)	CONTOSION MINIBILOR		· · · · · · · · · · · · · · · · · · ·	l
FDP-S1176-15 (Halliburton)	Friction Reducer	Polyacylate Hydrotreated light petroleum distillate	Proprietary 64742-47-8	
		Organic phosphonate		ł
LP-65 MC (Halliburton)	Scale Inhibitor	Ammonium Chloride	Proprietary 12125-02-9	l
CarboNRT	Tracer	Ceramic Proppant	66402-68-4)	0/0
Carpolatri	Hacei	Ceramic Proppant	00402-00-4)	D/24

EVACUATION ROUTE / PREVAILING WINDS

EVACUATION ROUTE / PREVAILING WINDS

CONSTRUCTION AS-BUILT ACCESS ROAD PROFILE

AS-BUILT / CONSTRUCTION OVERVIEW

AS-BUILT / CONSTRUCTION PLAN

AS-BUILT / CONSTRUCTION PLAN

AS-BUILT / CONSTRUCTION PLAN

RECLAMATION PLAN OVERVIEW

RECLAMATION PLAN

RECLAMATION PLAN

RECLAMATION PLAN

RECLAMATION DETAILS

RECLAMATION DETAILS

RECLAMATION DETAILS

DATE

2017-11-30

SHEET INDEX

COVER SHEET

C-001

C-101 C-102

C-201

C-301

C-302

C-303

C-401

R-501

R-601

R-602

R-603

R-604

R-605

R-606

1 PER WYDEP COMMENTS

QTY./SIZE

48 CY of #57 STONE

2 EA.

111 LF

2 EA.

4 EA.

AASHTO #3 = 1.25 CY

RIPRAP D50 6" = 3.75 CY

REVISION



GLENN DIDRIKSEN PAD CONSTRUCTION AS-BUILT LIBERTY DISTRICT, OHIO COUNTY, WV MAY 2017

COORDINATES: SITE ENTRANCE (NAD 83) LAT: 40.119029

LONG: -80.597673

AT DIDRIKSEN PAD (NAD 83) LAT: 40.114523 LONG: -80.594813

CENTER OF PAD (NAD 83)

LAT: 40.114097 LONG: -80.595004

GATHERING AREA (NAD 83) LAT: 40.119078 LONG: -80.597596

WVDEP OOG ACCEPTED AS-BUILT

2 / 13 / 2018

PROJECT

LOCATION

YOUDIG! 800.248,4848

DIDRIKSEN 1H 47-069-00123 (NAD 83)

47-069-00188 (NAD 83)

LAT: 40.114066

DIDRIKSEN 10H (NAD 83)

DIDRIKSEN 205H 47-069-00189 (NAD 83)

DIDRIKSEN 210H 47-069-00190 (NAD 83) LAT: 40.113907

LONG: -80.595071

EXISTING WELLS:

LAT: 40.114065 LONG: -80.595112

DIDRIKSEN 6H

LAT: 40.113938 LONG: -80.595043

DIDRIKSEN 8H 47-069-00064 (NAD 83)

LONG: -80.595021

47-069-00191

LAT: 40,114040 LONG: -80.594955

LAT: 40.113971 LONG: -80.595016

SWN

Production Company, LLC

QUANTITIES TABLE

RECLAMATION

DISCHARGE AREAS

RIPRAP

BREACH AREAS

WELL CELLARS - 60" CMP

Production Company™

QTY./SIZE

AASHTO #3 = 18 CY

RIPRAP D50 6" = 40 CY

3 EA.

6 EA.

GLENN DIDRIKSEN COVER SHEET C-001 LIBERTY DISTRICT, OHIO COUNTY, WV.

DRAWING 2017-342 Didriksen As-Built Plans.dwg



LOD			
DESCRIPTION	ACRES		
ROAD DISTURBED AREA	3.22		
PAD DISTURBED AREA	5.79		
TOTAL	9.01		



PREDRILLING

ROAD OVER BERM

CATCH BASINS

4" PVC DRAIN PIPES

4" STEEL GATE VALVE

ANTI-SEEP COLLARS

OUTLET PROTECTION

