

# west virginia department of environmental protection

Office of Oil and Gas 601 57th Street, S.E. Charleston, WV 25304 (304) 926-0450 fax: (304) 926-0452

Austin Caperton, Cabinet Secretary www.dep.wv.gov

Monday, December 21, 2020 WELL WORK PERMIT Horizontal 6A / New Drill

SWN PRODUCTION COMPANY, LLC POST OFFICE BOX 12359 SPRING, TX 773914954

Re: Permit approval for CARL ROTTER OHI 10H 47-069-00328-00-00

This well work permit is evidence of permission granted to perform the specified well work at the location described on the attached pages and located on the attached plat, subject to the provisions of Chapter 22 of the West Virginia Code of 1931, as amended, and all rules and regulations promulgated thereunder, and to any additional specific conditions and provisions outlined in the pages attached hereto. Notification shall be given by the operator to the Oil and Gas Inspector at least 24 hours prior to the construction of roads, locations, and/or pits for any permitted work. In addition, the well operator shall notify the same inspector 24 hours before any actual well work is commenced and prior to running and cementing casing. Spills or emergency discharges must be promptly reported by the operator to 1-800-642-3074 and to the Oil and Gas Inspector.

Please be advised that form WR-35, Well Operators Report of Well Work is to be submitted to this office within 90 days of completion of permitted well work, as should form WR-34 Discharge Monitoring Report within 30 days of discharge of pits, if applicable. Failure to abide by all statutory and regulatory provisions governing all duties and operations hereunder may result in suspension or revocation of this permit and, in addition, may result in civil and/or criminal penalties being imposed upon the operators.

Per 35 CSR 4-5.2.g this permit will expire in two (2) years from the issue date unless permitted well work is commenced. If there are any questions, please feel free to contact me at (304) 926-0450.

James A. Martin

Farm Name: CARL J & GRACE A ROTTER

Operator's Well Number: CARL ROTTER OHI 10H

U.S. WELL NUMBER: 47-069-00328-00-00

Date Issued: 12/21/2020

Horizontal 6A New Drill

Promoting a healthy environment.

API Number:	

# PERMIT CONDITIONS 4706900328

West Virginia Code § 22-6A-8(d) allows the Office of Oil and Gas to place specific conditions upon this permit. Permit conditions have the same effect as law. Failure to adhere to the specified permit conditions may result in enforcement action.

CO		m	Towns.	^	MIC
LU	ж	w	111	u	17.12

- 1. This proposed activity may require permit coverage from the United States Army Corps of Engineers (USACE). Through this permit, you are hereby being advised to consult with USACE regarding this proposed activity.
- 2. If the operator encounters an unanticipated void, or an anticipated void at an unanticipated depth, the operator shall notify the inspector within 24 hours. Modifications to the casing program may be necessary to comply with W. Va. Code § 22-6A-5a (12), which requires drilling to a minimum depth of thirty feet below the bottom of the void, and installing a minimum of twenty (20) feet of casing. Under no circumstance should the operator drill more than one hundred (100) feet below the bottom of the void or install less than twenty (20) feet of casing below the bottom of the void.
- 3. When compacting fills, each lift before compaction shall not be more than 12 inches in height, and the moisture content of the fill material shall be within limits as determined by the Standard Proctor Density test of the actual soils used in specific engineered fill, ASTM D698, Standard Test Method for Laboratory Compaction Characteristics of Soil Using Standard Effort, to achieve 95 % compaction of the optimum density. Each lift shall be tested for compaction, with a minimum of two tests per lift per acre of fill. All test results shall be maintained on site and available for review.
- 4. Operator shall install signage per § 22-6A-8g (6) (B) at all source water locations included in their approved water management plan within 24 hours of water management plan activation.
- 5. Oil and gas water supply wells will be registered with the Office of Oil and Gas and all such wells will be constructed and plugged in accordance with the standards of the Bureau for Public Health set forth in its Legislative rule entitled Water Well Regulations, 64 C.S.R. 19. Operator is to contact the Bureau of Public Health regarding permit requirements. In lieu of plugging, the operator may transfer the well to the surface owner upon agreement of the parties. All drinking water wells within fifteen hundred feet of the water supply well shall be flow tested by the operator upon request of the drinking well owner prior to operating the water supply well.
- 6. Pursuant to the requirements pertaining to the sampling of domestic water supply wells/springs the operator shall, no later than thirty (30) days after receipt of analytical data provide a written copy to the Chief and any of the users who may have requested such analyses.
- 7. 24 hours prior to the initiation of the completion process the operator shall notify the Chief or his designee.
- 8. During the completion process the operator shall monitor annular pressures and report any anomaly noticed to the chief or his designee immediately.
- 9. If any explosion or other accident causing loss of life or serious personal injury occurs in or about a well or well work on a well, the well operator or its contractor shall give notice, stating the particulars of the explosion or accident, to the oil and gas inspector and the Chief, within 24 hours of said accident.
- 10. During the casing and cementing process, in the event cement does not return to the surface, the oil and gas inspector shall be notified within 24 hours.

API Number:	
-------------	--

# **PERMIT CONDITIONS** 4706900328

11. The operator shall provide to the Office of Oil and Gas the dates of each of the following within 30 days of their occurrence: completion of construction of the well pad, commencement of drilling, cessation of drilling, completion of any other permitted well work, and completion of the well. Such notice shall be provided by sending an email to DEPOOGNotify@wv.gov.

API NO. 47-009 OPERATOR WELL NO. Carl Rotter OHI 10H
Well Pad Name: Carl Rotter OHI

# STATE OF WEST VIRGINIA DEPARTMENT OF ENVIRONMENTAL PROTECTION, OFFICE OF OIL AND GAS WELL WORK PERMIT APPLICATION

1) Well Operator: SWN Pro	duction Co., LLC	494512924	069-Ohio	3-Liberty	648-Valley Grove
- V		Operator ID	County	District	Quadrangle
2) Operator's Well Number:	Carl Rotter OHI 1	OH Well P	ad Name: Carl	Rotter OHI	
3) Farm Name/Surface Owner	Carl J. & Grace A	. Rotter Public Ro	oad Access: Ro	gers Road	
4) Elevation, current ground:	1336' E	levation, propose	d post-construct	ion: 1336'	0
5) Well Type (a) Gas <u>x</u> Other	Oil	Un	derground Stora	ige	
Ve./ 22 - 34 - 9	Shallow X	Deep		2 -	
6) Existing Pad: Yes or No	Horizontal <u>x</u> Yes		C-7	00	16.20
7) Proposed Target Formation	n(s), Depth(s), Anti	The state of the s	The second of th	2.0	
'Target Formation- Marcellus, Down-Dip	well to the South, Target To	p TVD- 6733' Target Base	TVD- 6791', Anticipate	d Thickness- 58',	Associated Pressure- 4414
8) Proposed Total Vertical De	epth: 6766'				
9) Formation at Total Vertical	Depth: Marcellu	IS			
10) Proposed Total Measured	Depth: 21450'				
11) Proposed Horizontal Leg	Length: 14496.1	5'			
12) Approximate Fresh Water	Strata Depths:	586'			
13) Method to Determine Free	sh Water Depths:	Salinity Profile A	Analysis using o	deepest nea	arby water well
14) Approximate Saltwater D	epths: 832' Salini	ty Profile Analysis	of Pottsville Sa	ndstone	RECEIVED
15) Approximate Coal Seam	Depths: 721'				Office of Oil and Gas
16) Approximate Depth to Po	ssible Void (coal n	nine, karst, other):	Possible Void	721'	NOV 1 3 2020
17) Does Proposed well locate directly overlying or adjacent			N	o <u>x</u>	WV Department of Environmental Protection
(a) If Yes, provide Mine Info	o: Name: Tun	nel Ridge			
	Depth: 721				
	Seam: Pitts	sburgh			
	Owner: Tun	nel Ridge			

WW-6B (04/15) OPERATOR WELL NO. Carl Rotter OHI 10H
Well Pad Name: Carl Rotter OHI

18)

# CASING AND TUBING PROGRAM

TYPE	Size (in)	New or Used	<u>Grade</u>	Weight per ft. (lb/ft)	FOOTAGE: For Drilling (ft)	INTERVALS: Left in Well (ft)	CEMENT: Fill-up (Cu. Ft.)/CTS
Conductor	20"	New	J-55	94#	126'	126'	CTS
Fresh Water	13 3/8"	New	H-40	48#	760'	760'	713 sx/CTS
Coal	See	Surface	Casing				
Intermediate	9 5/8"	New	J-55	36#	2168'	2168'	909 sx/CTS
Production	5 1/2"	New	P-110 HP	20#	21450'	21450'	Tail 4049sx/ 100' Inside Intermediate
Tubing							
Liners				Activities to the second secon			

E- What 11-10

TYPE	Size (in)	Wellbore Diameter (in)	Wall Thickness (in)	Burst Pressure (psi)	Anticipated Max. Internal Pressure (psi)	Cement Type	Cement Yield (cu. ft./k)
Conductor	20"	30"	0.25	2120	81	Class A	
Fresh Water	13 3/8"	17.5"	0.380	2730	633	Class A	1.20/30% Excess
Coal	See	Surface	Casing				
Intermediate	9 5/8"	12 1/4"	0.352	3520	1768	Class A	1.19/40% Excess
Production	5 1/2"	8 3/4"-8 1/2"	0.361	14360	10500	Class A	1.19/5% Excess
Tubing							
Liners							

RECEIVED
Office of Oil and Gas

NOV 1 3 2020

# **PACKERS**

Kind:		WV Departm Environmental P	ent of rotection
Sizes:			1
Depths Set:			
Dopuis Set.			

WW-6B (10/14)

# 4706900328

API NO. 47-009 -

OPERATOR WELL NO. Carl Rotter OHI 10H
Well Pad Name: Carl Rotter OHI

19) Describe proposed well work, including the drilling and plugging back of any pilot hole:
Drill and stimulate any potential zones between and including the Benson to Marcellus. **If we should encounter a void place basket above and below void area- balance cement to bottom of void and grout from basket to surface or run external casing packer/cementing stage tool above void interval and perform 2 stage cementing operation dependent upon depth of void. Run casing not less than 20' below void nor more than 75' below void. (*If freshwater is encountered deeper than anticipated it must be protected, set casing 50' below and cts.)
20) Describe fracturing/stimulating methods in detail, including anticipated max pressure and max rate:
Well will be perforated within the target formation and stimulated with a slurry of water, sand, and chemical additives at a high rate. This will be performed in stages with the plug and perf method along the wellbore until the entire lateral has been stimulated within the target formation. All stage plugs are then drilled out and the well is flowed back to surface. In some instances, additional toe prep may be performed by pumping additional water in the toe of the well prior to perforating and pumping Stage 1 to ensure that the toe guns/toe sleeves are fully open prior to pumping stage 1. The well is produced through surface facilities consisting of high pressure production unites, horizontal separation units, water and oil storage tanks. Max press and anticipated max rate- 9000 lbs @ 100 barrels a minute.
21) Total Area to be disturbed, including roads, stockpile area, pits, etc., (acres): 14
22) Area to be disturbed for well pad only, less access road (acres):
23) Describe centralizer placement for each casing string:
All casing strings will be ran with a centralizer at a minimum of 1 per every 3 joints of casing.
24) Describe all cement additives associated with each cement type:
See Attachment ***
Office of Oil and Gas
25) Proposed borehole conditioning procedures:
All boreholes will be conditioned with circulation and rotation for a minimum of one bottoms up and continuing until operator is satisfied with borehole conditions.  WV 1 3 2020  WV Department of Environmental Protection

<sup>\*</sup>Note: Attach additional sheets as needed.

			CEMENT A	ADDITIVES		
INTERVAL	SCHLUMBERGER PRODUCT NAME	BJ PRODUCT NAME	NEXTIER PRODUCT NAME	PRODUCT USE	470690 (	) 3 2 8 CAS-Number
SURFACE (FRESHWATER)	><	INTEGRA SEAL	CJ600	LOST CIRC MATERIAL	CELLOPHANE FLAKES	9005-81-6
up to 3%	S001	A-7P	CJ110	ACCELERATOR	CALCIUM CHLORIDE	10043-52-4
COAL PROTECTION	><	INTEGRA SEAL	CJ600	LOST CIRC MATERIAL	CELLOPHANE FLAKES	9005-81-6
up to 3%	5001	A-7P	CJ110	ACCELERATOR	CALCIUM CHLORIDE	10043-52-4
	D020	BENTONITE	CJ020	EXTENDER	BENTONITE	1302-78-9
	D047	FP 28L	$\times$	LIQUID ANTIFOAM AGENT	POLYPROPYLENE GLYCOL	25322-69-4
INTERMEDIATE	><	INTEGRA SEAL	CJ600	LOST CIRC MATERIAL	CELLOPHANE FLAKES	9005-81-6
	CemNet	> <	> <	LOST CIRC MATERIAL	COATED FIBERGLASS FIBERS	PROPRIETAR
	SUGAR	SUGAR	CJ795	CMT RETARDER	SUCROSE	57-50-1
	S001	A-7P	CJ110	ACCELERATOR	CALCIUM CHLORIDE	10043-52-4
			CJ111	ACCELERATOR	SODIUM CHLORIDE	7440-23-5
		SS-11W	CJ880	SURFACTANT NONIONIC SURFACTANT		6540-99-4
	D047	FP 28L	X	LIQUID ANTIFOAM AGENT	POLYPROPYLENE GLYCOL	25322-69-4
	>	> <	CJX157011	SOLID ANTIFOAM FULLERS AGENT EARTH(ATTAPULGITE)		8031-18-3
		$\supset$	CJ540	HP FLUID LOSS ADDITIVE	ALIPHATIC AMIDE POLYMER	PROPRIETAR
PRODUCTION	D255	>	><	MED TEMP FLUID LOSS ADDITIVE	POLYACRILIC POLYMER	PROPRIETAR
			CJ213	RETARDER	CHRYSTALLINE SILICA	14808-60-7
		FL-66	CJ501	LOW TEMP FLUID LOSS ADD	POWDERED POLYSACCHARIDE	PROPRIETAR
		BENTONITE	CJ020	EXTENDER	BENTONITE	1302-78-9
	D208	ASA-301	X	VISCOSIFIER/ANTI- SETTLING AGENT	REFINED POLYMER/ CHRYSTALLINE SILICA	PROPRIETAR
	D198	R-3		CEMENT RETARDER	LIGNIN	8068-51-6
	SUGAR	SUGAR	CJ795	CEMENT RETARDER	SUCROSE	57-50-1

RECEIVED
Office of Oil and Gas

NOV 1 3 2020

### **Proposed Drilling Program** Southwestern Energy Company TBD Well: **CARL ROTTER OHI 10** Re-entry Rig: Marcellus Shale PANHANDLE FIELD \ Prospect: Field: WV County: OHIO State: SHL: 40.1016 Latitude -80.5425 Longitude 40.0646 Latitude -80.5204 Longitude BHL: 1,362 ft MSL KB: 26 ft AGL GL Elev: 1,336 ft MSL KB Elev: Coal Seam at 721' 126 to 780 ' Air/Mist PROD TOC Lead @ 2,268 'MD 11.6-20 PROD TOC Tail @ 5,904 ' MD 780 'to 2,188' Air/Mist TUBULAR DETAIL Planned Interval Casing Weight **Casing String** Grade (Min) Size (in) (Min) From 0' 126 2,188 'to 6,550' Conductor 20 94.0# J-55 Air/Mist 13.375 48.0# H-40 0' 760' Surface/Coal 0' 2.168 Intermediate 9.625 36.0# J-55 Production 0 1 21,450 5.5 20.0 # P-110 HP CEMENT DETAIL Sacks Class Density Conductor: 19.3 151 A Surface: 15.6 713 A Intermediate: 909 A 15.6 Production: 4049 A 15.6 Freshwater Depth - 586 'TVD KOP at 5,817 'MD 6,550 'to 7,013 ' Coal Void Depth - 721 'TVD 12.0-12.2 ppg Saltwater Depth - 832' TVD RECEIVED Office of Oil and Gas TVD - 6,766 ' TMD - 21,450 ' NOV 1 3 2020 WV Department of Environmental Protection TD at 21,450 'MD 6,766 'TVD 6,596 ' Target Center EOB at 7,013 'MD Onondaga 6,791 TVD 7,013 'to 21,450 ' 12.2-12.8 ppg SHL Onondaga 6,621 'TVD Created by: Matt Weems on 10/27/2020

		Carl A	Cotter.	10H ×	10R	Producing Format and MARCELLUS FOR FORMAT AND TO THE PRODUCE OF TH	Producing Zones Not Perforated
API	Operator	Status	Latitude	Longitude	Vertical TD	Producing Formation	Producing Zones Not Perforated
47-069-00171	SWN PRODUCTION COMPANY, LLC	ACTIVE	40.101577	80.542422		MARCELLUSS TO	Pepartient From Property Prope
						में ु क	\$ <del>*</del>
						OF OF	nta nta
						VOV	Q 6
						) w C	<i>v</i> <sub>C</sub>
						`*	5 · 5
							匝
					~~~~		
		<del> </del>			······································		
		<del></del>					
		<u> </u>	1				
		<u> </u>					
		1					
		<del> </del>				<u> </u>	
		<u> </u>					
<b> </b>		<del>                                     </del>					
<b> </b>						<del>                                       </del>	
<b> </b>							
	<del>                                     </del>	<del></del>			****	<u> </u>	
<b> </b>							
<del> </del>	<u> </u>						
		<del> </del>	<b> </b>			<del> </del>	
L	1		L	I	L		1

WW-9 (4/16)

API	Number	47 -	069				_
	Ope	rator's	Well	No.	Ca	rd Rotter OHI 10H	_

# STATE OF WEST VIRGINIA DEPARTMENT OF ENVIRONMENTAL PROTECTION OFFICE OF OIL AND GAS

# FLUIDS/ CUTTINGS DISPOSAL & RECLAMATION PLAN

FLUIDS/ CUTTINGS DISFOSA	AL & RECEAVATION LEAR
Operator Name SWN Production Co., LLC	OP Code 494512924
Watershed (HUC 10) Upper Ohio South	Quadrangle Valley Grove
Do you anticipate using more than 5,000 bbls of water to complete	the proposed well work? Yes 🚺 No 📗
Will a pit be used? Yes No	
If so, please describe anticipated pit waste:	
Will a synthetic liner be used in the pit? Yes N	If so, what ml.?
Proposed Disposal Method For Treated Pit Wastes:	
Land Application	
■ Underground Injection ( UIC Permit Nu	mber_Various Approved Facilities)
Reuse (at API Number At the next anticpiate	
Off Site Disposal (Supply form WW-9  Other (Explain recovery and solidification	or disposal location)
Other (Explain 100000) and commence.	
Will closed loop system be used? If so, describe: Yes- See Attach	nent 3A
Drilling medium anticipated for this well (vertical and horizontal)?	Air, freshwater, oil based, etc. Archit to KOP. third drift such SOSM from KOP to TO
-If oil based, what type? Synthetic, petroleum, etc. Synthetic	tic Oil Base
Additives to be used in drilling medium? Attachment 3B	
Drill cuttings disposal method? Leave in pit, landfill, removed offs	ite, etc. landfill
-If left in pit and plan to solidify what medium will be used	f? (cement, lime, sawdust)
-Landfill or offsite name/permit number? Meadowfill SWF-103 Apex Sanitary Landfill Ub-U8438, Brooke Co SVVF-	2, Short Creek SWF-1034,Carbon Limestone MSWL018781, Wetzel County 1021
Permittee shall provide written notice to the Office of Oil and Gas of	f any load of drill cuttings or associated waste rejected at any
West Virginia solid waste facility. The notice shall be provided with where it was properly disposed.	nin 24 hours of rejection and the permittee shall also disclose
white it was properly disposed.	
	itions of the GENERAL WATER POLLUTION PERMIT issued
on August 1, 2005, by the Office of Oil and Gas of the West Virgin provisions of the permit are enforceable by law. Violations of any	
law or regulation can lead to enforcement action.	term of condition of the general permit and/of other applicable
	mined and am familiar with the information submitted on this
application form and all attachments thereto and that, based or obtaining the information, I believe that the information is true,	
penalties for submitting false information, including the possibility	of fine or imprisonment
Company Official Signature WHTMW 1000	OFFICIAL SEAL NOTARY PUBLIC STATE OF WEST VIRGINIA JESSICA L VARGIL DER
Company Official (Typed Name) Brittany Woody	SWN Production Company, LLC 1300 For Perport Dr., Suite 201, Marganism, W. 26508 My Commission Expires July 24, 2825
Company Official Title Senior Regulatory Analyst	RECEIVED
	Office of Oil and Gas
Subscribed and sworn before me this 28th day of 30	ptember 20 20 NOV 1 3 2020
Jessica L. Van Hilder	Notary Public WV Department of
My commission expires 7 - 24 - 25	Environmental Protection

Operator's Well No. Carl Rotter OHI 10H

roposed Revegetation Treatment: Acres Disturb	ned 14	Prevegetation pH	
Limeas determined by pH test min.2 Tons/acre or to	correct to pH 9		
Fertilizer type 10-20-20			
Fertilizer amount 600/500	lbs/acre		
Mulch_ Hay/Straw	Tons/acre		
	Seed Mixtures		
Temporary		Perma	nent
Seed Type Ibs/acre Attachment 3C		Seed Type	lbs/acre
Attach: Maps(s) of road, location, pit and proposed area for			
Maps(s) of road, location, pit and proposed area for rovided). If water from the pit will be land applied creage, of the land application area.  The hotocopied section of involved 7.5' topographic	ed, include dimensions (I sheet.	x W x D) of the pit, and	dimensions (L x W), and a
Maps(s) of road, location, pit and proposed area for rovided). If water from the pit will be land application area. Thotocopied section of involved 7.5' topographic than Approved by:	ed, include dimensions (I	x W x D) of the pit, and	
laps(s) of road, location, pit and proposed area forovided). If water from the pit will be land application area, thotocopied section of involved 7.5' topographic lan Approved by:	ed, include dimensions (I sheet.	x W x D) of the pit, and	dimensions (L x W), and a
Maps(s) of road, location, pit and proposed area for rovided). If water from the pit will be land application area.  The hotocopied section of involved 7.5' topographic land Approved by:	ed, include dimensions (I sheet.	x W x D) of the pit, and	dimensions (L x W), and a
	ed, include dimensions (I sheet.	x W x D) of the pit, and	dimensions (L x W), and a
Maps(s) of road, location, pit and proposed area for rovided). If water from the pit will be land application area.  The hotocopied section of involved 7.5' topographic land Approved by:	ed, include dimensions (I sheet.	x W x D) of the pit, and	dimensions (L x W), and a
Maps(s) of road, location, pit and proposed area for rovided). If water from the pit will be land application area. Photocopied section of involved 7.5' topographic Plan Approved by:	ed, include dimensions (I sheet.	x W x D) of the pit, and	dimensions (L x W), and a
Maps(s) of road, location, pit and proposed area for rovided). If water from the pit will be land application area. Photocopied section of involved 7.5' topographic Plan Approved by:	ed, include dimensions (I sheet.	x W x D) of the pit, and	dimensions (L x W), and a

### Attachment 3A

### **CLOSED LOOP SYSTEM**

The closed loop system is designed to eliminate the use of reserve pits by providing a higher level of solids control processing and using steel pits for capture of drill cuttings. The cuttings are then processed to achieve landfill requirements before hauling to approved landfills. The liquids are processed to recycle into the active mud system or to transfer to onsite temporary storage as needed.

The closed loop system consists of several sets of a shale gas separator (often called a 'methana'), several banks of solids shakers, high speed centrifuges (1 or 2) used to process the fluid portion of the mud system to remove low gravity solids, low speed centrifuge used for barite recovery in high weight liquid drilling systems, a dewatering system (for air intervals and if freshwater mud systems are in use) used to further clean liquids by flocculation and additional mechanical separation, associated open top tanks for processing liquids and capturing solids for disposal, and transfer pumps to move fluids through the processes. There is an area adjacent to the cuttings tanks (Red Zone) where a track hole is utilized to recover the processed cuttings for loading into containers for hauloff. (See attached schematic of a generic closed loop system layout)

Below are discussions of the processes used when drilling the air interval or liquids interval.

### AIR DRILLING INTERVALS

During air drilling operations, flow from the rig will pass down the flowline to the Shale Gas Separater (sometimes called a methane) where gas and liquids/solids are separated. Gas is sent to the flare scrubber tank and is flared at the flare stack. Solids and fluids pass across a shaker system to separate solids from liquids. Solids pass into the cuttings tanks where they are captured for drying and hauloff to an approved landfill site. Liquids fall into a shaker tank and are collected by a centrifugal pump to be processed by the high speed centrifuge to further separate liquids and solids. Solids are then dumped into the cuttings tank for drying and hauloff. Liquids are further processed to remove additional low gravity solids before being reused or transferred to onsite storage.

# LIQUIDS DRILLING (FRESHWATER, BRINE, SOBM)


When drilling is converted to liquids drilling, the shale gas separator and associated shaker tank are bypassed, and the liquids system is processed over the primary and drying shaker systems. Cuttings drop into the cuttings tank for additional processing. Any recoverable associated liquids attached to the cutting are recovered out the tank and processed through the low gravity (high speed) and barite recovery centrifuges (low speed) to further remove low gravity solids and to recover barite for reuse in the mud systems.

RECEIVED
Office of Oil and Gas

NOV 1 3 2020

# Solids Control Layout



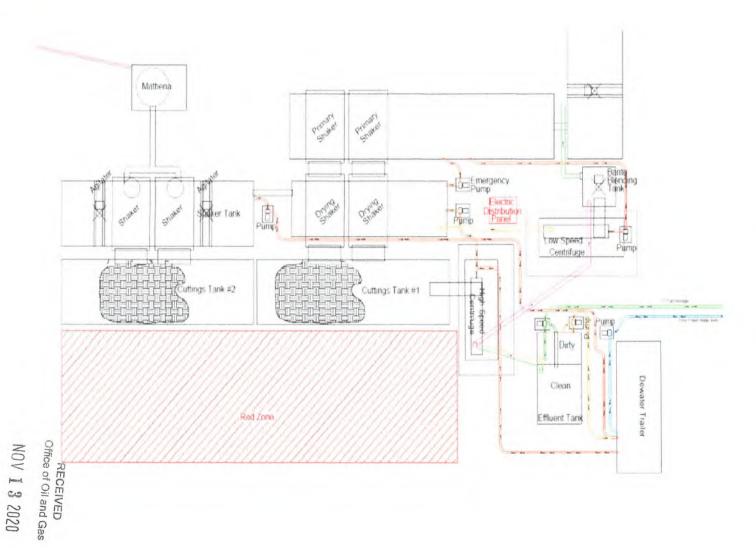

# **Attachment 3B**

# **Drilling Mediums**

# <u>Surface/Coal(if present)/Freshwater Intervals:</u> Air

Freshwater (if needed based on conditions)

# **Intermediate/Coal (if present):**

Air

# **Production Hole:**

Air

Synthetic Oil (Base Fluid for mud system)

**Barite** 

Calcium Chloride

Lime

**Organophilic Bentonite** 

**Primary and Secondary Emulsifiers** 

Gilsonite

**Calcium Carbonate** 

**Friction Reducers** 

RECEIVED
Office of Oil and Gas

NOV 1 3 2020



# **WVD Seeding Specification**



To Order Seed contact Lyndsi Eddy Flippo office 570-996-4271 cell 501-269-5451 lyndsi\_eddy@swn.com

(please allow 7 to 10 days for delivery)

NON-ORGANIC PROPERTIES		
Seed Mixture: ROW Mix	SWN	l Supplied
Orchardgrass	40%	
Timothy	15%	
Annual Ryegrass	15%	
Brown Top Millet	5%	
Red Top	5%	
Medium Red Clover	5%	All legumes are
White Clover	5%	innoculated at 5x norma
Birdsfoot Trefoil	5%	rate
Rough Bluegrass	5%	
Apply @ 100lbs per acre April 16th- Oct. 14th		Apply @ 200lbs per acre Oct. 15th- April 15th PLUS bs per acre of Winter Wheat

SOIL AMENDMENTS	
10-20-20 Fertilizer	*Apply @ 500lbs per Acre
Pelletized Lime	Apply @ 2 Tons per Acre
	*unless otherwise dictated by soil test results

Seeding	Calculation	intermation:
1452' o	f 30' ROW/	LOD is One A

871' of 50' ROW/LOD is One Acre 622' of 70' ROW/LOD is One Acre

### Synopsis:

Every 622 linear feet in a 70' ROW/LOD, you should be using (2) 50lb bags of seed, (4) 50lb bags of fertilizer and (80) 50lb bags of Lime (2x seed in winter months + 50lb Winter Wheat/ac).

### Special Considerations:

Landowner Special Considerations including CREP program participants require additional guidance that is not given here. Discuss these requirements with SWN supervision at the beginning of the project to allow time for special seed delivery.

Seed Mixture: SWN Production Orga	nic Mix	SWN Supplied
Organic Timothy	50%	u uc
Organic Red or White Clover	50%	Gas of of
OR		ED 20 20 Protection
Organic Perennial Ryegrass	50%	Se samme samme tal F
Organic Red or White Clover	50%	Africe of Oil and Gas  Africe of Oil and Gas  OV 1 3 2020  Wironmental Protection
Apply @ 100lbs per acre		Apay @ 200lbs per scre
April 16th- Oct. 14th		Oct. 15th- April 15th
Organic Fertilizer @ 200lbs per Acre		Pelletized Lime @ 2 Tons per A

Seed Mixture: Wetland Mix	SWN Supplied
/A Wild Ryegrass	20%
Annual Ryegrass	20%
owl Bluegrass	20%
Cosmos 'Sensation'	10%
Redtop	5%
Golden Tickseed	5%
Maryland Senna	5%
Showy Tickseed	5%
Fox Sedge	2.5%
Soft Rush	2.5%
Woolgrass	2.5%
Swamp Verbena	2.5%
Apply @ 25lbs per acre	Apply @ 50lbs per acre
April 16th- Oct. 14th	Oct. 15th- April 15th

# MARCELLUS WELL DRILLING PROCEDURES AND WELL SITE SAFETY PLAN





SWN Production Company, LLC 1300 Fort Pierpont Drive, Suite 201 Morgantown, West Virginia 26508


API NO. 47-XXX-XXXXX
WELL NAME: Carl Rotter OHI 10H
Valley Grove QUAD
Liberty DISTRICT
OHIO COUNTY, WEST VIRGINIA

Submitted by:			
Name: Brittany Woody Suttany Woody	Date:	9/14/2020	
Title: Senior Regulatory Analyst		SWN Production Co., LLC	
Approved by:  Name: Colonel Ga Typector		11-6.20	
Approved by:  Name:  Title:	Date:		RECEIVED Office of Oil and Gas NOV 1 3 2020
	CALLES.	and Artist II	WV Department of Environmental Protection

SWN PRODUCTION COMPANY, LLC - CONFIDENTIAL

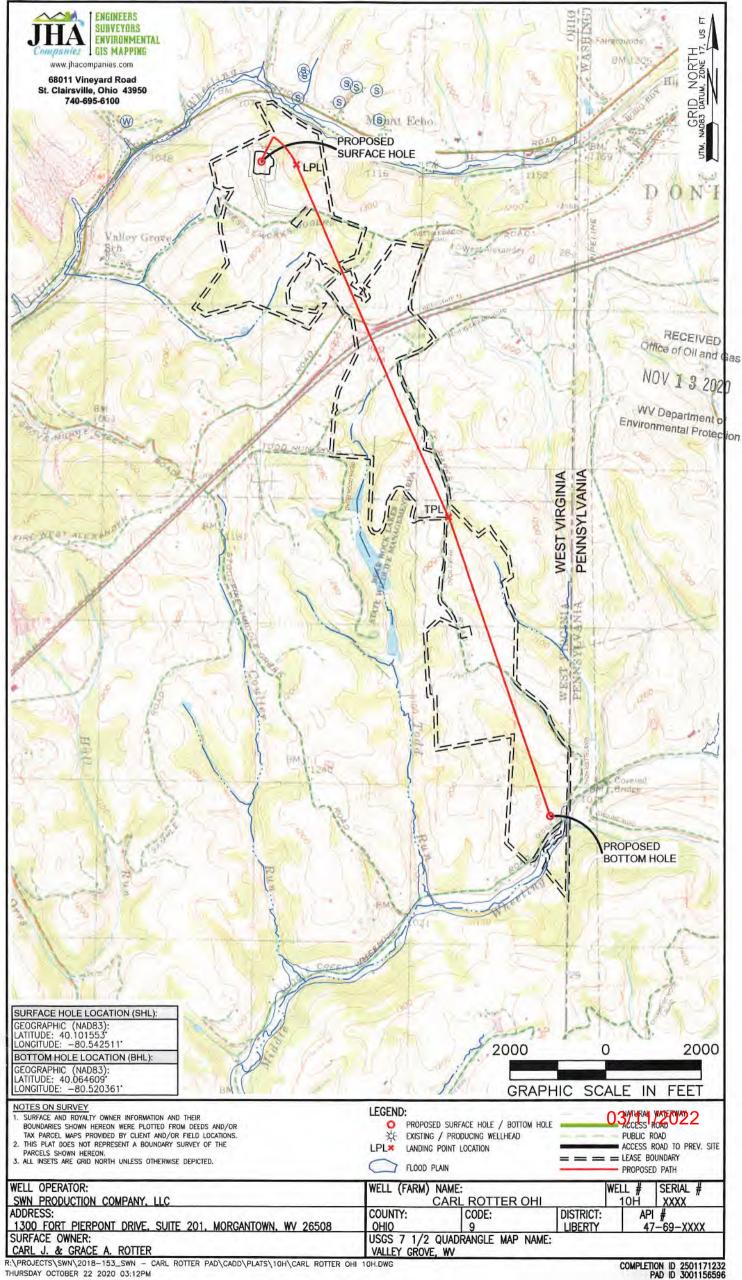

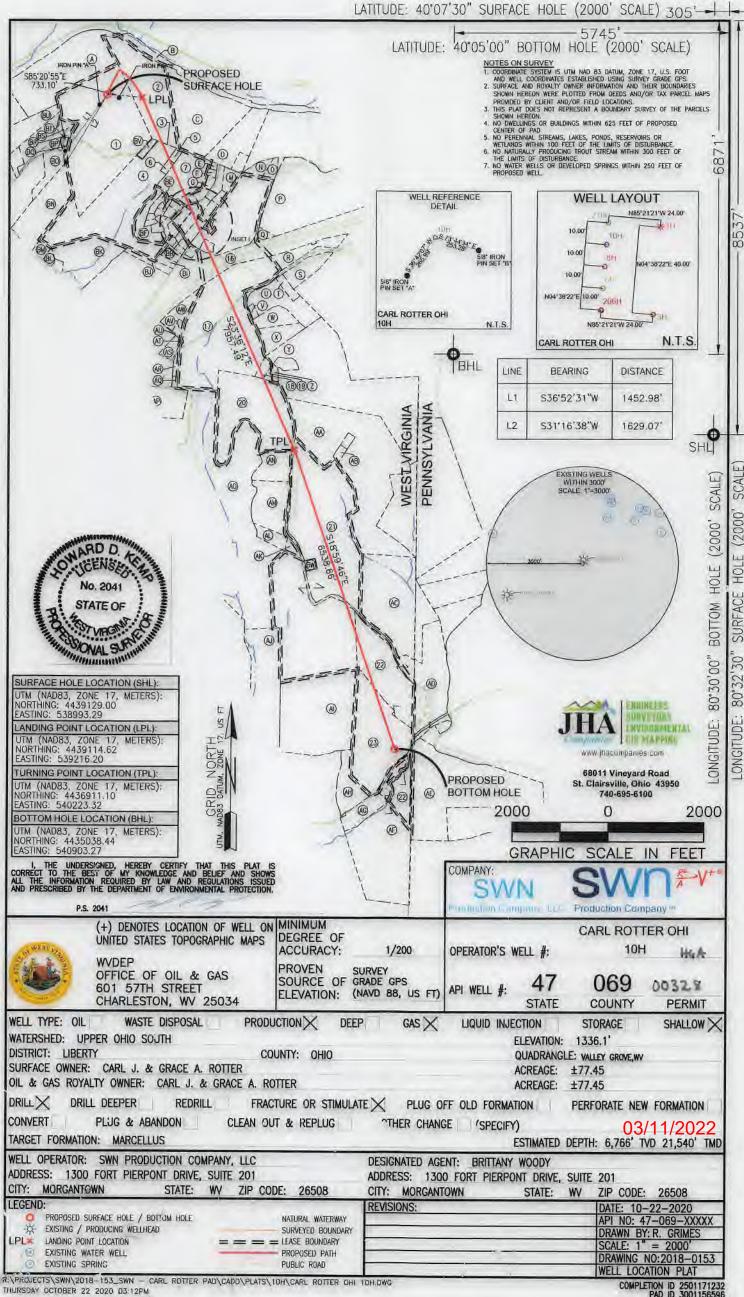

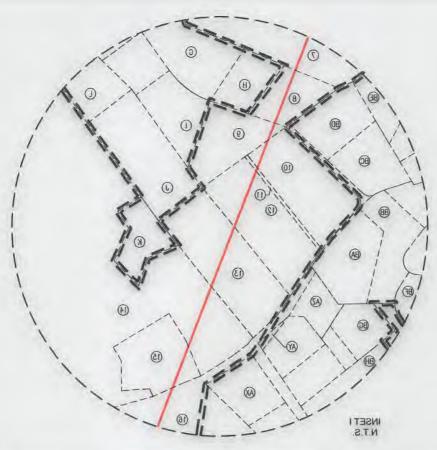

TRACT

VERS	WELL BORE TABLE FOR SURFACE/ROYALTY OWN	
TAX PARCEL	SURFACE OWNER (S) / ROYALTY OWNER (R)	TRACT
3-111-54	ROTTER CARL J & GRACE A (S/R)	1
TAX PARCEL	SURFACE OWNER	TRACT
3-L11-60.1	GRIFFITH SHARON & WARREN	2
REALTREE RD., FKA TRESTLEWORK ROGERS RD	WEST VIRGINIA DEPARTMENT OF TRANSPORTATION,	E
AKA ROGERS ROAD	DIVISION OF HIGHWAYS	4
3-111-46.18	KLAGES LLOYD A JR.	5
3-111-46,20	POWERS JEFFREY B	
3-L11-46.9	KLAGES PROPERTIES LLC	7
3-111-46.11	WOLEN JOHN J & MICHELLE L	
3-L11-46.13	TUNNEL RIDGE LLC	8
3-111-46.8	JSNE LLC (LOT 2)	6
3-111-48.4	KOSOLJOSEPHJOHN JR., & LAURA JEAN	10
3-L11-48.5	TUNNEL RIDGE LLC	11
3-L11-48.2	TUNNEL RIDGE LLC	12
3-L14-54	TUNNEL RIDGE LLC	13
3-1.15-1.1	HALL ROBERT H. & LAURA L., HALL DAVID LEE & SANDRA SUE, PASCO THOMAS P. & MARY	14
3-115-1.2	WOOD BRENTON R & KELLY S	15
INSTERSTATE 70	STATE OF WEST VIRGINIA, DEPARTMENT OF HIGHWAYS	16
3-L15-2.2	PAGENDARM PATRICA M.	17
3-L15-2.4	MORGAN SALLY A	18
3-115-2.8	MORGAN SALLY A	19
6-15-2	WEST VIRGINIA DIVISION OF NATURAL RESOURCES DAVIS JOHN RICHARD JR., DAVIS DEBRA L.,	20
6-110-1	DAVIS JOSEPH DAVID	21
6-110-4	HORR DONNIE L., BRIGGS KAREN L., HORR GLENN B.	22
6-T10-4.1	HORR DONNIE L& MICHELLE	23
	ADJOINING OWNERS TABLE	
TAX PARCEL	SURFACE OWNER	RACT
3-111-61	NOLAN JOHN AJR	A
3-112-32	TUNNEL RIDGE LLC	8
3-111-60	WATKINS THERESA & MARK	)
3-112-25	TUNNEL RIDGE LLC	D
3-111-46.8	JSNE LLC (LOT15)	3
3-111-46.2	TUNNEL RIDGE LLC	1
3-111-46,8	JSNE LLC (LOTS 5,7,9,11)	9
3-111-46.19	TUNNEL RIDGE LLC	H
3-111-46.12	TUNNEL RIDGE LLC	1
3-111-48.1	TUNNEL RIDGE LLC	1
3-115-7	TUNNEL RIDGE LLC	K
3-(11-48.10	KLAGES LLOYD A JR & AMY	-
3-112-30	KLAGES LLOYD A JR & AMY	M
3-112-18.1	TUNNEL RIDGE LLC	N
3-112-18.2	TUNNEL RIDGE LLC	9
3-112-18	TRIPLE P LLC	Q
3-112-18.6	TURNER FRANCES A	R
3-112-18.8	TRIPLE PLLC	2
	TRIPLE P.LLC	
3-112-18.9		
3-L15-2.9	BERGHOFF BRAD W	T II
777 - 77 - 77	BERGHOFF BRAD W BERGHOFF GERALD W GYEKIS ROBERTJ & VICKI L	Ü

3 115-4.1	ERNEST LAWRENCE F & DEBORAH K	X
3-115-4	OLIVER LUCAS B	Y
3-L15-4.2	JEWETT CLARENCE G AND TRACY	2
3415-4.6	TUNNEL RIDGE LLC	AA
3-115-4.4	TUNNEL RIDGE LLC	AB
6-710-4.2	BRIGGS KAREN LYNN & HENRY WILLIAM	AC
680-005-00-00-0003-00	HORR DONNIE L & GLENN B & KAREN L BRIGGS,	AD.
680-005-00-00-0002-00	MOORETHOMASE	AE
6-T10-10	LEMMON JOSHUA, LEMMON MORGAN ASHLEY,	AF
-	LEMMON WADE LEE	AG
6-710-9	ASHTON BETHA JACOBS DOUGLAS E	-
6-T10-5.9	RICHEY DONALD EDWARD JR, RICHEY CHRISTINE	HA
6-710-5.4	WINESBURG J. MICHAEL	IA
6-T10-2	WILD LIFE LEAGUE OF OHIO CO	LA
6-TS-6	DAVIS JOHN R JR & ADA I	AK.
6-T5-2.3	DAVIS JOHN RICHARD & ADA I	AL
6-T5-2.1	DAVIS JOHN RICHARD JR, & ADA I	MA
6-T5-2.2	GIVENS HERSCHELL, & JONES DOROTHY S.	AN
6.75-1	WEST VIRGINIA DIVISION OF NATURAL RESOURCES	OA
3-114-29	WEST VIRGINIA DEPT NAT RES	AP
3-114-38	NIETZELT EDWARD L	DA
3-114-35	ERNEST KELLY MICHAEL	AR
3-114-31.5	ERNEST DEBORAH J	AS
3-114-34	ERNEST DEBORAHJ	TA
3-114-31.1	TULLY JAMES M & VERONICA	UA
3-L14-31.4	TULLYJAMES M	VA
	TULLY JAMES M & VERONICA	WA
3-114-31.2	TUNNEL RIDGE, LLC	XA
3-114-39	NUNES ANDREW J	YA
3-(11-48.9	MARKING JOHN E & TINA J	AZ
3-111-48.3	OHIO RIVER COLLIERIES COMPANY (LOTS 182)	AB
3-111-46.3	MOORE SCOTT E & LEAH (LOTS 3&5)	88
3-111-46.10		BC BC
3-111-48.13	TUNNEL RIDGE LLC	08
3-111-48.6	TUNNEL RIDGE LLC	
3-111-46.17	TUNNEL RIDGE LLC (LOTS 21-238.25)	38
3 111-46	HOMESTEAD FARMS LLC (LOTS 6-11&16-20)	8F
3-111-46.7	TUNNEL RIDGE, LLC	86
3-114-53	HENDERSON DENNIS C & MURPHY PATRICIA A	BH
3-1.14-51	TUNNEL RIDGE LLC	81
3-114-52.1	TUNNELRIDGE LLC	8.1
3-114-49	DEAN LAWRENCE LIL & JANET S	ВК
3-114-21	WATSON GARY L	18
3-114-22	HEINRICH EARNEST J. III & ANGELA R.	MB
3-111-55.1	WATSON GARY!	NB
3-111-55.2	WEASE DUANNEL & RHONDA L	08
3-111-49	DAVIS DONNA EVANS & WEASE RHONDA EVANS	98
3-(11-53	ROTTER C1 & GRACE A	BQ
3-(11-52	ROTTER CJ & GRACE A	ВВ
3-111-50	DAVIS DONNA E & DANIEL B	28
3-111-49.2	DAVIS DONNA EVANS & DANIEL R	TB
3-111-64	ROTTER CARLI & GRACE A	US
3-111-46.22	SCHMIDT TODD R	V8
6-75-5	DAVIS DEBRA L	WE

				03/11/2022
SVO EmvY+®		SWN	COMPANY:	REVISIONS:
DATE: 10-22-2020 API NO: 47-069-XXXXX DRAWN BY:R. GRIMES	ER OHI	CARL ROTT	OPERATOR'S WELL #: 47-061-	
SCALE: N/A DRAWING NO:2018-0153 WELL LOCATION PLAT	STATE:	COUNTY: OHIO	DISTRICT: LIBERTY	

TAX PARCEL

WW-6A1 (5/13)

Operator's Well No.	Carl Rotter OHI 10H
---------------------	---------------------

# INFORMATION SUPPLIED UNDER WEST VIRGINIA CODE Chapter 22, Article 6A, Section 5(a)(5) IN LIEU OF FILING LEASE(S) AND OTHER CONTINUING CONTRACT(S)

Under the oath required to make the verification on page 1 of this Notice and Application, I depose and say that I am the person who signed the Notice and Application for the Applicant, and that –

- (1) the tract of land is the same tract described in this Application, partly or wholly depicted in the accompanying plat, and described in the Construction and Reclamation Plan;
- (2) the parties and recordation data (if recorded) for lease(s) or other continuing contract(s) by which the Applicant claims the right to extract, produce or market the oil or gas are as follows:

Lease Name or Number

Grantor, Lessor, etc.

Grantee, Lessee, etc.

Royalty

Book/Page

See Exhibit

RECEIVED
Office of Oil and Gas

NOV 1 3 2020

WV Department of Environmental Protection

# Acknowledgement of Possible Permitting/Approval In Addition to the Office of Oil and Gas

The permit applicant for the proposed well work addressed in this application hereby acknowledges the possibility of the need for permits and/or approvals from local, state, or federal entities in addition to the DEP, Office of Oil and Gas, including but not limited to the following:

- WV Division of Water and Waste Management
- WV Division of Natural Resources WV Division of Highways
- U.S. Army Corps of Engineers
- U.S. Fish and Wildlife Service
- County Floodplain Coordinator

The applicant further acknowledges that any Office of Oil and Gas permit in no way overrides, replaces, or nullifies the need for other permits/approvals that may be necessary and further affirms that all needed permits/approvals should be acquired from the appropriate authority before the affected activity is initiated.

Well Operator: SWN Production Company, LLC.

By:

Senior Landman

Page 1 of

**EXHIBIT "A"** 

Attached to and made a part of the State of West Virginia Oil and Gas Permit Form, WW-6A1, by SWN Production Company, LLC, Operator
Carl Rotter OHI 10H
Ohio County, West Virginia

#	ТМР	LESSOR	LESSEE	ROYALTY	BK/PG
1)	3-L11-54	Carl J. and Grace A. Rotter, husband and wife	Chesapeake Appalachia, L.L.C.	12.50%	791/16
			SWN Production Company, LLC		885/248
2)	3-L11-60.1	Lloyd A. Klages and Bertha L. Klages, his wife	Great Lakes Energy Partners, L.L.C.	12.50%	778/278
			Chesapeake Appalachia, L.L.C.		808/521
			SWN Production Company, LLC		883/515
3)	Realtree Rd FKA Trestlework Rogers	West Virginia Department of Transportation, Division of Highways	SWN Production Company, LLC	20.00%	986/226
	Rd. AKA Rogers Road				
4)	3-L11-46.18	Lloyd A. Klages and Bertha L. Klages, his wife	Great Lakes Energy Partners, L.L.C.	12.50%	778/278
			Chesapeake Appalachia, L.L.C.		808/521
			SWN Production Company, LLC		883/515
5)	3-L11-46.20	Lloyd A. Klages and Bertha L. Klages, his wife	Great Lakes Energy Partners, L.L.C.	12.50%	778/278
<i>\</i>			Chesapeake Appalachia, L.L.C.		808/521
			SWN Production Company, LLC		883/515
6)	3-L11-46.9	Lloyd A. Klages and Bertha L. Klages, his wife	Great Lakes Energy Partners, L.L.C.	12.50%	778/278
1		, ,	Chesapeake Appalachia, L.L.C.		808/521
ľ			SWN Production Company, LLC		883/515
7)	3-L11-46.11	Lloyd A. Klages and Bertha L. Klages, his wife	Great Lakes Energy Partners, L.L.C.	12.50%	778/278
1		, ,	Chesapeake Appalachia, L.L.C.		808/521
			SWN Production Company, LLC		883/515
8)	3-L11-46.13	Lloyd A. Klages and Bertha L. Klages, his wife	Great Lakes Energy Partners, L.L.C.	12.50%	778/278
		, ,	Chesapeake Appalachia, L.L.C.		808/521
			SWN Production Company, LLC		883/515

Ohio County, West Virginia

9)	3-L11-46.8	Lloyd A. Klages and Bertha L. Klages, his wife	Great Lakes Energy Partners, L.L.C.	12.50%	778/278
'			Chesapeake Appalachia, L.L.C.		808/521
			SWN Production Company, LLC		883/515
10)	3-L11-48.4	Jonathan T. Greer and Stacy J. Greer, husband and wife	Chesapeake Appalachia, L.L.C.	18.00%	868/104
			SWN Production Company, LLC		883/778
11)	3-L11-48.5	The Nancy A. Rasor Separate Property Trust Dated January 1,	SWN Production Company, LLC	18.00%	990/573
		2003, as Amended October 15, 2014			
12)	3-L11-48.2	Nancy A. Rasor Separate Property Trust dtd January 1, 2003,	SWN Production Company, LLC	18.00%	936/224
		Amended October 15, 2014			
13)	3-L14-54	William R. White and Doris R. White, husband and wife	Chesapeake Appalachia, L.L.C.	14.00%	857/209
			SWN Production Company, LLC		883/754
14)	3-L15-1.1	Frances L. Hall, a widow (Life Estate Interest), Robert H. Hall and	Chesapeake Appalachia, L.L.C.	18.00%	817/638
		Laura L. Hall, husband and wife (Remainder Interest), David Lee	SWN Production Company, LLC		885/548
		Hall and Sandra Sue Hall, husband and wife (Remainder Interest)	,		
		Mary Pasco and Thomas P. Pasco, wife and husband (Remainder			
		Interest)			
15)	3-L15-1.2	Brenton R. Wood and Kelly S. Wood, husband and wife	SWN Production Company, LLC	16.00%	931/138
16)	170	Brenton R. Wood and Kelly S. Wood, husband and wife	SWN Production Company, LLC	16.00%	931/138
					•
		Joseph F. Pagendarm and Patricia M. Pagendarm, husband and	TriEnergy, Inc.	12.50%	788/687
		wife	TriEnergy Holdings, LLC		791/171
			Chesapeake Appalachia, L.L.C.		798/653
			SWN Production Company, LLC		885/272

RECEIVED Office of Oil and Gas

Ohio County, West Virginia

17)	3-L15-2.2	Joseph F. Pagendarm and Patricia M. Pagendarm, husband and	TriEnergy, Inc.	12.50%	788/687
'	<b>-</b>	wife	TriEnergy Holdings, LLC		791/171
			Chesapeake Appalachia, L.L.C.		798/653
			SWN Production Company, LLC		885/272
18)	3-L15-2.4	Sally A. Morgan, single	American Petroleum Partners	19.00%	935/286
·			Operating, LLC		
			SWN Production Company, LLC		980/572
19)	3-L15-2.8	Sally A. Morgan, single	American Petroleum Partners	19.00%	935/286
			Operating, LLC		
			SWN Production Company, LLC		980/572
20)	6-T5-2	State of West Virginia, Department of Commerce, Division of	SWN Production Company, LLC	15.00%	974/449
		Natural Resources			
21)	6-T10-1	John Richard Davis Jr. and Ada I. Davis, husband and wife	American Petroleum Partners	19.00%	936/149
			Operating, LLC		
			SWN Production Company, LLC		980/572
		Debra L. Davis, a widow	American Petroleum Partners	19.00%	935/274
			Operating, LLC		
			SWN Production Company, LLC		980/572
		Joseph David Davis and D'Arcy B. Davis, husband and wife	American Petroleum Partners	19.00%	936/168
			Operating, LLC		
			SWN Production Company, LLC		980/572
22)	6-T10-4	Patricia A. Clark, a single woman	Chesapeake Appalachia, L.L.C.	18.00%	822/512
		i	SWN Production Company, LLC		885/105
23)	6-T10-4.1	Donnie L. Horr and Michelle Horr, husband and wife	American Petroleum Partners	19.00%	935/282
•			Operating, LLC		
			SWN Production Company, LLC		980/572





SWN Production Company, LLC 1300 Fort Pierpont Dr, Ste 201 Morgantown, WV 26508 Tel: 304 884 1610 Fax: 304 471 2497 www.swn.com

November 2, 2020

Ms. Laura Adkins WV DEP Office of Oil & Gas 601 57<sup>th</sup> St., SE Charleston, WV 25304

RE: SWN's proposed New Well: Carl Rotter OHI 10H in Ohio County, West Virginia, Drilling under Trestleworks Rogers Road, Interstate 70, Stoolfire-West Alexander Road, Bear Rock Road, and Parks Road.

Dear Ms. Adkins:

SWN Production Company, LLC ("SWN") is applying for a drilling permit for the above referenced well. The State of West Virginia has raised some concern as to SWN's right to drill under Trestleworks Rogers Road, Interstate 70, Stoolfire-West Alexander Road, Bear Rock Road, and Parks Road. Please be advised that SWN has leased all mineral owners under said route as it relates to the above-referenced well and unit.

Thank you.

Sincerely,

Bradley Wilson Senior Landman

SWN Production Company, LLC

RECEIVED
Office of Oil and Gas

NOV 1 3 2020

WV Department of Environmental Protection

R2 W+°

The Right People doing the Right Things, wisely investing the cash inpurfrom our underlying assets, will oreste value.

# STATE OF WEST VIRGINIA DEPARTMENT OF ENVIRONMENTAL PROTECTION, OFFICE OF OIL AND GAS NOTICE CERTIFICATION

Date of Notic	ce Certification:			No. 4		
					Well No. Carl	
			Wel	Pad I	Name: Carl Rot	ter OHI
Notice has	been given:					the root of the Au
		ode §	22-6A, the Operator has provided	the red	quired parties v	with the Notice Forms listed
	tract of land as follows:		77		538993.29	
State:	West Virginia 069-Ohio		UTM NAD 83 East	ing: thing:	4439129.00	
County: District:	Liberty	-	Public Road Access:	unng.	Rogers Road	
Quadrangle:	Valley Grove		Generally used farm n	ame:	Carl Rotter	
Watershed:	Upper Ohio South					
it has provid information rof giving the requirements Virginia Cod of this article  Pursuant to that the Ope	ed the owners of the surface de required by subsections (b) and (c) surface owner notice of entry of of subsection (b), section sixte e § 22-6A-11(b), the applicant shave been completed by the app West Virginia Code § 22-6A, the erator has properly served the reconstruction.	escrib c), se to su en of hall te dican	erator has attached proof to this N	t), sub- t the re- ection ing by cretary	section (b), sec equirement was ten of this arti the surface ov that the notice	ction ten of this article, the deemed satisfied as a result cle six-a; or (iii) the notice wher; and Pursuant to West requirements of section ten
*PLEASE CH	ECK ALL THAT APPLY					ONLY
□ 1. NO	TICE OF SEISMIC ACTIVITY	or	■ NOTICE NOT REQUIRED SEISMIC ACTIVITY WAS CO			☐ RECEIVED/ NOT REQUIRED
■ 2. NO	TICE OF ENTRY FOR PLAT S	URV	EY or D NO PLAT SURVEY V	VAS C	ONDUCTED	☑ RECEIVED
■ 3. NO	TICE OF INTENT TO DRILL	Of	☐ NOTICE NOT REQUIRED NOTICE OF ENTRY FOR PLATWAS CONDUCTED or			RECEIVED/ NOT REQUIRED
			☐ WRITTEN WAIVER BY S (PLEASE ATTACH)	URFA	CE OWNER	
■ 4. NO	TICE OF PLANNED OPERATI	ON			6.1	RECEIVED
■ 5. PUI	BLIC NOTICE					RECEIVED
■ 6. NO	TICE OF APPLICATION					RECEIVED

Required Attachments:

The Operator shall attach to this Notice Certification Form all Notice Forms and Certifications of Notice that have been provided to the required parties and/or any associated written waivers. For the Public Notice, the operator shall attach a copy of the Class II Legal Advertisement with publication date verification or the associated Affidavit of Publication. The attached Notice Forms and Certifications of Notice shall serve as proof that the required parties have been noticed as required under West Virginia Code § 22-6A. Pursuant to West Virginia Code § 22-6A-11(b), the Certification of Notice to the person may be made by affidavit of presonal service, the return receipt card or other postal receipt for certified mailing.

NOV 1 3 2020



# Certification of Notice is hereby given:

THEREFORE, I Britany Woody , have read and understand the notice requirements within West Virginia Code § 22-6A. I certify that as required under West Virginia Code § 22-6A, I have served the attached copies of the Notice Forms, identified above, to the required parties through personal service, by registered mail or by any method of delivery that requires a receipt or signature confirmation. I certify under penalty of law that I have personally examined and am familiar with the information submitted in this Notice Certification and all attachments, and that based on my inquiry of those individuals immediately responsible for obtaining the information, I believe that the information is true, accurate and complete. I am aware that there are significant penalties for submitting false information, including the possibility of fine and imprisonment.

Well Operator: SW

SWN Production Co., LLC

Brittany Woody

Telephone:

Its:

Senior Regulatory Analyst

AP) ALI SEA

304-884-1610

√ Address:

1300 Fort Pierpont Dr., Suite 201

Morgantown, WV 26508

Facsimile: 304-884-1690

Email: Brittany\_Woody@swn.com

Subscribed and sworn before me this

day of September, 206

My Commission Expires

7-24-25

Oil and Gas Privacy Notice:

The Office of Oil and Gas processes your personal information, such as name, address and telephone number, as part of our regulatory duties. Your personal information may be disclosed to other State agencies or third parties in the normal course of business or as needed to comply with statutory or regulatory requirements, including Freedom of Information Act requests. Our office will appropriately secure your personal information. If you have any questions about our use or your personal information, please contact DEP's Chief Privacy Officer at departs expeditionally agents.

RECEIVED
Office of Oil and Gas

NOV 1 3 2020

# API NO. 47-4097 0 6 9 0 0 3 2 8 OPERATOR WELL NO. Carl Rotter OHI 10H Well Pad Name: Carl Rotter OHI

# STATE OF WEST VIRGINIA DEPARTMENT OF ENVIRONMENTAL PROTECTION, OFFICE OF OIL AND GAS NOTICE OF APPLICATION

Notice Time Requir	rement: notice shall be prov	ided no later than the filing date of permit application.
111	1	11/12
Date of Notice:	Date Permit Applica	ition Filed: 1110
Notice of:		
PERMIT FOR .	ANY D CERTIE	ICATE OF APPROVAL FOR THE
WELL WORK	CONST	RUCTION OF AN IMPOUNDMENT OR PIT
Delivery method pu	rsuant to West Virginia C	ode § 22-6A-10(b)
☐ PERSONAL	☑ REGISTERED	☐ METHOD OF DELIVERY THAT REQUIRES A
SERVICE	MAIL	RECEIPT OR SIGNATURE CONFIRMATION
the surface of the trace oil and gas leasehold described in the erosic operator or lessee, in a more coal seams; (4) well work, if the surfaint impoundment or pit as have a water well, spr provide water for comproposed well work as subsection (b) of this records of the sheriff provision of this article Code R. § 35-8-5,7.a.	ton which the well is or is probeing developed by the proportion and sediment control plan the event the tract of land on The owners of record of the size tract is to be used for the passes described in section nine of ing or water supply source lost sumption by humans or dome ctivity is to take place. (c)(1) section hold interests in the larequired to be maintained purelet to the contrary, notice to a requires, in part, that the open	this article, and the well plat to each of the following persons: (1) The owners of record of oposed to be located; (2) The owners of record of the surface tract or tracts overlying the sed well work, if the surface tract is to be used for roads or other land disturbance as submitted pursuant to subsection (c), section seven of this article; (3) The coal owner, which the well proposed to be drilled is located [sic] is known to be underlain by one or urface tract or tracts overlying the oil and gas leasehold being developed by the proposed olacement, construction, enlargement, alteration, repair, removal or abandonment of any this article; (5) Any surface owner or water purveyor who is known to the applicant to cated within one thousand five hundred feet of the center of the well pad which is used to estic animals; and (6) The operator of any natural gas storage field within which the lift more than three tenants in common or other co-owners of interests described in ands, the applicant may serve the documents required upon the person described in the suant to section eight, article one, chapter eleven-a of this code. (2) Notwithstanding any lien holder is not notice to a landowner, unless the lien holder is the landowner. W. Va. rator shall also provided the Well Site Safety Plan ("WSSP") to the surface owner and any and water testing as provided in section 15 of this rule.
		&S Plan Notice  Well Plat Notice is hereby provided to:
SURFACE OWNE	ER(s)	Z COAL OWNER OR LESSEE
Name: Carl J. & Grace A.		Name: Tunnel Ridge- Alliance Resources GP LLC
Address: 2 Melrose Dr		Address: 2596 Battle Run Road
Chillicothe, OH 45601		Triadelphia, WV 26059
Name:		☐ COAL OPERATOR
Address:		Name:
**************************************		Address:
	ER(s) (Road and/or Other D	
Name:		SURFACE OWNER OF WATER WELL
Address:		Addicss.
11ddi 055.		☐ OPERATOR OF ANY NATURAL GAS STORAGE FIELD
SURFACE OWNE	ER(s) (Impoundments or Pit	Name:
Name:		Address: RECEIVED
		*Please attach additional forms if necessary
		*Please attach additional forms if necessary  NOV 1 3 2020

WV Department of Environmental Procession 03/11/2022

# API NO. 4/4067 0 6 9 0 0 3 2 8 OPERATOR WELL NO. Carl Rotter OHI 10H Well Pad Name: Carl Rotter OHI

# STATE OF WEST VIRGINIA DEPARTMENT OF ENVIRONMENTAL PROTECTION, OFFICE OF OIL AND GAS NOTICE OF APPLICATION

Notice Time Requirement: notice shall be provided no later the	nan the filing date of permit application.
Date of Notice: Date Permit Application Filed:	// <i>y</i>
PERMIT FOR ANY CERTIFICATE OF AF	
WELL WORK CONSTRUCTION OF	AN IMPOUNDMENT OR PIT
Delivery method pursuant to West Virginia Code § 22-6A-1	10(b)
☐ PERSONAL ☑ REGISTERED ☐ MET	HOD OF DELIVERY THAT REQUIRES A
	EIPT OR SIGNATURE CONFIRMATION
	te of the application, the applicant for a permit for any well work or for a
registered mail or by any method of delivery that requires a receipt sediment control plan required by section seven of this article, and the surface of the tract on which the well is or is proposed to be lo oil and gas leasehold being developed by the proposed well work, described in the erosion and sediment control plan submitted pursoperator or lessee, in the event the tract of land on which the well more coal seams; (4) The owners of record of the surface tract or twell work, if the surface tract is to be used for the placement, consimpoundment or pit as described in section nine of this article; (5) have a water well, spring or water supply source located within on provide water for consumption by humans or domestic animals; at proposed well work activity is to take place. (c)(1) If more than the subsection (b) of this section hold interests in the lands, the applic records of the sheriff required to be maintained pursuant to section provision of this article to the contrary, notice to a lien holder is not activity and the section of the section hold in the contrary.	pit as required by this article shall deliver, by personal service or by tor signature confirmation, copies of the application, the erosion and the well plat to each of the following persons: (1) The owners of record of cated; (2) The owners of record of the surface tract or tracts overlying the if the surface tract is to be used for roads or other land disturbance as uant to subsection (c), section seven of this article; (3) The coal owner, proposed to be drilled is located [sic] is known to be underlain by one or tracts overlying the oil and gas leasehold being developed by the proposed struction, enlargement, alteration, repair, removal or abandonment of any Any surface owner or water purveyor who is known to the applicant to be thousand five hundred feet of the center of the well pad which is used to all (6) The operator of any natural gas storage field within which the rece tenants in common or other co-owners of interests described in ant may serve the documents required upon the person described in the neight, article one, chapter eleven-a of this code. (2) Notwithstanding any of notice to a landowner, unless the lien holder is the landowner. W. Va. provide the Well Site Safety Plan ("WSSP") to the surface owner and any g as provided in section 15 of this rule.
☐ Application Notice ☐ WSSP Notice ☐ E&S Plan Notice	ee  Well Plat Notice is hereby provided to:
□ SURFACE OWNER(s)	☑ COAL OWNER OR LESSEE
Name:	Name: The Kathleen S. Craft Foundation & The Joseph W. Craft III Foundation
Address:	Address: 2502 E. 45th St.
Nama	Tulsa, OK 74105-5147
Name:Address:	COAL OPERATOR
Auditos.	Name: Address:
SURFACE OWNER(s) (Road and/or Other Disturbance)	i waters.
Name:	SURFACE OWNER OF WATER WELL
Address:	AND/OR WATER PURVEYOR(s)
	Name:
Name:	Address:
Address:	Land of the second seco
	☐ OPERATOR OF ANY NATURAL GAS STORAGE FIELD
SURFACE OWNER(s) (Impoundments or Pits)	Name:
Name:Address:	Address:
	*Places attack additional Committee
	*Please attach additional forms if necessary Office of Oil and Gas

NOV 1 3 2020



WW-6A (8-13) 4706900328

OPERATOR WELL NO. Carl Rotter OHI 10H
Well Pad Name: Carl Rotter OHI

Notice is hereby given:

Pursuant to West Virginia Code § 22-6A-10(b), notice is hereby given that the undersigned well operator has applied for a permit for well work or for a certificate of approval for the construction of an impoundment or pit.

### This Notice Shall Include:

Pursuant to W. Va. Code § 22-6A-10(b), this notice shall include: (1) copies of the application; (2) the erosion and sediment control plan required by section seven of this article; and (3) the well plat.

Pursuant to W. Va. Code § 22-6A-10(f), this notice shall include: (1) a statement of the time limits for filing written comments; (2) who may file written comments; (3) the name and address of the secretary for the purpose of filing the comments and obtaining additional information; and (4) a statement that the persons may request, at the time of submitting written comments, notice of the permit decision and a list of persons qualified to test water.

Pursuant to W. Va. Code R. § 35-8-5.7 a, the operator shall provide the Well Site Safety Plan to the surface owner and any water purveyor or surface owner subject to notice and water testing as provided in section 15 of this rule.

Pursuant to W. Va. Code R. § 35-8-15,2.c, this notice shall: (1) contain a statement of the surface owner's and water purveyor's right to request sampling and analysis; (2) advise the surface owner and water purveyor of the rebuttable presumption for contamination or deprivation of a fresh water source or supply; advise the surface owner and water purveyor that refusal to allow the operator to conduct a pre-drilling water well test constitutes a method to rebut the presumption of liability; (3) advise the surface owner and water purveyor of his or her independent right to sample and analyze any water supply at his or her own expense; advise the surface owner and water purveyor whether or not the operator will utilize an independent laboratory to analyze any sample; and (4) advise the surface owner and or water purveyor that he or she can obtain from the Chief a list of water testing laboratories in the subject area capable of and qualified to test water supplies in accordance with standard acceptable methods.

Additional information related to horizontal drilling may be obtained from the Secretary, at the WV Department of Environmental Protection headquarters, located at 601 57th Street, SE, Charleston, WV 25304 (304-926-0450) or by visiting <a href="https://www.dep.wv.gov/oil-and-gas/pages/default.aspx">www.dep.wv.gov/oil-and-gas/pages/default.aspx</a>.

### Well Location Restrictions

Pursuant to W. Va. Code § 22-6A-12, Wells may not be drilled within two hundred fifty feet measured horizontally from any existing water well or developed spring used for human or domestic animal consumption. The center of well pads may not be located within six hundred twenty-five feet of an occupied dwelling structure, or a building two thousand five hundred square feet or larger used to house or shelter dairy cattle or poultry husbandry. This limitation is applicable to those wells, developed springs, dwellings or agricultural buildings that existed on the date a notice to the surface owner of planned entry for surveying or staking as provided in section ten of this article or a notice of intent to drill a horizontal well as provided in subsection (b), section sixteen of this article was provided, whichever occurs first, and to any dwelling under construction prior to that date. This limitation may be waived by written consent of the surface owner transmitted to the department and recorded in the real property records maintained by the clerk of the county commission for the county in which such property is located. Furthermore, the well operator may be granted a variance by the secretary from these distance restrictions upon submission of a plan which identifies the sufficient measures, facilities or practices to be employed during well site construction, drilling and operations. The variance, if granted, shall include terms and conditions the department requires to ensure the safety and protection of affected persons and property. The terms and conditions may include insurance, bonding and indemnification, as well as technical requirements. (b) No well pad may be prepared or well drilled within one hundred feet measured horizontally from any perennial stream, natural or artificial lake, pond or reservoir, or a wetland, or within three hundred feet of a naturally reproducing trout stream. No well pad may be located within one thousand feet of a surface or ground water intake of a public water supply. The distance from the public water supply as identified by the department shall be measured as follows: (1) For a surface water intake on a lake or reservoir, the distance shall be measured from the boundary of the lake or reservoir. (2) For a surface water intake on a flowing stream, the distance shall be measured from a semicircular radius extending upstream of the surface water intake. (3) For a groundwater source, the distance shall be measured from the wellhead or spring. The department may, in its discretion, waive these distance restrictions upon submission of a plan identifying sufficient measures, facilities or practices to be employed during well site construction, drilling and operations to protect the waters of the state. A waiver, if granted, shall impose any permit conditions as the secretary considers necessary. (c) Notwithstanding the foregoing provisions of this section, nothing contained in this section prevents an operator from conducting the activities permitted or authorized by a Clean Water Act Section 404 permit or other approval from the United States Army Corps of Engineers within any waters of the state or within the restricted areas referenced in this section. (d) The well location restrictions set forth in this section shall not apply to any well on a multiple well pad if the least one of the wells was permitted prior to the effective date of this article. (e) The secretary shall, by December 31, 20 figure port to the Legislature on the noise, light, dust and volatile organic compounds generated by the drilling of horizontal wells as they relate to the well location restrictions regarding occupied dwelling structures pursuant to this section. Upon a finding, if any, by Welke regarding that the well location restrictions regarding occupied dwelling structures are inadequate or otherwise require alteration to address the items



WW-6A (8-13)

Well Pad Name: Carl Rotter OHI

examined in the study required by this subsection, the secretary shall have the authority to propose for promulgation legislative rules establishing guidelines and procedures regarding reasonable levels of noise, light, dust and volatile organic compounds relating to drilling horizontal wells, including reasonable means of mitigating such factors, if necessary.

# Water Well Testing:

Pursuant to West Virginia Code § 22-6A-10(d), notification shall be made, with respect to surface landowners identified in subsection (b) or water purveyors identified in subdivision (5), subsection (b) of this section, of the opportunity for testing their water well. The operator shall provide an analysis to such surface landowner or water purveyor at their request.

# Water Testing Laboratories:

Pursuant to West Virginia Code § 22-6A-10(i), persons entitled to notice pursuant to subsection (b) of this section may contact the department to ascertain the names and locations of water testing laboratories in the subject area capable and qualified to test water supplies in accordance with standard accepted methods. In compiling that list of names the department shall consult with the state Bureau for Public Health and local health departments. A surface owner and water purveyor has an independent right to sample and analyze any water supply at his or her own expense. The laboratory utilized by the operator shall be approved by the agency as being certified and capable of performing sample analyses in accordance with this section.

# Rebuttable Presumption for Contamination or Deprivation of a Fresh Water Source or Supply:

W. Va. Code § 22-6A-18 requires that (b) unless rebutted by one of the defenses established in subsection (c) of this section, in any action for contamination or deprivation of a fresh water source or supply within one thousand five hundred feet of the center of the well pad for horizontal well, there is a rebuttable presumption that the drilling and the oil or gas well or either was the proximate cause of the contamination or deprivation of the fresh water source or supply. (c) In order to rebut the presumption of liability established in subsection (b) of this section, the operator must prove by a preponderance of the evidence one of the following defenses: (1) The pollution existed prior to the drilling or alteration activity as determined by a predrilling or prealteration water well test. (2) The landowner or water purveyor refused to allow the operator access to the property to conduct a predrilling or prealteration water well test. (3) The water supply is not within one thousand five hundred feet of the well. (4) The pollution occurred more than six months after completion of drilling or alteration activities. (5) The pollution occurred as the result of some cause other than the drilling or alteration activity. (d) Any operator electing to preserve its defenses under subdivision (1), subsection (c) of this section shall retain the services of an independent certified laboratory to conduct the predrilling or prealteration water well test. A copy of the results of the test shall be submitted to the department and the surface owner or water purveyor in a manner prescribed by the secretary. (e) Any operator shall replace the water supply of an owner of interest in real property who obtains all or part of that owner's supply of water for domestic, agricultural, industrial or other legitimate use from an underground or surface source with a comparable water supply where the secretary determines that the water supply has been affected by contamination, diminution or interruption proximately caused by the oil or gas operation, unless waived in writing by that owner. (f) The secretary may order the operator conducting the oil or gas operation to: (1) Provide an emergency drinking water supply within twenty-four hours; (2) Provide temporary water supply within seventy-two hours; (3) Within thirty days begin activities to establish a permanent water supply or submit a proposal to the secretary outlining the measures and timetables to be used in establishing a permanent supply. The total time in providing a permanent water supply may not exceed two years. If the operator demonstrates that providing a permanent replacement water supply cannot be completed within two years, the secretary may extend the time frame on case-by-case basis; and (4) Pay all reasonable costs incurred by the real property owner in securing a water supply. (g) A person as described in subsection (b) of this section aggrieved under the provisions of subsections (b), (e) or (f) of this section may seek relief in court... (i) Notwithstanding the denial of the operator of responsibility for the damage to the real property owner's water supply or the status of any appeal on determination of liability for the damage to the real property owner's water supply, the operator may not discontinue providing the required water service until authorized to do so by the secretary or a court of competent jurisdiction.

### Written Comment:

Pursuant to West Virginia Code § 22-6A-11(a), all persons described in subsection (b), section ten of this article may file written comments with the secretary as to the location or construction of the applicant's proposed well work within thirty days after the application is filed with the secretary. All persons described in West Virginia Code § 22-6A-10(b) may file written comments as to the location or construction of the applicant's proposed well work to the Secretary at:

Chief, Office of Oil and Gas Department of Environmental Protection 601 57<sup>th</sup> St. SE Charleston, WV 25304

RECEIVED Office of Oil and Gas

(304) 926-0450

Such persons may request, at the time of submitting written comments, notice of the permit decision and a list of persons qualified to 2020



WW-6A (8-13) API NO. 47-009 6 9 0 0 3 2 8
OPERATOR WELL NO. Carl Rotter OHI 10H
Well Pad Name: Carl Rotter OHI

# Time Limits and Methods for Filing Comments.

The law requires these materials to be served on or before the date the operator files its Application. You have THIRTY (30) DAYS after the filing date to file your comments. Comments must be filed in person or received in the mail by the Chief's office by the time stated above. You may call the Chief's office to be sure of the date. Check with your postmaster to ensure adequate delivery time or to arrange special expedited handling. If you have been contacted by the well operator and you have signed a "voluntary statement of no objection" to the planned work described in these materials, then the permit may be issued at any time.

Pursuant to West Virginia Code § 22-6A-11(c)(2), Any objections of the affected coal operators and coal seam owners and lessees shall be addressed through the processes and procedures that exist under sections fifteen, seventeen and forty, article six of this chapter, as applicable and as incorporated into this article by section five of this article. The written comments filed by the parties entitled to notice under subdivisions (1), (2), (4), (5) and (6), subsection (b), section ten of this article shall be considered by the secretary in the permit issuance process, but the parties are not entitled to participate in the processes and proceedings that exist under sections fifteen, seventeen or forty, article six of this chapter, as applicable and as incorporated into this article by section five of this article.

# Comment Requirements

Your comments must be in writing and include your name, address and telephone number, the well operator's name and well number and the approximate location of the proposed well site including district and county from the application. You may add other documents, such as sketches, maps or photographs to support your comments.

Disclaimer: All comments received will be placed on our web site <a href="http://www.dep.wv.gov/oil-and-gas/Horizontal-Permits/Pages/default.aspx">http://www.dep.wv.gov/oil-and-gas/Horizontal-Permits/Pages/default.aspx</a> and the applicant will automatically be forwarded an email notice that such comments have been submitted. The applicant will be expected to provide a response to comments submitted by any surface owner, water purveyor or natural gas storage operator noticed within the application.

# Permit Denial or Condition

The Chief has the power to deny or condition a well work permit. Pursuant to West Virginia Code § 22-6A-8(d), the permit may not be issued or be conditioned, including conditions with respect to the location of the well and access roads prior to issuance if the director determines that:

- (1) The proposed well work will constitute a hazard to the safety of persons;
- (2) The plan for soil erosion and sediment control is not adequate or effective;
- (3) Damage would occur to publicly owned lands or resources; or
- (4) The proposed well work fails to protect fresh water sources or supplies.

A permit may also be denied under West Virginia Code § 22-6A-7(k), the secretary shall deny the issuance of a permit if the secretary determines that the applicant has committed a substantial violation of a previously issued permit for a horizontal well, including the applicable erosion and sediment control plan associated with the previously issued permit, or a substantial violation of one or more of the rules promulgated under this article, and in each instance has failed to abate or seek review of the violation within the time prescribed by the secretary pursuant to the provisions of subdivisions (1) and (2), subsection (a), section five of this article and the rules promulgated hereunder, which time may not be unreasonable.

Pursuant to West Virginia Code § 22-6A-10(g), any person entitled to submit written comments to the secretary pursuant to subsection (a), section eleven of this article, shall also be entitled to receive from the secretary a copy of the permit as issued or a copy of the order modifying or denying the permit if the person requests receipt of them as a part of the written comments submitted concerning the permit application. Such persons may request, at the time of submitting written comments, notice of the permit decision and a list of persons qualified to test water.

RECEIVED
Office of Oil and Gas
NOV 1 3 2020

WV Department of Environmental Portago

WW-6A (8-13)

API NO. 47-009 OPERATOR WELL NO. Carl Rotter OHI 10H
Well Pad Name: Carl Rotter OHI

Notice is hereby given by:

Well Operator: SWN Production Co., LLC

Telephone: 304-884-1610

Email: Brittany\_Woody@swn.com

Address: 1300 Fort Pierpont Dr., Suite 201
Morgantown, WV 26508

Facsimile: 304-884-1690

Oil and Gas Privacy Notice:

The Office of Oil and Gas processes your personal information, such as name, address and telephone number, as part of our regulatory duties. Your personal information may be disclosed to other State agencies or third parties in the normal course of business or as needed to comply with statutory or regulatory requirements, including Freedom of Information Act requests. Our office will appropriately secure your personal information. If you have any questions about our use or your personal information, please contact DEP's Chief Privacy Officer at departments.



Subscribed and sworn before me this 28 day of 2020.

Subscribed and sworn before me this 28 day of 2020.

Notary Public 1-24-25

RECEIVED
Office of Oil and Gas

NOV 1 3 2020



WW-6A3 (1/12)

# STATE OF WEST VIRGINIA DEPARTMENT OF ENVIRONMENTAL PROTECTION, OFFICE OF OIL AND GAS NOTICE OF ENTRY FOR PLAT SURVEY

Date of Notice: 9/9/2020  Date of Planned Entry: 9/16/2020  Delivery method pursuant to West Virginia Code § 22-6A-10a  PERSONAL REGISTERED METHOD OF DELIVERY THAT REQUIRES A RECEIPT OR SIGNATURE CONFIRMATION  Pursuant to West Virginia Code § 22-6A-10(a), Prior to filing a permit application, the operator shall provide no no to the surface tract to conduct any plat surveys required pursuant to this article. Such notice shall be provide but no more than forty-five days prior to such entry to: (1) The surface owner of such tract; (2) to any owner or beneath such tract that has filed a declaration pursuant to section thirty-six, article six, chapter twenty-two of the owner of minerals underlying such tract in the county tax records. The notice shall include a statement that con and Sediment Control Manual and the statutes and rules related to oil and gas exploration and production may Secretary, which statement shall include contact information, including the address for a web page on the Secretary to the surface owner to obtain copies from the secretary.  Notice is hereby provided to:	E (45) days prior to
PERSONAL SERVICE  REGISTERED  METHOD OF DELIVERY THAT REQUIRES A RECEIPT OR SIGNATURE CONFIRMATION  Pursuant to West Virginia Code § 22-6A-10(a), Prior to filing a permit application, the operator shall provide non to the surface tract to conduct any plat surveys required pursuant to this article. Such notice shall be provide but no more than forty-five days prior to such entry to: (1) The surface owner of such tract; (2) to any owner or beneath such tract that has filed a declaration pursuant to section thirty-six, article six, chapter twenty-two of the owner of minerals underlying such tract in the county tax records. The notice shall include a statement that county and Sediment Control Manual and the statutes and rules related to oil and gas exploration and production may Secretary, which statement shall include contact information, including the address for a web page on the Secretary.	
Pursuant to West Virginia Code § 22-6A-10(a), Prior to filing a permit application, the operator shall provide non to the surface tract to conduct any plat surveys required pursuant to this article. Such notice shall be provide but no more than forty-five days prior to such entry to: (1) The surface owner of such tract; (2) to any owner or beneath such tract that has filed a declaration pursuant to section thirty-six, article six, chapter twenty-two of the owner of minerals underlying such tract in the county tax records. The notice shall include a statement that column Sediment Control Manual and the statutes and rules related to oil and gas exploration and production may Secretary, which statement shall include contact information, including the address for a web page on the Secretary.	
Pursuant to West Virginia Code § 22-6A-10(a), Prior to filing a permit application, the operator shall provide non to the surface tract to conduct any plat surveys required pursuant to this article. Such notice shall be provide but no more than forty-five days prior to such entry to: (1) The surface owner of such tract; (2) to any owner or beneath such tract that has filed a declaration pursuant to section thirty-six, article six, chapter twenty-two of the owner of minerals underlying such tract in the county tax records. The notice shall include a statement that column Sediment Control Manual and the statutes and rules related to oil and gas exploration and production may Secretary, which statement shall include contact information, including the address for a web page on the Secretary.	
on to the surface tract to conduct any plat surveys required pursuant to this article. Such notice shall be provide but no more than forty-five days prior to such entry to: (1) The surface owner of such tract; (2) to any owner of beneath such tract that has filed a declaration pursuant to section thirty-six, article six, chapter twenty-two of the owner of minerals underlying such tract in the county tax records. The notice shall include a statement that cop and Sediment Control Manual and the statutes and rules related to oil and gas exploration and production may Secretary, which statement shall include contact information, including the address for a web page on the Secretary.	
Notice is hereby provided to:	ed at least seven days r lessee of coal seams his code; and (3) any pies of the state Erosion be obtained from the
	RECEIVED Office of Oil and Gas
■ SURFACE OWNER(s) COAL OWNER OR LESSEE	o hab
Name: Carl J. and Grace A. Rotter Name: Alliance Resources GP LLC Attr: Evan Midler	NOV 1 3 2020
Address: 2 Melrose Dr. Address: 2596 Battle Run Rd.	lan.
Chillicothe, OH 45601 Triadelphia, WV 26059	Environmental Pro-
Name:	Environmental Protection
Name: Carl J. and Grace A. Rotter	
Name: Address: 2 Melrose Dr.	
Address: Chillicothe, OH 45601	
*please attach additional forms if necessary	
Notice is hereby given:  Pursuant to West Virginia Code § 22-6A-10(a), notice is hereby given that the undersigned well operator is plat a plat survey on the tract of land as follows:  State: W Approx. Latitude & Longitude: 40.101501, -80.542	
County: Ohio Public Road Access: Trestlework Rogers	
District: Liberty Watershed: Little Wheeling Cree	ek
Quadrangle: Valley Grove Generally used farm name: Carl Rotter OHI	
Copies of the state Erosion and Sediment Control Manual and the statutes and rules related to oil and gas explorance between the Secretary, at the WV Department of Environmental Protection headquarters, located Charleston, WV 25304 (304-926-0450). Copies of such documents or additional information related to horizon obtained from the Secretary by visiting <a href="https://www.dep.wv.gov/oil-and-gas/pages/default.aspx">www.dep.wv.gov/oil-and-gas/pages/default.aspx</a> .	at 601 57th Street, SE,
Notice is hereby given by:	
Well Operator: SWN PRODUCTION COMPANY, LLC Address: PO BOX 1300	
Telephone: 304-884-1610 JANE LEW, WV 26378	
Email: dee_southall@swn.com or brittany_woody@swn.com Facsimile: 304-884-1690	

# Oil and Gas Privacy Notice:

The Office of Oil and Gas processes your personal information, such as name, address and telephone number, as part of our regulatory duties. Your personal information may be disclosed to other State agencies or third parties in the normal course of business or as needed to comply with statutory or regulatory requirements, including Freedom of Information Act requests. Our office will appropriately secure your personal information. If you have any questions about our use or your personal information, please contact DEP's Chief Privacy Officer at <a href="mailto:depprivacyofficer@wv.gov">depprivacyofficer@wv.gov</a>.

WW-6A3 (1/12) Operator Well No. Carl Rotter OHI

# STATE OF WEST VIRGINIA DEPARTMENT OF ENVIRONMENTAL PROTECTION, OFFICE OF OIL AND GAS NOTICE OF ENTRY FOR PLAT SURVEY

Notice Time R	equirement:	Notice shall be prov	nded at least SEVEN (7) da	lys but no more tha	n FORTY-FIVE (45) days prior to
Date of Notice:	9/9/2020	Date of Plan	nned Entry: 9/16/2020	_	
Delivery metho	od pursuant	to West Virginia C	ode § 22-6A-10a		
☐ PERSONA	AL I	REGISTERED	☐ METHOD OF DE	LIVERY THAT RE	EQUIRES A
SERVICE		MAIL	RECEIPT OR SIG	NATURE CONFIR	RMATION
on to the surface but no more that beneath such tra- owner of minera and Sediment C Secretary, whice enable the surface	te tract to cond in forty-five d act that has fil als underlying Control Manua th statement sl ace owner to co	duct any plat surveys ays prior to such en- led a declaration pur- g such tract in the co- al and the statutes an hall include contact obtain copies from the	s required pursuant to this a try to: (1) The surface owner suant to section thirty-six, a punty tax records. The notion and rules related to oil and gas information, including the a	rticle. Such notice set of such tract; (2) article six, chapter to shall include a state sexploration and p	shall provide notice of planned entry shall be provided at least seven days to any owner or lessee of coal seams wenty-two of this code; and (3) any atement that copies of the state Erosion production may be obtained from the age on the Secretary's web site, to
Notice is hereb		0:		T OUDIED OD I F	anger.
SURFACE Name: Carl J. and Gr	E OWNER(s)	/		LOWNER OR LE	The Joseph W. Craft III Foundation
Address: 2 Melro				2502 E 45th ST	The Joseph VV, Crait III Foundation
Chillicothe, OH 45601			Tulsa, OK 74		
Name:			= -		
			■ MIN	ERAL OWNER(s)	
-				rl J. and Grace A. Rotter	/
Name:			Address:	2 Melrose Dr.	
Address:			Chillicothe, O		
			*please atta	ch additional forms if ne	ecessary
a plat survey on State: V	st Virginia Co the tract of la wv Ohio	ode § 22-6A-10(a), r and as follows:	Approx. Lati	tude & Longitude:	l operator is planning entry to conduct 40.101501, -80.542417 Trestlework Rogers Road
_	Liberty		Watershed:	1.0	Little Wheeling Creek
Quadrangle: v	/alley Grove		Generally us	ed farm name:	Carl Rotter OHI
may be obtained Charleston, WV obtained from the	d from the Se / 25304 (304 he Secretary b	cretary, at the WV I -926-0450). Copies by visiting <u>www.der</u>	Department of Environment of such documents or addi o.wv.gov/oil-and-gas/pages/	al Protection headq tional information r default.aspx.	il and gas exploration and production uarters, located at 600657 of 150, SE, related to horizontal drilling fills be NOV I 3 2020  WV Department of Environmental Pros
Notice is here Well Operator:	SWN PRODUCT	TION COMPANY, LLC	Address:	PO BOX 1300	mental prot
	SWN PRODUCT 304-884-1610	TION COMPANY, LLC	Address:	JANE LEW, WV 26378	OFFICE

Oil and Gas Privacy Notice:

The Office of Oil and Gas processes your personal information, such as name, address and telephone number, as part of our regulatory duties. Your personal information may be disclosed to other State agencies or third parties in the normal course of business or as needed to comply with statutory or regulatory requirements, including Freedom of Information Act requests. Our office will appropriately secure your personal information. If you have any questions about our use or your personal information, please contact DEP's Chief Privacy Officer at <a href="mailto:depprivacyofficer@ww.gov">depprivacyofficer@ww.gov</a>.

WW-6A4 (1/12)

# STATE OF WEST VIRGINIA DEPARTMENT OF ENVIRONMENTAL PROTECTION, OFFICE OF OIL AND GAS NOTICE OF INTENT TO DRILL

Pursuant to W. Va. Code § 22-6A-16(b), the Notice of Intent to Drill is only required if the notice requirements of W. Va. Code § 22-6A-10(a) have NOT been met or if the Notice of Intent to Drill requirement has NOT been waived in writing by the surface owner.

Date of Noti	Requirement: Notice shales: 10/13/2020		Application Filed:	permit apprication	
Delivery me	thod pursuant to West Vi	rginia Code § 22-6.	A-16(b)		
	Tall amount				
☐ HAND	■ CERTIFIE				
DELIVE	ERY RETURN	RECEIPT REQUE	STED		
receipt reque drilling a hor of this subsec subsection m	sted or hand delivery, give izontal well: <i>Provided</i> , The tion as of the date the notion ay be waived in writing by	the surface owner nat notice given pursue was provided to the the surface owner.	rior to filing a permit application to tice of its intent to enter upon to suant to subsection (a), section to the surface owner: <i>Provided, how</i> . The notice, if required, shall income of the operator and the operator	the surface owner's en of this article sa wever, That the not lude the name, add	land for the purpose of tisfies the requirements ice requirements of this ress, telephone number,
Notice is he	reby provided to the	URFACE OWNE			
Name: Carl & G			Name:		
Address: 2 Me Chillicothe, OH 4			Address:		
	reby given: Vest Virginia Code § 22-6/	A-16(b), notice is he	ereby given that the undersigned	well operator has	an intent to enter upon
Pursuant to V the surface ov State:	Vest Virginia Code § 22-67 wner's land for the purpose West Virginia		ereby given that the undersigned ntal well on the tract of land as for UTM NAD 83	ollows: 538,993.29	an intent to enter upon
Pursuant to V the surface of State; County;	Vest Virginia Code § 22-6/ wner's land for the purpose West Virginia Ohio		utal well on the tract of land as for UTM NAD 83 Easting: Northing:	538,993.29 4,439,129.00	an intent to enter upon
Pursuant to V the surface of State: County: District:	Vest Virginia Code § 22-6/ wner's land for the purpose West Virginia Ohio Liberty		ntal well on the tract of land as for UTM NAD 83 Easting: Northing: Public Road Access:	ollows: 538,993.29 4,439,129.00 Rogers Road	an intent to enter upon
Pursuant to V the surface of State: County: District: Quadrangle:	Vest Virginia Code § 22-67 wner's land for the purpose West Virginia Ohio Liberty Valley Grove, WV		utal well on the tract of land as for UTM NAD 83 Easting: Northing:	538,993.29 4,439,129.00	an intent to enter upon
Pursuant to V	Vest Virginia Code § 22-6/ wner's land for the purpose West Virginia Ohio Liberty		ntal well on the tract of land as for UTM NAD 83 Easting: Northing: Public Road Access:	ollows: 538,993.29 4,439,129.00 Rogers Road	an intent to enter upon
Pursuant to V the surface of State; County; District: Quadrangle: Watershed; This Notice Pursuant to V facsimile nur related to hor	Vest Virginia Code § 22-62 wher's land for the purpose West Virginia Ohio Liberty Valley Grove, WV Upper Ohio South  Shall Include: West Virginia Code § 22-62 mber and electronic mail a rizontal drilling may be ob-	6A-16(b), this noticed address of the operationed from the Sec	ntal well on the tract of land as for UTM NAD 83 Easting: Northing: Public Road Access:	ollows: 538,993.29 4,439,129.00 Rogers Road Carl Rotter OHI  ress, telephone nuted representative. of Environmental F	mber, and if available, Additional information Protection headquarters,
Pursuant to V the surface of State: County: District: Quadrangle: Watershed: This Notice Pursuant to V facsimile nur related to hor located at 60 Notice is he	Vest Virginia Code § 22-62 wner's land for the purpose West Virginia Ohio Liberty Valley Grove, WV Upper Ohio South  Shall Include: West Virginia Code § 22-62 nber and electronic mail a rizontal drilling may be obtained by:	6A-16(b), this noticed driving a horizon of the operation of the Secondary (304-	ntal well on the tract of land as for UTM NAD 83  Public Road Access: Generally used farm name:  Ice shall include the name, add ator and the operator's authorize cretary, at the WV Department of 926-0450) or by visiting www.d	ollows: 538,993.29 4,439,129.00 Rogers Road Carl Rotter OHI  ress, telephone nured representative. of Environmental Fep.wv.gov/oil-and-	mber, and if available, Additional information Protection headquarters, gas/pages/default.aspx.
Pursuant to V the surface of State: County: District: Quadrangle: Watershed: This Notice Pursuant to facsimile nur related to hor located at 60 Notice is he Well Operato	Vest Virginia Code § 22-62 wher's land for the purpose West Virginia Ohio Liberty Valley Grove, WV Upper Ohio South  Shall Include: West Virginia Code § 22- mber and electronic mail a rizontal drilling may be obtained by: The Street, SE, Charleston reby given by: The SWN Production Company, L	6A-16(b), this noticed address of the operation of the Secondary WV 25304 (304-	ntal well on the tract of land as for UTM NAD 83 Easting: Northing: Public Road Access: Generally used farm name:  The state of land as for each of the state of	ollows: 538,993.29 4,439,129.00 Rogers Road Carl Rotter OHI  ress, telephone nuted representative. of Environmental Fep.wv.gov/oil-and-	mber, and if available, Additional information Protection headquarters, gas/pages/default.aspx.
Pursuant to V the surface of State: County: District: Quadrangle: Watershed: This Notice Pursuant to facsimile nur related to hor located at 60 Notice is he Well Operato	Vest Virginia Code § 22-62 wner's land for the purpose West Virginia Ohio Liberty Valley Grove, WV Upper Ohio South  Shall Include: West Virginia Code § 22-62 nber and electronic mail a rizontal drilling may be obtained by:	6A-16(b), this noticed address of the operation of the Secondary WV 25304 (304-	ntal well on the tract of land as for UTM NAD 83  Public Road Access: Generally used farm name:  Ice shall include the name, add ator and the operator's authorize cretary, at the WV Department of 926-0450) or by visiting www.d	ollows: 538,993.29 4,439,129.00 Rogers Road Carl Rotter OHI  ress, telephone nured representative. of Environmental Fep.wv.gov/oil-and-  Michael Yates 1300 Fort Pierpont I	mber, and if available, Additional information Protection headquarters, gas/pages/default.aspx.
Pursuant to Verhe surface of State: County: District: Quadrangle: Watershed: This Notice Pursuant to Vertice and to Notice is he Well Operate Address:	Vest Virginia Code § 22-62 wher's land for the purpose West Virginia Ohio Liberty Valley Grove, WV Upper Ohio South  Shall Include: West Virginia Code § 22- mber and electronic mail a rizontal drilling may be obtained by: The Street, SE, Charleston reby given by: The SWN Production Company, L	6A-16(b), this noticed address of the operation of the Secondary WV 25304 (304-	ntal well on the tract of land as for UTM NAD 83  Public Road Access: Generally used farm name:  ce shall include the name, add ator and the operator's authorize cretary, at the WV Department of 926-0450) or by visiting www.d.  Authorized Representative: Address:	ollows: 538,993.29 4,439,129.00 Rogers Road Carl Rotter OHI  ress, telephone nuted representative. of Environmental Fep.wv.gov/oil-and- : Michael Yates 1300 Fort Pierpont I	mber, and if available, Additional information Protection headquarters, gas/pages/default.aspx.  Office of Oil and Case  Or., Suite 201
Pursuant to V the surface of State: County: District: Quadrangle: Watershed: This Notice Pursuant to V facsimile nur related to hor located at 60 Notice is he Well Operate Address: Telephone:	Vest Virginia Code § 22-60 wner's land for the purpose West Virginia Ohio Liberty Valley Grove, WV Upper Ohio South  Shall Include: West Virginia Code § 22-60 nber and electronic mail a cizontal drilling may be obtained by: The Swn Production Company, L. 1300 Fort Pierpont Dr., Suite	6A-16(b), this noticed address of the operation of the Secondary WV 25304 (304-	ntal well on the tract of land as for UTM NAD 83 Easting: Northing: Public Road Access: Generally used farm name:  Ice shall include the name, add ator and the operator's authorize cretary, at the WV Department of 926-0450) or by visiting www.d.  Authorized Representative: Address:  Telephone:	ollows: 538,993.29 4,439,129.00 Rogers Road Carl Rotter OHI  ress, telephone nuted representative. of Environmental Fep.wv.gov/oil-and- : Michael Yates 1300 Fort Pierpont I	mber, and if available, Additional information Protection headquarters, gas/pages/default.aspx.  Office of Oil and Case  Or., Suite 201
Pursuant to V the surface of State: County: District: Quadrangle: Watershed: This Notice Pursuant to V facsimile nur related to hor located at 60 Notice is he Well Operato	Vest Virginia Code § 22-62 wner's land for the purpose West Virginia Ohio Liberty Valley Grove, WV Upper Ohio South  Shall Include: West Virginia Code § 22-62 nber and electronic mail a rizontal drilling may be obtained by: The Street, SE, Charlestone Company, Lectrone 1300 Fort Pierpont Dr., Suite: Morgantown, WV 26508	6A-16(b), this noticed address of the operation of the Secondary WV 25304 (304-	ntal well on the tract of land as for UTM NAD 83  Public Road Access: Generally used farm name:  ce shall include the name, add ator and the operator's authorize cretary, at the WV Department of 926-0450) or by visiting www.d.  Authorized Representative: Address:	ollows: 538,993.29 4,439,129.00 Rogers Road Carl Rotter OHI  ress, telephone nuted representative. of Environmental Fep.wv.gov/oil-and- : Michael Yates 1300 Fort Pierpont I	mber, and if available, Additional information Protection headquarters, gas/pages/default.aspx.

The Office of Oil and Gas processes your personal information, such as name, address and telephone number, as part of our regulatory duties. Your personal information may be disclosed to other State agencies or third parties in the normal course of business or as needed to comply with statutory or regulatory requirements, including Freedom of Information Act requests. Our office will appropriately secure your personal information. If you have any questions about our use or your personal information, please contact DEP's Chief Privacy Officer at depprivacyofficer@wv.gov.

WW-6A5 (1/12)

# STATE OF WEST VIRGINIA DEPARTMENT OF ENVIRONMENTAL PROTECTION, OFFICE OF OIL AND GAS NOTICE OF PLANNED OPERATION

Notice Time Date of Notic	Requirement: notice shall be provid ce: 10/13/2020 Date Perm	led no later than the filing nit Application Filed:	date of permit	application.
Delivery met	hod pursuant to West Virginia Coo	de § 22-6A-16(c)		
CERTI	FIED MAIL	☐ HAND		
	RN RECEIPT REQUESTED	DELIVERY		
return receipt the planned of required to be drilling of a l damages to th (d) The notice of notice.  Notice is her (at the addres	requested or hand delivery, give the operation. The notice required by the provided by subsection (b), section thorizontal well; and (3) A proposed the surface affected by oil and gas opened required by this section shall be given by provided to the SURFACE OW is listed in the records of the sheriff at	surface owner whose land his subsection shall inclu- ten of this article to a surf- surface use and compen- rations to the extent the da- ven to the surface owner a VNER(s)	I will be used for de: (1) A copy ace owner whose sation agreement amages are comp	cation, an operator shall, by certified mail or the drilling of a horizontal well notice of of this code section; (2) The information se land will be used in conjunction with the at containing an offer of compensation for pensable under article six-b of this chapter, sted in the records of the sheriff at the time
	elrose Dr.	Addres	s:	
Address: 2 Me Chillicothe, OH 45 Notice is her Pursuant to Woperation on State:	elrose Dr. 1601 eby given:	Addres  tice is hereby given that the contract of drilling a horizontal	ne undersigned of the transport of the t	538,993.29
Address: 2 Me Chillicothe, OH 45  Notice is her Pursuant to Woperation on State: County:	eby given: /est Virginia Code § 22-6A-16(c), no the surface owner's land for the purp West Virginia Ohio	Addres  tice is hereby given that the second drilling a horizonta  UTM NAD 8	ne undersigned of the transition of the transition the transition Easting:  Northing:	act of land as follows: 538,993.29 4,439,129.00
Address: 2 Me Chillicothe, OH 45  Notice is her Pursuant to Wooperation on State: County; District:	eby given: /est Virginia Code § 22-6A-16(c), no the surface owner's land for the purp West Virginia Ohio Liberty	Addres  tice is hereby given that the second drilling a horizonta  UTM NAD 8  Public Road	ne undersigned of the transfer	act of land as follows: 538,993.29 4,439.129.00 Rogers Road
Notice is her Pursuant to W	eby given: /est Virginia Code § 22-6A-16(c), no the surface owner's land for the purp West Virginia Ohio	Addres  tice is hereby given that the second drilling a horizonta  UTM NAD 8  Public Road	ne undersigned of the transition of the transition the transition Easting:  Northing:	act of land as follows: 538,993.29 4,439,129.00
Address: 2 Me Chillicothe, OH 45  Notice is her Pursuant to Wooperation on State: County: District: Quadrangle: Watershed:  This Notice S Pursuant to W to be provide horizontal we surface affect information r headquarters,	eby given: //est Virginia Code § 22-6A-16(c), no the surface owner's land for the purp West Virginia Ohio Liberty Valley Grove, WV Upper Ohio South  Shall Include: //est Virginia Code § 22-6A-16(c), the ed by W. Va. Code § 22-6A-10(b) to the lit; and (3) A proposed surface use are ded by oil and gas operations to the celated to horizontal drilling may be located at 601 57th Street, SE,	Addres  Addres	ne undersigned of l well on the tra Easting: Northing: Access: ed farm name:  OA copy of this e land will be undersigned arm, at the WV	act of land as follows: 538,993.29 4,439.129.00 Rogers Road
Address: 2 Me Chillicothe, OH 45  Notice is her Pursuant to W operation on State: County; District: Quadrangle: Watershed:  This Notice S Pursuant to V to be provide horizontal we surface affect information r headquarters, gas/pages/def	eby given:  /est Virginia Code § 22-6A-16(c), no the surface owner's land for the purp West Virginia Ohio Liberty Valley Grove, WV Upper Ohio South  Shall Include:  //est Virginia Code § 22-6A-16(c), the ed by W. Va. Code § 22-6A-10(b) the lit; and (3) A proposed surface use are ded by oil and gas operations to the delated to horizontal drilling may be located at 601 57th Street, SE, Gault.aspx.	Addresses are contained from the Secre Charleston, WV 25304	ne undersigned of the transition of transition of the transition o	act of land as follows:  538,993.29  4,439.129.00  Rogers Road  Carl Rotter OHI  code section; (2) The information required used in conjunction with the drilling of a n offer of compensation for damages to the der article six-b of this chapter. Additional Department of Environmental Protection or by visiting www.dep.wv.gov/oil-and-
Address: 2 Me Chillicothe, OH 45  Notice is her Pursuant to W operation on State: County: District: Quadrangle: Watershed:  This Notice S Pursuant to W to be provide horizontal we surface affect information r headquarters, gas/pages/def	eby given: //est Virginia Code § 22-6A-16(c), northe surface owner's land for the purp West Virginia Ohio Liberty Valley Grove, WV Upper Ohio South  Shall Include: //est Virginia Code § 22-6A-16(c), the ed by W. Va. Code § 22-6A-10(b) to ell; and (3) A proposed surface use are ded by oil and gas operations to the elated to horizontal drilling may be located at 601 57th Street, SE, Cault.aspx.  T: SWN Production Company, LLC	Addres  Addres	ne undersigned of l well on the tra Easting: Northing: Access: ed farm name:  A copy of this e land will be understand arm prompensable understand arm, at the WV (304-926-0450)	act of land as follows:  538,993.29  4,439.129.00  Rogers Road  Carl Rotter OHI  code section; (2) The information required used in conjunction with the drilling of a n offer of compensation for damages to the der article six-b of this chapter. Additional Department of Environmental Protection or by visiting www.dep.wv.gov/oil-and-Dr., Suite 201
Address: 2 Me Chillicothe, OH 45  Notice is her Pursuant to W operation on State: County; District: Quadrangle: Watershed:  This Notice S Pursuant to W to be provide horizontal we surface affect information r	eby given:  /est Virginia Code § 22-6A-16(c), no the surface owner's land for the purp West Virginia Ohio Liberty Valley Grove, WV Upper Ohio South  Shall Include:  //est Virginia Code § 22-6A-16(c), the ed by W. Va. Code § 22-6A-10(b) the lit; and (3) A proposed surface use are ded by oil and gas operations to the delated to horizontal drilling may be located at 601 57th Street, SE, Gault.aspx.	Addresses are contained from the Secre Charleston, WV 25304	ne undersigned of l well on the tra Easting: Northing: Access: ed farm name:  A copy of this e land will be understand arm tontaining arompensable underly, at the WV (304-926-0450)  1300 Fort Pierpont I Morgantown, WV 26	act of land as follows:  538,993.29  4,439.129.00  Rogers Road  Carl Rotter OHI  code section; (2) The information required used in conjunction with the drilling of a n offer of compensation for damages to the der article six-b of this chapter. Additional Department of Environmental Protection or by visiting www.dep.wv.gov/oil-and-Dr., Suite 201

Oil and Gas Privacy Notice:

The Office of Oil and Gas processes your personal information, such as name, address and telephone number, as part of our regulatory duties. Your personal information may be disclosed to other State agencies or third parties in the normal course of Beans or as needed to comply with statutory or regulatory requirements, including Freedom of Information Act requests. Our office will appropriately secure your personal information. If you have any questions about our use or your personal information please contact DEP's Chief Privacy Officer at depprivacyofficer@wv.gov.



# WEST VIRGINIA DEPARTMENT OF TRANSPORTATION

**Division of Highways** 

1900 Kanawha Boulevard East • Building Five • Room 110 Charleston, West Virginia 25305-0430 • (304) 558-3505

September 22, 2020

Byrd E. White, III Secretary of Transportation/ Commissioner of Highways

Jimmy Wriston, P. E.
Deputy Secretary/
Deputy Commissioner

James A. Martin, Chief Office of Oil and Gas Department of Environmental Protection 601 57<sup>th</sup> Street, SE Charleston, WV 25304

Subject: DOH Permit for the Carl Rotter Pad, Ohio County

Carl Rotter OHI 10H Well Site

Dear Mr. Martin,

This well site will be accessed from a DOH permit #06-2013-0307 which has been issued to Southwestern Energy for access to the State Road for a well site located off Ohio County Route 40/6 SLS MP 1.2.

This operator is in compliance with §22-6A-20 of the WV Code. Operator has signed a STATEWIDE OIL AND GAS ROAD MAINTENANCE BONDING AGREEMENT and provided the required Bond. This operator is currently in compliance with the DOH OIL AND GAS POLICY dated October 1, 2018.

Very Truly Yours,

Gary K. Clayton, P.E.

Day K. Clayton

Regional Maintenance Engineer Central Office O&G Coordinator

Cc: Brittany Woody Southwestern Energy CH, OM, D-6

File

Office of Oil and Gas

NOV 1 3 2020

WV Department of Environmental Protection

03/11/2022

		Alumber Olegen	CAS Number
Product Name	Program Use	Chemical Name Ethylene glycol	107-21 1
AI-303 (U.S. Well Services)	Mixture	A Section of the sect	104-55 2
		Cinnamaldehyde	
		Butyl cellosolve	111-76 2
		Formic acid	64-18 6
		Polyether	Proprietary
		Acetophenone, thiourea, formaldehyde polymer	68527-49 1
AP ONE (U.S. Well Services)	Breaker	Ammonium persulfate	7727-54-0
Bactron K-139 (Champion Technologies)	Biocide	Glutaraldehyde	111-30-8
Bactron K-139 (Champion Technologies)	blocide	Quaternary Ammonium Compounds, Benzyl-C12-16-Alkyldimethyl, Chlorides	68424-85-1
		Ethanol	64-17-5
Bactron K-219 (Champion Technologies)	Biocide	Methanol	67-56-1
		Quaternary Ammonium Compounds, Benzyl-C12-16-Alkyldimethyl, Chlorides	68424-85-1
CarboNRT	Tracer	Ceramic Proppant	66402-68-4
EC6486A (Nalco Champion)	Scale Inhibitor	Amine Triphosphate	Proprietary
CCO TOUR (Trained Citatilpion)	Gaste Hilliotes	Ethylene Glycol	107-21-1
	nt-state		7722-84-1
EC6734A (Champion Technologies)	Biocide	Hydrogen Peroxide	
		Acetic Acid	64-19-7
		Peroxyacetic Acid	79-21-0
Econo-CI200 (SWN Well Services)	Corrosion Inhibitor	Methanol	67-56-1
		Oxyalkylated fatty acid	68951-67-7
		Fatty acids	61790-12-3
		Modified thiourea polymer	68527-49-1
		Water	7732-18-5
			7647-01-0
		Hydrochloric acid	
		Potassium acetate	127-08-2
		Formaldehyde	50-00-0
Ecopol-FEAC (SWN Well Services)	Iron Control	Acetic Acid	64-19-7
		Citric Acid	77-92-9
		Water	7732-18-5
FDP-S1176-15 (Halliburton)	Friction Reducer	Polyacylate	Proprietary
round and framed round.	, instant neddect	Hydrotreated light petroleum distillate	64742-47-8
FLOJET DR900 LPP (SWN Well Services)	Friction Reducer	Distillates (petroleum) hydrotreated light	64674-47-8
		Ethylene Glycol	107-21-1
		Alcohols, C12-16, Exoxylated propoxylated	68213-24-1
		Fatty Alcohols ethoxylated	Proprietary
		Water	7732-18-5
FLOJET DRP 1130X (SWN Well Services)	Friction Reducer	Proprietary	Proprietary
FR-76 (Halliburton)	Friction Reducer	Hydrotreated light petroleum distillate	64742-47-8
FR-70 (Halliburtoll)	Friction Reduces	Inorganic Salt	
			Proprietary
GYPTRON T-390 (Champion Technologies)	Scale Inhibitor	Methanol	67-56-1
		Nonylphenol Ethoxylate	Proprietary
HAI-150E (Halliburton)	Corrosion Inhibitor	No hazardous substance	N/A
HCL (SWN Well Services)	Hydrocholic Acid	Hydrochloric Acid	7647-01-0
THE ACTION OF THE STATE OF THE	in a series of the series of t	Water	7732-18-5
LP-65 MC (Halliburton)	Scale Inhibitor	Organic phosphonate	Proprietary
a op we maindurton)	Scare millultur	Ammonium Chloride	12125-02-9
		1 31/07 (14)	
OPTI-FLEX (U.S. Well Services)	Viscosifying Agent	Distillates, petroleum, hydrotreated light	64742-47-8
Plexslick 930	Friction Reducer	Copolymer of 2-propenamide	Proprietary
		Hydrotreated Distillate	64742-47-8
		Sodium Chloride	7647-14-5
		Alcohols, C12-16, Exoxylated	68551-12-2
		Oleic Acid Diethanolamide	93-83-4
		Ammonium Chloride	
	-100	20 cm (20 cm (2) cm (20 cm (20 cm (20 cm (20 cm (2) cm (2) cm (20 cm (2)	12125-02-9
Plexslick 953	Friction Reducer	Petroleum Distillate	64742-47-8
		Sodium Chloride	7647-14-5
		Ammonium Chloride	12125-02-9
		N,N-bis (2-hydroxyethyl) oleamide	93-83-4
Plexslick 957	Friction Reducer	Petroleum Distillate	64742-47-8
		Ammonium Chloride	12125-02-9
		Oleic Acid Diethanolamide	
			93-83-4
		Alcohols, C12-16, Exoxylated	68551-12-2
		Water	7732-15-5
WFRA-2000 (U.S. Well Services)	Anionic Friction Reducer	Hydrotreated light distillate (petroleum)	64742-47-8
		Propenoic acid, polymer with propenamide	9003-06 9
Plexaid 655 NM	Scale Inhibitor	Diethylenetriamine penta (methylene phosphonic acid)	15827-30-8
Plexslick 922	no data available	Copolymer of 2-propenaminde	69418-26-4
	Grandale	Distillates (petroleum), hydotreated light	64742-47-8
		The state of the s	
		Ammonium chloride ((NH4)CI)	12125-02-9
Falaida DEEOA	president and how	Oleic Acid Diethnolamide	93-83-4 RED
Tolcide PS50A	Biocidal product	Tetrakis (hydroxymethyl) phosphonium sulphate	55566-30-8 Office CEIVE
		Acrylic acid terpolymer containing carboxylate phosphonate and sulfonate	of Oil -
		groups	93-83-4 55566-30-8 Office of Oil and 397256-50-7
		Hydrotreated light petroleum distillate	64742-47-8/// 1/ 7
LD-2950	Friction Reducer	CONTRACTOR OF THE PROPERTY OF	0
LD-2950	Friction Reducer	Ethoxylated alcohol	Proprietary 4 at Jna
LD-2950	Friction Reducer	Ethoxylated alcohol	Proprietary 4 of 2021
		Ethoxylated alcohol  Poly (oxy-1.2-ethanediyl) alphatridecylomegahydroxy-, branched	397256-50-7 64742-47-8/VOV 1 3 2020 69011-36/8/V
	Friction Reducer  Scale Control	Ethoxylated alcohol  Poly (oxy-1.2-ethanediyl) alphatridecylomegahydroxy-, branched  Methanol	69011-36/V/ Departm
		Ethoxylated alcohol  Poly (oxy-1.2-ethanediyl) alphatridecylomegahydroxy-, branched  Methanol  Phosphonic Acid Salt	69011-36/V Department of Proprietary
LD-2950 Legend LD-7750W MC MX 8-4743		Ethoxylated alcohol  Poly (oxy-1.2-ethanediyl) alphatridecylomegahydroxy-, branched Methanol  Phosphonic Acid Salt  Sodium Nitrate	69011-36/V Department of Proprietary Indiana Proprietary Proprietary Indiana Proprietary Indiana Proprietary Indiana I

# USGS 75 VALLEY GROVE QUAD MAY

WYDEP OOG ACCEPTED AS BUILT 434 12/17/2020



# CARL ROTTER OHI WELL PAD CONSTRUCTION AS-BUILT & RECLAMATION PLAN

LIBERTY DISTRICT, OHIO COUNTY, WV SEPTEMBER 2017



NOTES  1 THE AS BUST INFORMATION CHAMINETED MITTERETTE THE BOOM OF DECEMBER THE DECEMBER OF THE THIRD PRODUCE OF THE DECEMBER	
1004 Includent Area (4.0 Area had member Area 50 Mens Fro denuesto Area 50 Mens	MELLOS AND
INVARIATE WE REBING THE THE THEORY	WEST VIRIONAL DIVISION OF HIGHYAYS COUNTY ROAD VAP

Well-ribble	UN NURTH PARTS	WV ISHTO	WHITERAL WHETERAL DAVE IF	NAME STATE	ESTUAMO/
0		1201017	at oscionimi		
EASE POSTER HI ENGLISHER AT THE STATE	11.000000 St 11.1700-010-03	016/3(00 to) 6 192582 à su	0 045101 St 1 523000,77	Per stringer.	Jan ar

### SHIRE DINOFOL

	Marine Sales of the America	-
1	COVER SHEET	ī

EVACUATION ROUTE/PREVAILING WINDS

AS BUILT OVERALL PLAN SHEET INDEX

ACCESS ROAD AS-BUILT HEAM

WELL PAD AS BUILT PLAN

ACCESS ROAD AS BUILT PROFILE

WELL PAD AS BUILT PROFILE

AS BUILT RECLAMATION PLAN OVERALL PLAN SHEET INDEX

10 AG BUILT AGGESS ROAD RECLAMATION PLAN

11. AS-BUILT WELL PAD RECLAMATION FLAN

13 GENERAL NOTES AND BETALS

13-14

ENGINEERING ESTIMATE OF QUARTITIES WELL SITE PAD DATA (DRILLING) MITALL MOUNTABLE BERM SEED & MINICH DISTURGED 39 265 15 1.4/3 UN EPAIR AND NO INTABLE RM STEINE SURFACENS VIELE SITE FAIR DATA (GEOLAMATION) REACH BERM D'MIDE BIP RAP DISCHARGE CHANNELS EΛ



WHEN LOTT BEEGO O 1 or 14

2588-016-00B

RESUMMERS REPORT MAN LITT THIS SYSSES OF AND DIGMENTED TO SHE IT IS AND ARDITAGE.


DEBIGN CENTIFICATION
THE DRAWNIDS, CONSTRUCTION NOTES, AND REFERENCE DIAGRAMS ATTACHED HERETO
HAVE BEEN PREPARED IN ACCORDANCE WITH THE WEST WIREINA CORE OF STATE HULES,
DIVIGION OF ENVIRONMENTAL PROTECTION DEFICE OF DIV





CY



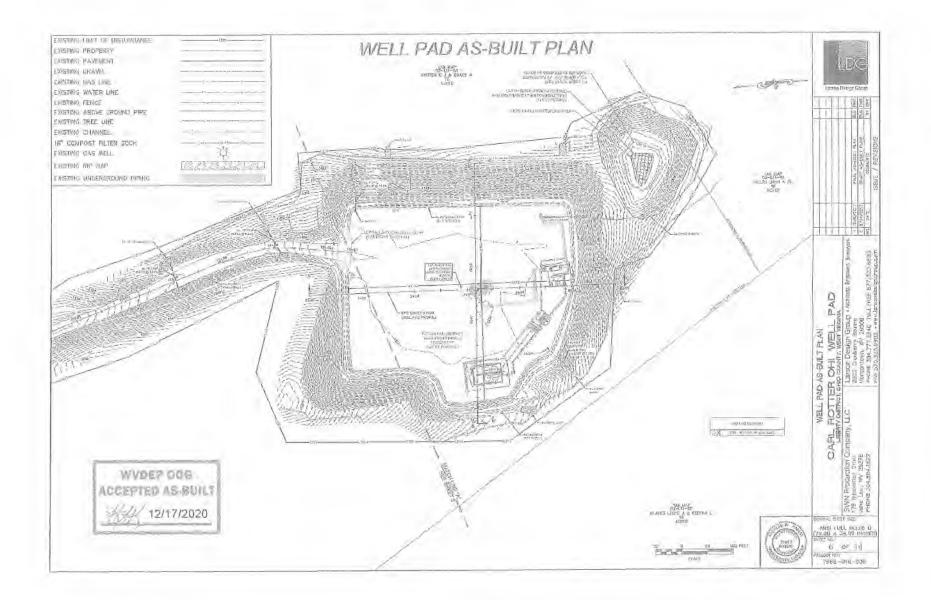

# ENTRANCE TRESTLEWORK ROGERS ROAD (CR 40/5) USGS 7.5 VALLEY GROVE QUAD MAP

# CARL ROTTER OHI WELL PAD

# CONSTRUCTION AS-BUILT & RECLAMATION PLAN

LIBERTY DISTRICT, OHIO COUNTY, WV SEPTEMBER 2017

RECEIVED

Office of Oil and Gas


ACCESS ROAD ENTRANCE LATITUDE: 40.098790 LONGITUDE: -20.539450 (NAD-83) (UTM ZONE 17 METERS)

LATITUDE: 40.101501 LONGITUDE: -80.542441 (NAD-83) (UTM ZONE 17 METERS) E 5389993 N 4439123.2

THE AS-BUILT INFORMATION SHOWN HEREON REFLECTS FIELD DATA COLLECTED RELATING TO THE FINAL GRADING OF THE DISTURBED AREA AS OF AUGUST 2, 2017, LARSON DESIGN GROUP IS NOT RESPONSIBLE FOR ANY CHANGES MADE TO THE SITE AFTER THE ABOVE MENTIONED DATE.

PROPERTY INFORMATION SHOWN HEREON WAS PROVIDED BY SOUTHWESTERN ENERGY AND MAY NOT REFLECT CURRENT

TOTAL DISTURBED AREA: 14.0 ACRES
ROAD DISTURBED AREA: 5.0 ACRES
PAD DISTURBED AREA: 9.0 ACRES

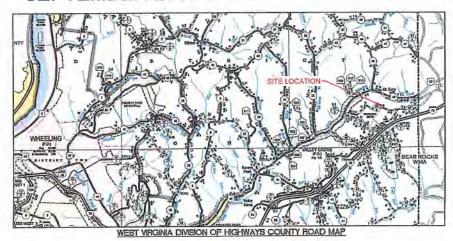

NAD 83 LAT & LONG VAY NORTH NAD 83 ELEVATION WELL HAMES H 585046.96 N 4439131.58 E 1676898.62 E 539000.77 CARL ROTTER 1H IDRILLED) APW 4T-069-001

5000	0	5000	10000	FEE.
	50	ALE		

05'	ENGINEERING ESTIMAT	E OF QUA	ANTITIES
	WELL SITE PAD DATA (DRILLIN		
	INSTALL MOUNTABLE BERM	44	CY
CEIVED	SEED & MULCH DISTURBED AREAS	205	SY
	18" COMPOST SOCK	252	LF
f Oil and Gas	STONE FOR PAD SURFACE REPAIR AND MOUNTABLE BERM STONE SURFACING	143	CY
1 3 2020	WELL SITE PAD DATA (RECLAMATION)		
	REMOVE SUMP	2	EA
	BREACH BERM	2	EA
epartment of	10 WIDE RIP-RAP DISCHARGE CHANNELS	30	CY





WEST VIRGINIA COUNTY MAP

### SHEET INDEX COVER SHEET

4	AS-BUILT OVERALL PLAN SHEET INDEX	MON 4 0 2020			
5	ACCESS ROAD AS-BUILT PLAN	NOV 1 3 2020			
6	WELL PAD AS-BUILT PLAN				
7	ACCESS ROAD AS-BUILT PROFILE	WV Department of Environmental Protecti			
8	WELL PAD AS-BUILT PROFILE				
9	AS-BUILT RECLAMATION PLAN OVERALL PLAN SHEET INDEX				
10	AS-BUILT ACCESS ROAD RECLAMATION PLAN				
11	AS-BUILT WELL PAD RECLAMATION PLAN				
12	GENERAL NOTES AND DETAILS				
13-14	DETAILS				

EVACUATION ROUTE/PREVAILING WINDS

DESIGN CERTIFICATION

13-14

THE DRAWINGS, CONSTRUCTION NOTES, AND REFERENCE DIAGRAMS ATTACHED HERETO HAVE BEEN PREPARED IN ACCORDANCE WITH THE WEST VIRGINIA CODE OF STATE RULES, DIVISION OF ENVIRONMENTAL PROTECTION, OFFICE OF OIL AND GAS CSR 35-8.



MISS Utility of West Virginia 1-800-245-4848 West Virginia State Law (Section XIV: Chapter 24-C) Requires that you call two business days before you dig in the state of West Virginia. IT'S THE LAW!



ANSI FULL BLEED D 22.00 X 34.00 INCHES

OF 14 ROJECT NO.: 7688-016-008