

NOTICE OF PROPOSED LOCATION OF OIL AND GAS WELL

(REQUIRED BY SECTION 2, CHAPTER 86, ACTS 1929)

WEST VIRGINIA DEPARTMENT OF MINES

OIL AND GAS SECTION

Drill Deeper.

and notices

To THE DEPARTMENT OF MINES,
Charleston, W. Va.

Berry Bro. (Minerals.) ✓
COAL OPERATOR OR COAL OWNER

Robert Wilson Oil & Gas Co
NAME OF WELL OPERATOR

Detroit. Mich.
ADDRESS

916, Julian St, Parkersburg, W. Va.
COMPLETE ADDRESS

H.S. Wilson, Est ✓
COAL OPERATOR OR COAL OWNER

Oct, 31. 193 5

PROPOSED LOCATION

Parkersburg. W. Va
ADDRESS

Murphy District

Care Robert Wilson.
COAL OPERATOR OR COAL OWNER

Ritchie County

Well No. 18, to be drilled deeper.

ADDRESS

Berry Bro Farm

GENTLEMEN:

The undersigned well operator is entitled to drill upon the above named farm or tract of land for oil and gas, having fee title thereto, (or as the case may be) under grant or lease dated July. 7

1897, made by H.S. Wilson, to

Fred P. Hays, and recorded on the 20th day

of Oct, 1897, in the office of the County Clerk for said County in

See lease book 56, P 197, and lease book 59 P 62, for Robt Wilson Oil & Gas

Lease Book 7, page 584

The enclosed plat was prepared by a competent engineer and shows the proposed location of a well to be drilled for oil and gas by the undersigned well operator on the farm and in the Magisterial District and County above named, determined by survey and courses and distances from two permanent points, or land marks.

The undersigned well operator is informed and believes there are no coal operators operating beds of coal beneath said farm or tract of land on which said well is located, or within 500 feet of the boundaries of the same, who have mapped their workings and filed their maps as required by law, excepting the coal operators or coal owners (if any) above named as addressees.

The above named coal operators or coal owners (if any) are notified that any objections they may desire to make to such proposed location, or which they are required to make by Section 3 of said Act, if the drilling of a well at said proposed location will cause a dangerous condition in or about their respective coal mines, must be received by, or filed with the Department of Mines within ten* days from the receipt of a copy of this notice and accompanying plat by said Department. Said coal operators are further notified that forms for use in making such objections will be furnished to them by the Department of Mines promptly on request and that all such objections must set forth as definitely as is reasonably possible the ground or grounds on which such objections are based and indicate the direction and distance the proposed location should be moved to overcome same.

(The next paragraph is to be completed only in Department's copy.)

Copies of this notice and the enclosed plat were mailed by registered mail, or delivered to the above

named coal operators or coal owners at their above shown respective address.....day.... before, or on the same day with the mailing or delivery of this copy to the Department of Mines at Charleston, West Virginia.

Very truly yours,

Robert Wilson Oil & Gas Co

WELL OPERATOR

By W. R. Baker Manager.

STREET

Beatrice. W. Va

CITY OR TOWN


STATE

Address of Well Operator }



*Section 3 If no such objections be filed, or be found by the department of mines, within said period of ten days from the receipt of said notice and plat by the department of mines, to said proposed location, the department shall forthwith issue to the well operator a drilling permit reciting the filing of such plat, that no objections have been made by the coal operators to the location, or found thereto by the department, and that the same is approved and the well operator authorized to proceed to drill at said location.

PLAT, of the location of Well No 18 of Robert Wilson Oil & Gas Co, of Parkersburg, W. Va, on a part of Berry Bro, Farm, Consistion of 450 Acres Located in Murphy District, Ritchie County, on McFarland Creek.

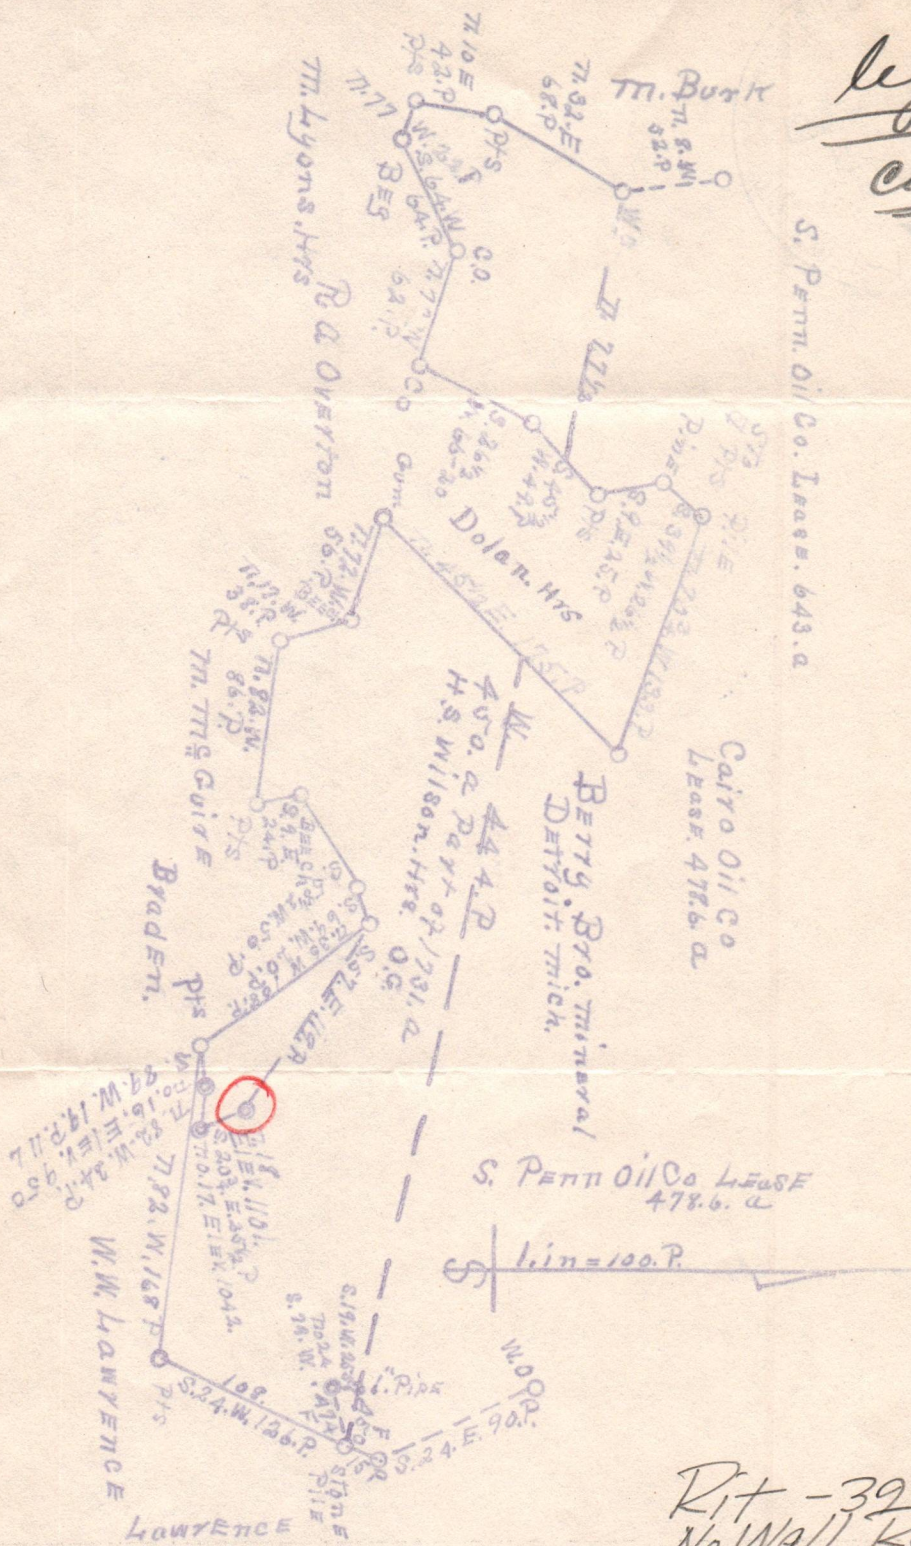

light
copy

Rit - 393
No Well Record

I, the undersigned, hereby certify that this Map is correct and shows all the information to the best of my knowledge and belief, required by the oil and gas section of the Mining Laws of W. Va.

D. G. McLeese
Engineer.

Acknowledged before me a Notary Public for Ritchie County, this 31st day of Oct 1935

Beatrice M. Ritter
Notary Public

My commission expires on the 9th day of March 1937

LIST of the location of Well No. 1 of Robert Wilson Oil Lease 06.01
located in Murphy District, Rutherford County, on a part of Berry Bros. Farm, consisting of 430 acres
located in Murphy District, Rutherford County, on a part of Berry Bros. Farm, consisting of 430 acres



I, the undersigned, hereby certify that this map is correct and
shows all the information to the best of my knowledge and belief,
required by the oil and gas section of the Mining Laws of W. Va.

W. Wilson
Engineer.

Witness my hand and seal as a Notary Public for Rutherford County,
this 15th day of _____ 1935

Notary Public

My commission expires on the _____ day
of _____ 1935