

STATE OF WEST VIRGINIA  
DEPARTMENT OF ENVIRONMENTAL PROTECTION  
OFFICE OF OIL AND GAS

AFFIDAVIT OF PLUGGING AND FILLING WELL

AFFIDAVIT SHOULD BE IN TRIPLICATE, one copy mailed to the Department, one copy to be retained by the Well Operator and the third copy (and extra copies if required) should be mailed to each coal operator at their respective addresses.

Farm name: Everett Mason Et Ux Operator Well No.: 1

LOCATION: Elevation: 900' Quadrangle: Ellenboro  
District: Grant County: Ritchie  
Latitude: 12,600 Feet South of 39 Deg. 17 Min. 30 Sec.  
Longitude: 5,930 Feet West of 81 Deg. 15 Min. 00 Sec.

Well Type: OIL  GAS

Company Green Hunter Water, LLC Coal Operator NA  
28407 State Route 7 or Owner \_\_\_\_\_  
Marietta, OH 45750 \_\_\_\_\_  
Agent \_\_\_\_\_ Coal Operator NA  
or Owner \_\_\_\_\_  
Permit Issued Date June 11, 2015

AFFIDAVIT

STATE OF WEST VIRGINIA,  
County of Ritchie ss:

Brian G. Haught and B. Douglas Haught being first duly sworn according to law depose and say that they are experienced in the work of plugging and filling oil and gas wells and were employed by the above named well operator, and participated in the work of plugging and filling the above well say that said work was commenced on the 9th day of July, 2015, and the well was plugged and filled in the following manner:


TYPE	FROM	TO	PIPE REMOVED	LEFT
Class A	4951	3976	NA	2-3/8" Tubing Cemented in Place, 4,931' to 2,020'
Class A	3976	2951	NA	4-1/2" Casing 4,951' to 2,010'
Class A	2700	2200	2-3/8" Tubing 2,020' to surface	NA
Class A	2020	1400	4-1/2" Casing 2,010' to Surface	NA
Class A	1400'	700'	NA	8-5/8" Casing 1,100' to Surface'
Class A	700'	Surface	NA	11-3/4" Casing - 40' to Surface

Description of monument: Casing Painted Yellow with Stamped Aluminum Signage and that the work of plugging and filling said well was completed on the 14th day of July, 2015.

And further deponents saith not.

B. G. Haught  
B. Douglas Haught

Sworn and subscribe before me this 17th day of AUGUST, 2015

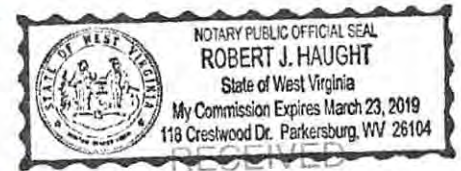

My commission expires: MARCH 23, 2019

Notary Public

Affidavit reviewed by the Office of Oil and Gas:

[Signature]

Title:

Manager

Office of Oil and Gas  
AUG 31 2015  
WV Department of Environmental Protection  
09/04/2015

# Wellbore Schematic

## Well Plugging Schematic

**Well: Mason #1**  
**API: 47-085-06064**

**Current Status:**

Plugged Well per WVDEP Office of Oil & Gas Plugging Permit

State Inspector David Cowan was present and approved all procedure adjustments from state issued permit

Frac Date: ??/??/1983

Elevation 900'

**Cement Plugs (Class A)**

- Surface to 700'
- 700' to 1400'
- 1400' to 2020'
- 2200' to 2700'
- 2951' to 3976'
- 3976' to 4951'

- Bentonite Gel**
- 1,390' to 1,400'
  - 2,020' to 2,200'
  - 2,700' to 2,951'


4-1/2" casing cut off at 2,010'  
 Casing from 4,951' to 2,010' remains

2-3/8" tubing cut off at 2,020'  
 Tubing from 4,931' to 2,020' remains

4951' 4-1/2" Original Casing Depth

**Perforations:**

- 4314' - 4893'
- 3590' - 4178'
- 3176' - 3505'

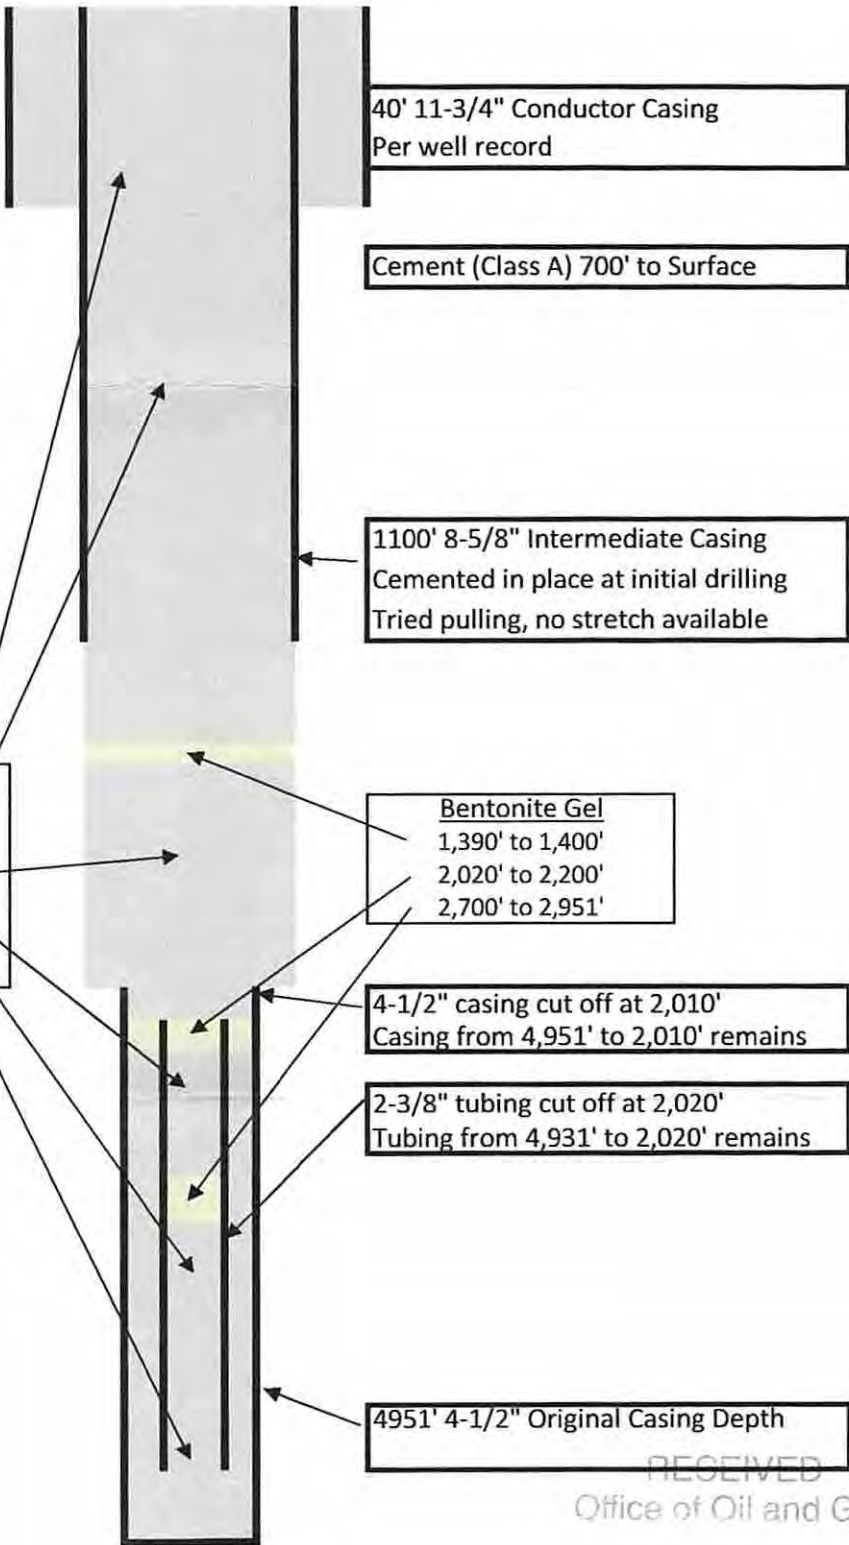

RECEIVED  
 Office of Oil and Gas

AUG 31 2015