

INSTRUCTIONS

- 1) Attach a photo copy of the location of the well on a 7.5 minute Quadrangle with the corresponding Longitude and Latitude.
- 2) Designate the location of the well with the symbol(+).

81 12 30

I, the undersigned, Hereby certify that this plat is correct to the best of my knowledge and belief.

1.5
2.65
2.14

SIGNED William S. Gilliland
TITLE President

DATE December 10, 19 91

OPERATORS WELL NO. A.J. NULL #4

API WELL NO. 47-085-8105

STATE OF WEST VIRGINIA
DEPARTMENT OF ENERGY
OIL AND GAS DIVISION

WELL TYPE: OIL GAS LIQUID INJECTION WASTE DISPOSAL
(if "GAS" PRODUCTION STORAGE DEEP SHALLOW

LOCATION: ELEVATION 843 WATER SHED RIGHT FORK OF GILLESPIE RUN
DISTRICT GRANT COUNTY RITCHIE
QUADRANGLE CAIRO

SURFACE OWNER Richard Hutchison ACREAGE 66


OIL & GAS ROYALTY OWNER See Attached LEASE ACREAGE 66
LEASE NO. _____

PRODUCING FORMATION Maxon TOTAL DEPTH 1,709

WELL OPERATOR Mountain State Oil Co. DESIGNATED AGENT William Gilliland

ADDRESS P.O. Box 14 ADDRESS P.O. Box 14
Pennsboro, WV 26415 Pennsboro, WV 26415


13431

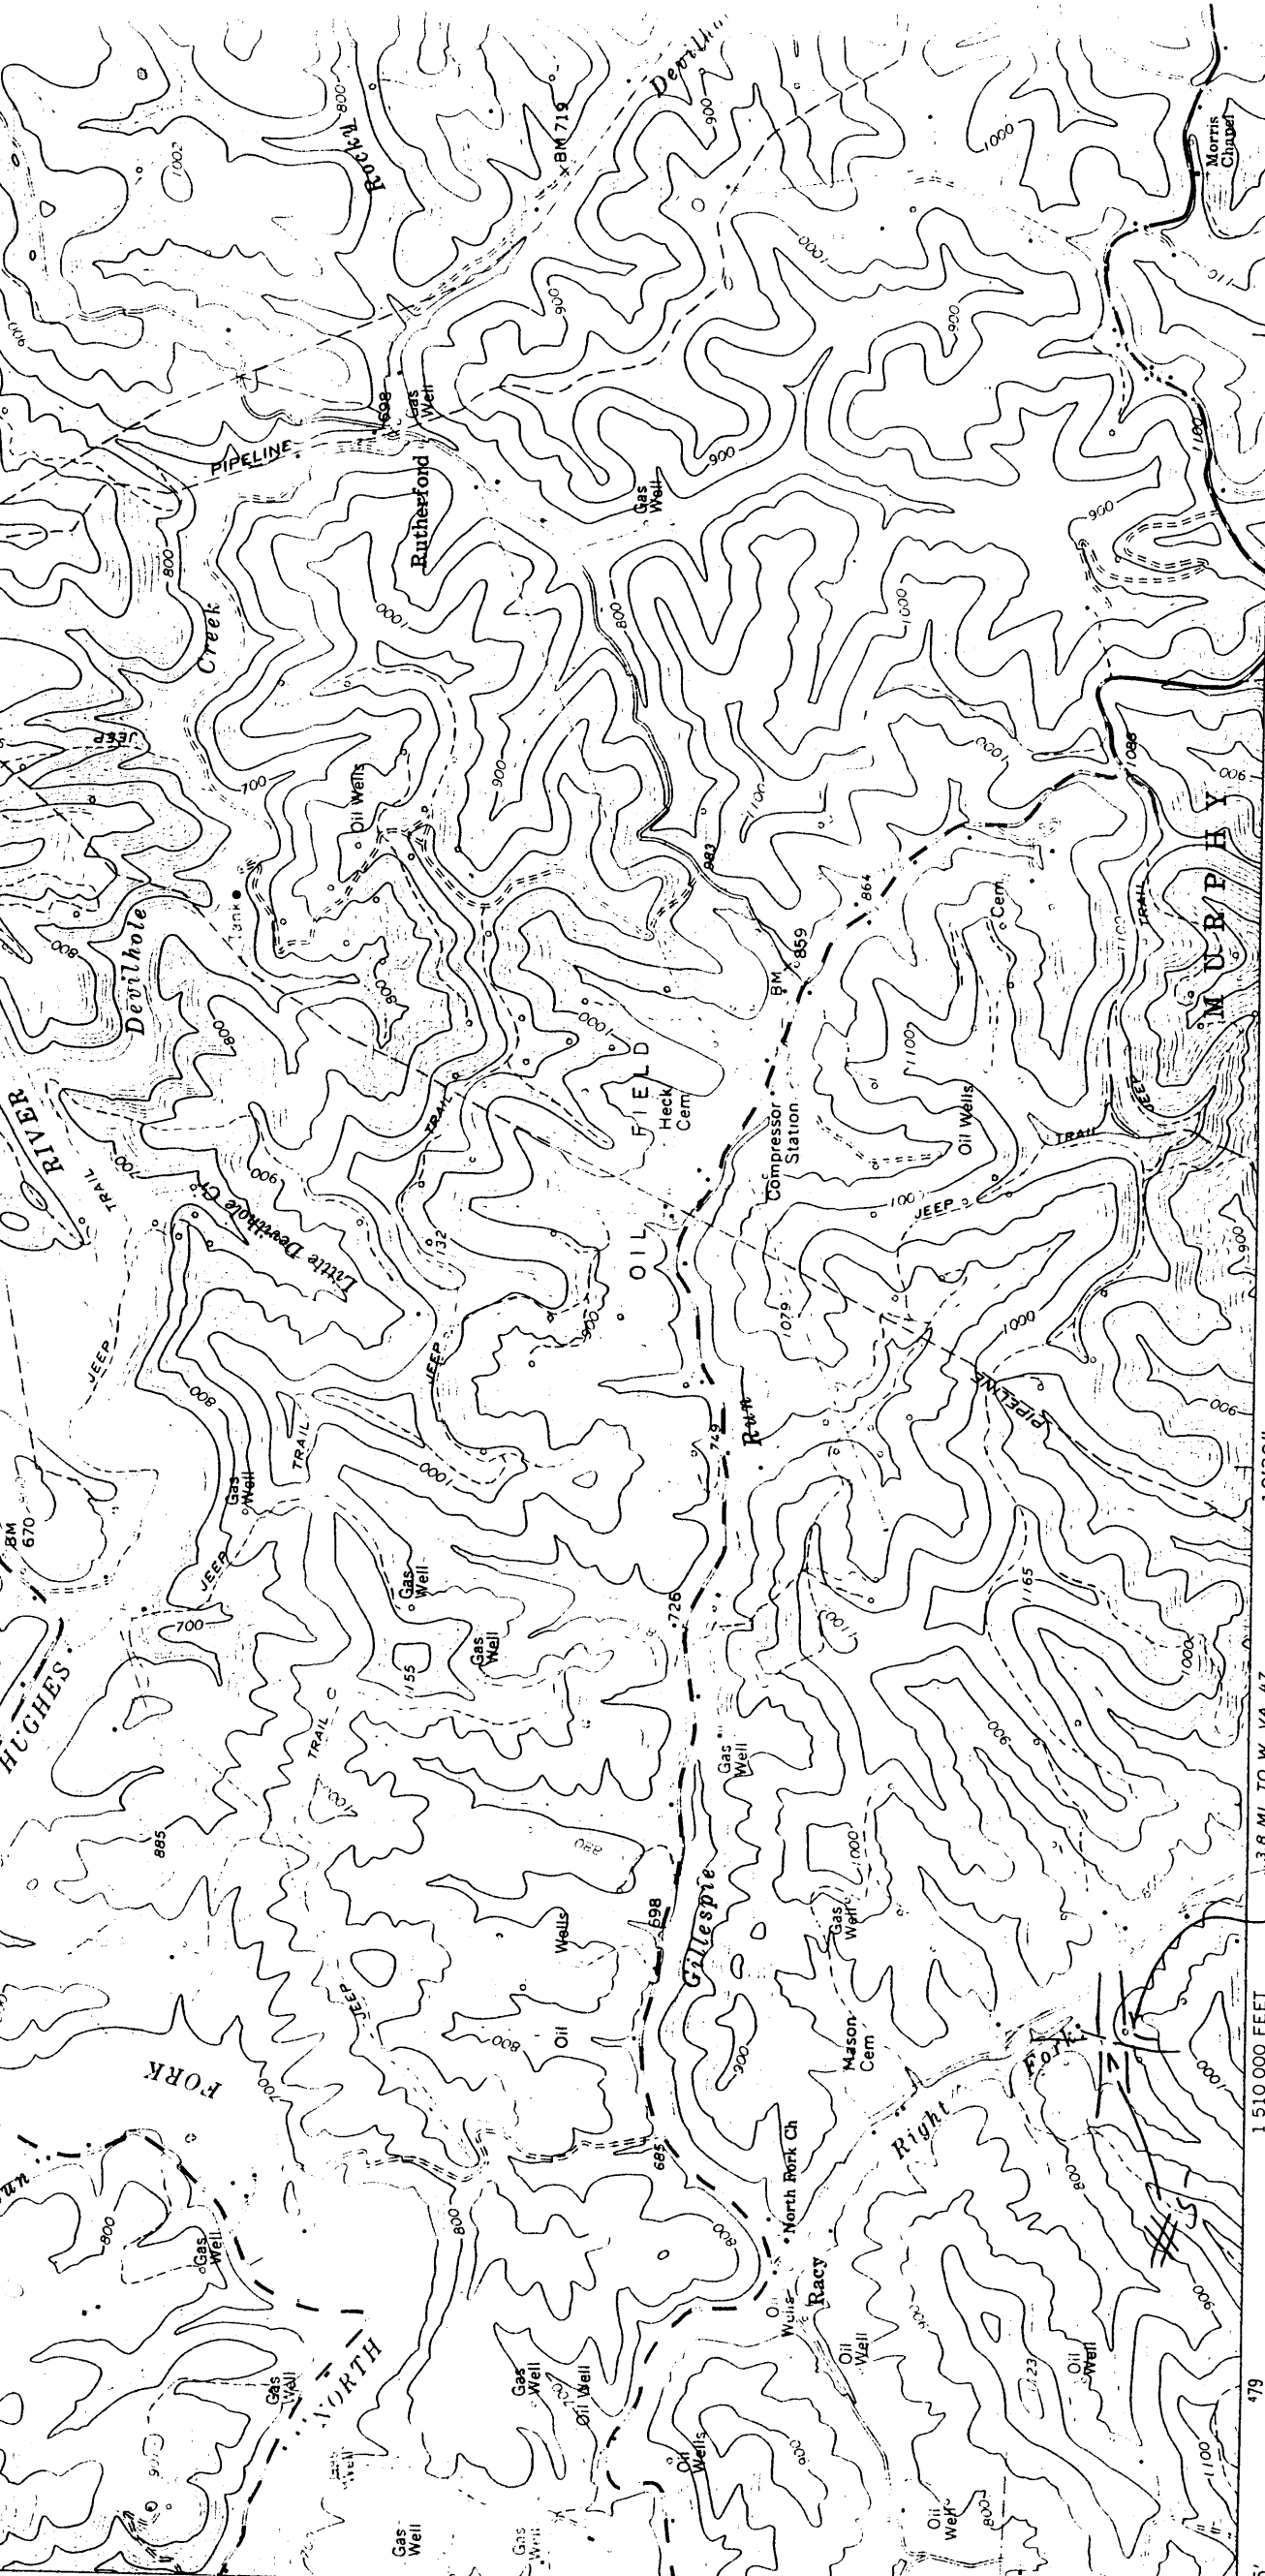

12'30" 479 483 485 10' 86

AJ NULL # 4

SCALE 1:24 000

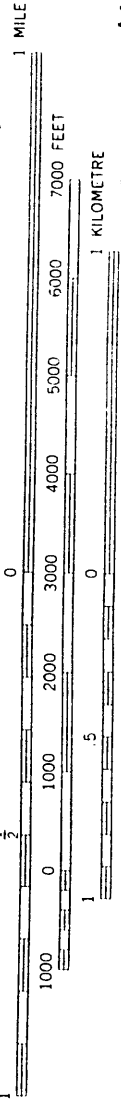

~~AJ. NULL # 4~~

Red 8105

apped, edited, and published by the Geological Survey

ontrol by USGS and USC&GS

topography by photogrammetric methods from aerial

otographs taken 1962. Field checked 1964

lyconic projection. 1927 North American datum

0,000-foot grid based on West Virginia coordinate system.

000-metre Universal Transverse Mercator grid ticks.

ne 17, shown in blue

CONTOUR INTERVAL 20 FEET
NATIONAL GEODETIC VERTICAL DATUM OF 1929