

Latitude

39°10



5°18

Longitude

Topo Location

7.5' Loc. 0.28S 15' Loc. _____
0.62W (calc.) _____

Company _____

Farm Thorp #3

15' Quad _____
(sec.)

7.5' Quad Harrisville.


District Murphy

WELL LOCATION PLAT

County 085 Permit 8214-11

INSTRUCTIONS

1475
575

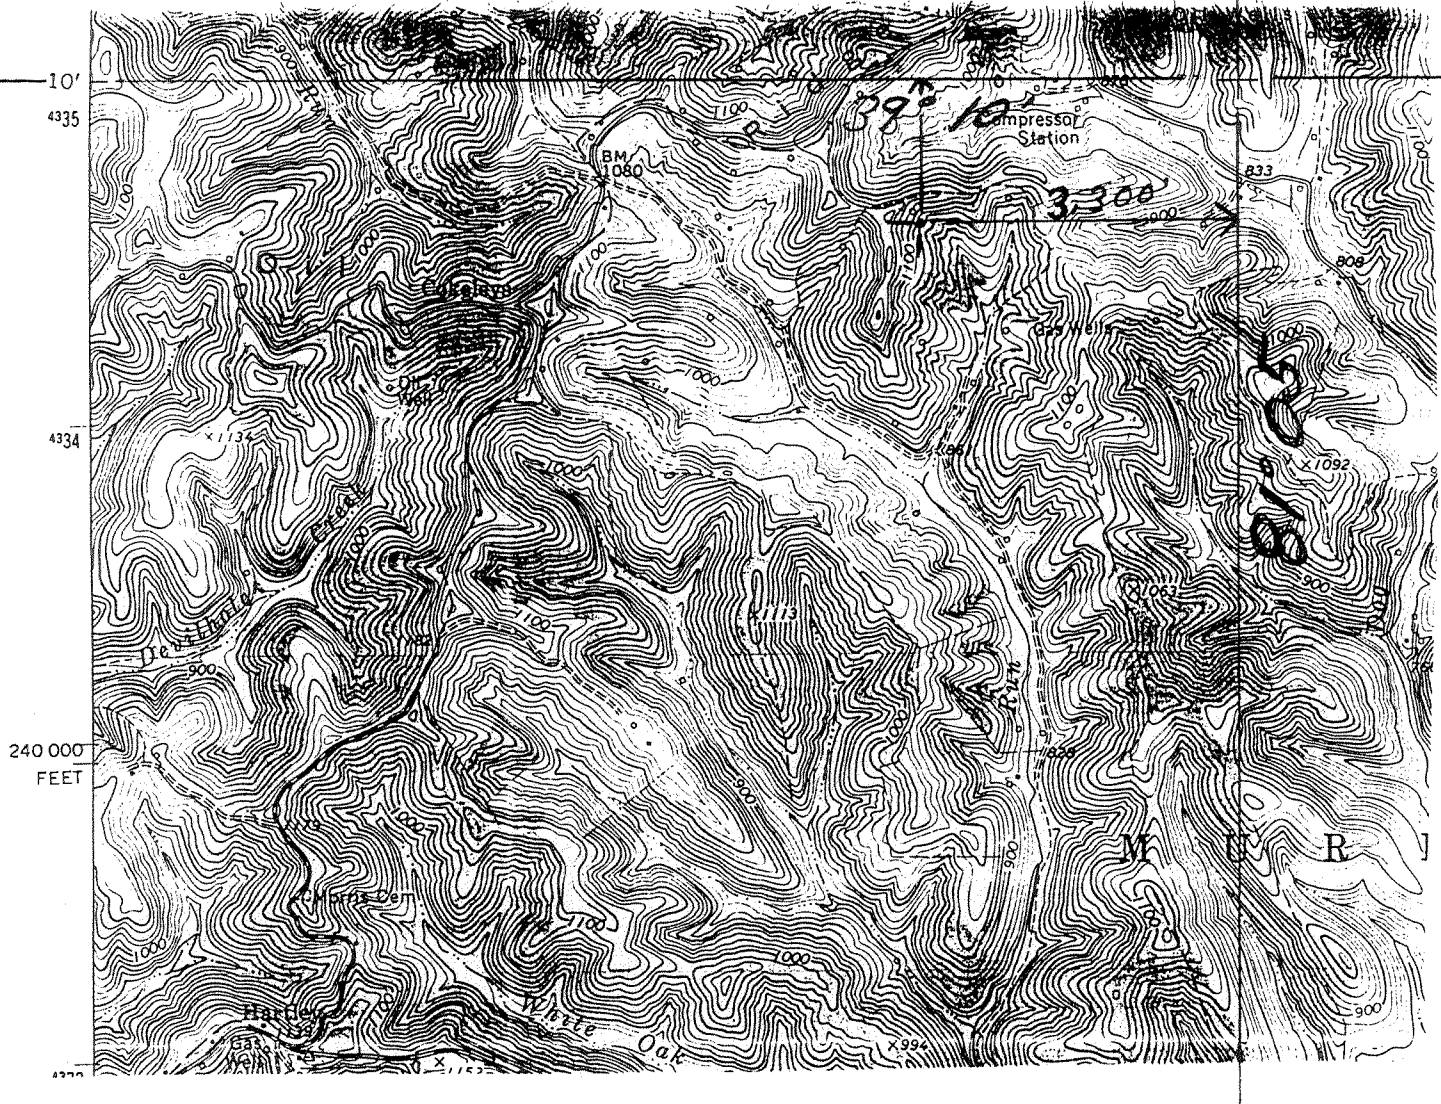

I, the undersigned, Hereby certify that this plat is correct to the best of my knowledge and belief.

SIGNED Howard H Elder
dba H H Elder & Son
TITLE Owner

16763

RECEIVED
WV Division of
Environmental Protection
JAN 26 93
Permitting
Office of Oil & Gas

DATE Dec 20, 19 92
OPERATORS WELL NO. 3 (Tharp)
API WELL NO. 47-085-8214 N

STATE OF WEST VIRGINIA
DEPARTMENT OF ENERGY
OIL AND GAS DIVISION

WELL TYPE: OIL GAS LIQUID INJECTION WASTE DISPOSAL
(if "GAS" PRODUCTION STORAGE DEEP SHALLOW

LOCATION: ELEVATION 1090 EST WATER SHED Indian Run
DISTRICT Murphy COUNTY Ritchie
QUADRANGLE Harrisville 7.5

SURFACE OWNER O Sennet ACREAGE 130

OIL & GAS ROYALTY OWNER Sigler, Moats, Sigler LEASE ACREAGE 130
LEASE NO. LB 42 Page 47

PRODUCING FORMATION In Jun TOTAL DEPTH 1826

WELL OPERATOR H H Elder & Son DESIGNATED AGENT _____

ADDRESS Rt 1, Box 257 ADDRESS HARRISVILLE 7
Cairo, WV 26337

NOV 5 1993

NOV 5 1993