


Latitude

39°10

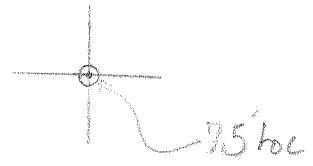

Longitude

815

Topo Location

7.5' Loc. 0.38S 15' Loc. _____
0.63W (calc.) _____

Company _____

Farm Thorp #4

15' Quad _____
(sec.)

7.5' Quad Harrisville


District Murphy

WELL LOCATION PLAT

County 085 Permit 8215-N

INSTRUCTIONS

1956

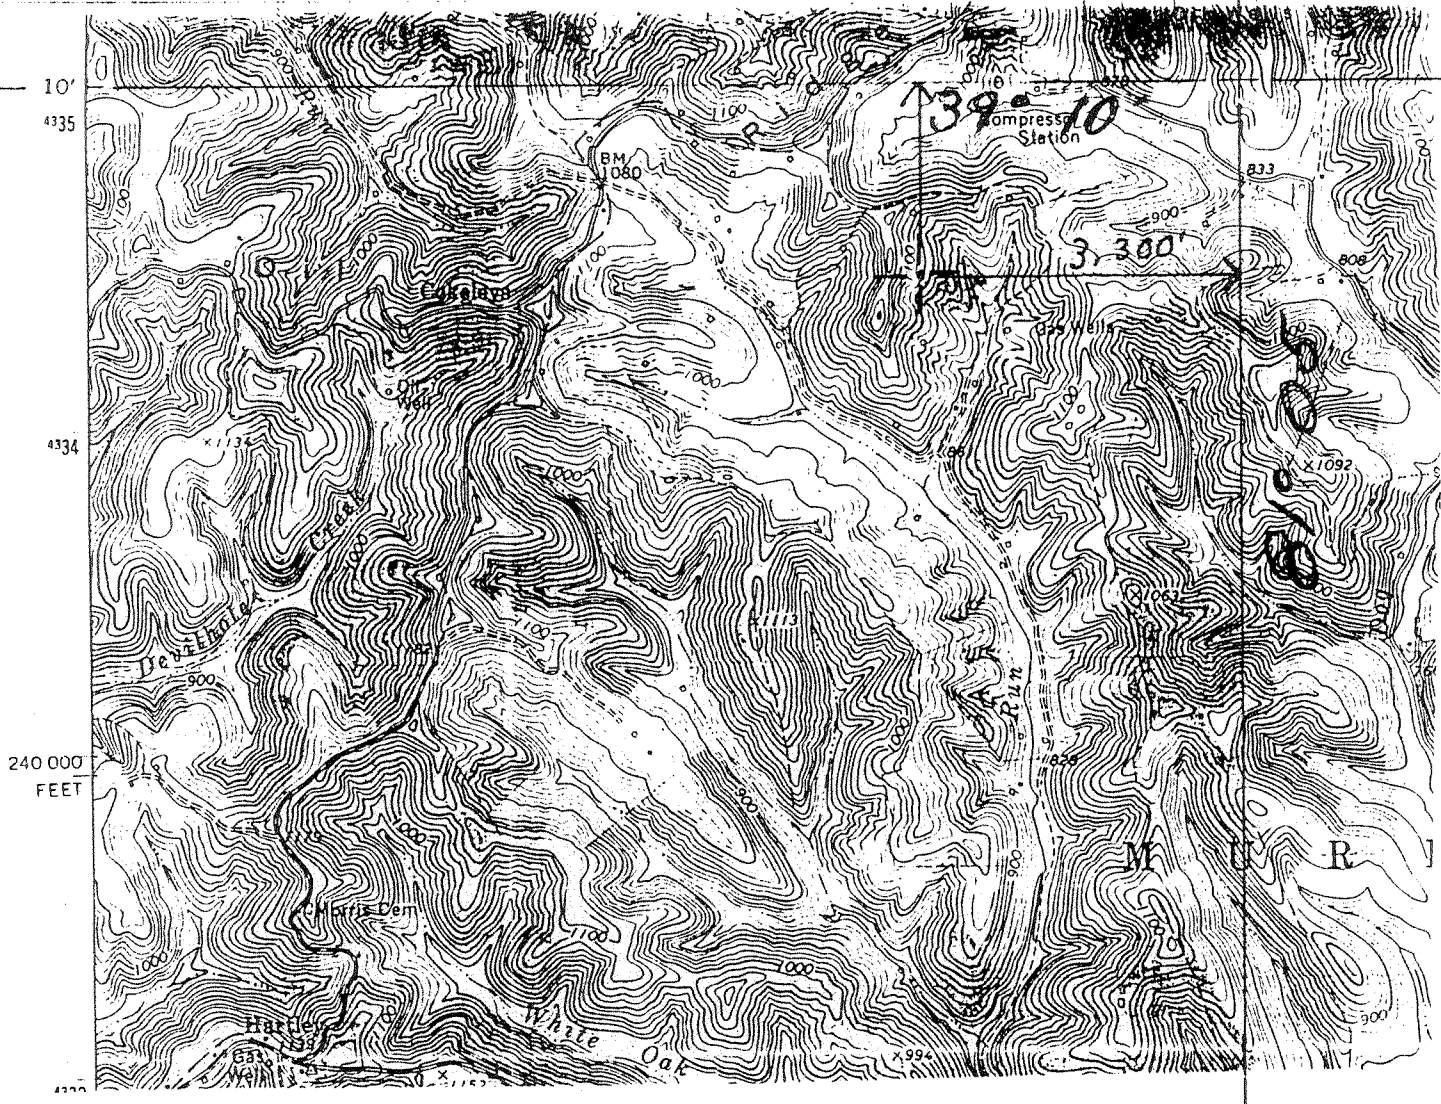

I, the undersigned, hereby certify that this plat is correct to the best of my knowledge and belief.

SIGNED Howard H Elder
dba H H Elder & Son
TITLE Owner

16764

RECEIVED
WV Division of
Environmental Protection
JAN 26 93
Permitting
Office of Oil & Gas

DATE Dec 29, 1992
OPERATORS WELL NO. 4 (Tharp)
API WELL NO. 47-085-8215-N

STATE OF WEST VIRGINIA
DEPARTMENT OF ENERGY
OIL AND GAS DIVISION

WELL TYPE: OIL GAS LIQUID INJECTION WASTE DISPOSAL
(if "GAS" PRODUCTION STORAGE DEEP SHALLOW

LOCATION: ELEVATION 1060 est WATER SHED Indian Run
DISTRICT Murphy COUNTY Ritchie
QUADRANGLE Harrisville 7.5

SURFACE OWNER Sennet ACREAGE 130

OIL & GAS ROYALTY OWNER Sigler, Moats, Sigler LEASE ACREAGE 130
LEASE NO. LB 42 Page 47

PRODUCING FORMATION Injun TOTAL DEPTH 1840

WELL OPERATOR H H Elder & Son DESIGNATED AGENT _____
ADDRESS Rt 1, Box 257 ADDRESS HARRISVILLE 7
Cairo, WV 26337

NOV 5 1993