

8510267P

WW-7  
5-02

West Virginia Department of Environmental Protection  
Office of Oil & Gas

**WELL LOCATION FORM: GPS**

API: 47- 085 - 91180 47-085-10267 WELL NO: 1

FARM NAME: M.M. Lambert

RESPONSIBLE PARTY NAME: Hall Drilling, LLC

COUNTY: Ritchie DISTRICT: Clay

QUADRANGLE: Ellenboro 7.5'

SURFACE OWNER: Michael T. & M.T. Hall

ROYALTY OWNER: Michael T. & M.T. Hall

UTM GPS NORTHING: 4,346,633 (NAD 83)

UTM GPS EASTING: 495,472 (NAD 83) GPS ELEVATION: 249 m. 817'

The Responsible Party named above has chosen to submit GPS coordinates in lieu of preparing a new well location plat for a plugging permit on the above well. The Office of Oil & Gas will not accept GPS coordinates that do not meet the following requirements:

1. Datum: NAD 1983, Zone:17 North, Coordinate Units: meters, Altitude: height above mean sea level (MSL) - meters.
2. Accuracy to Datum - 3.05 meters
3. Data Collection Method:

Survey Grade GPS	<input type="checkbox"/>	Post Processed Differential	<input type="checkbox"/>
		Real-Time Differential	<input type="checkbox"/>
Mapping Grade GPS	<input checked="" type="checkbox"/>	Post Processed Differential	<input checked="" type="checkbox"/>
		Real-Time Differential	<input type="checkbox"/>

**RECEIVED**  
Office of Oil and Gas  
  
SEP 24 2015  
  
WV Department of  
Environmental Protection

I the undersigned, hereby certify this data is correct to the best of my knowledge and belief and shows all the information required by law and the regulations issued and prescribed by the Office of Oil and Gas.


  
Signature Michael T. Hall

President  
Title

September 2, 2015  
Date

10/23/2015

SUBJECT WELL  
M.M. Lambert No.1  
47-085-91180

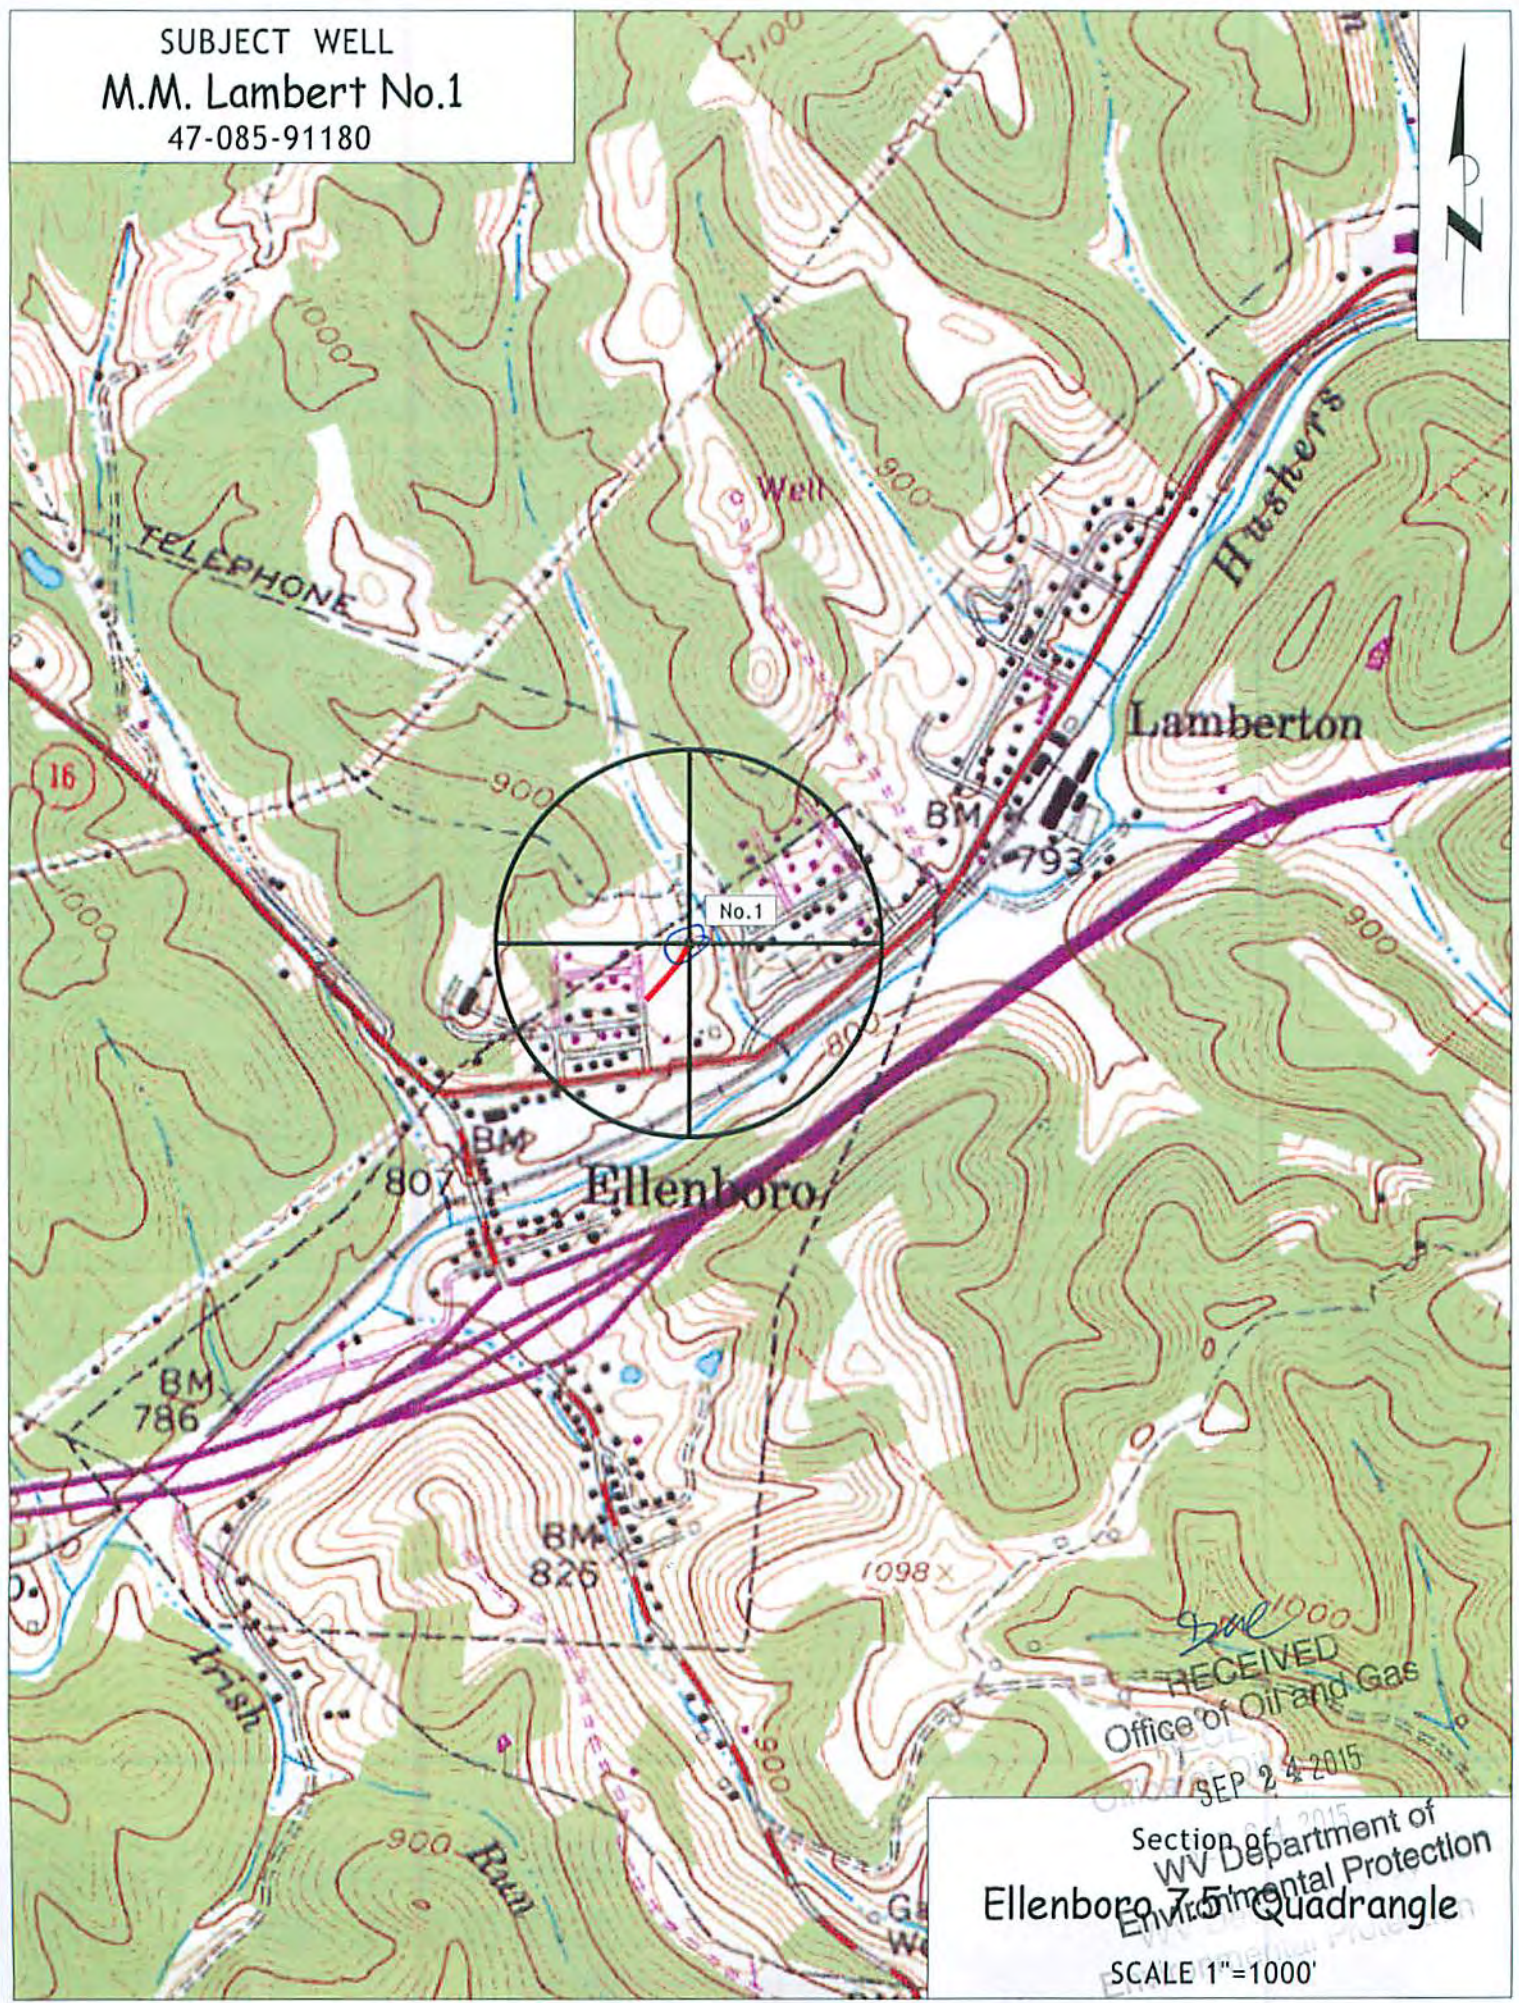

RECEIVED  
Office of Oil and Gas  
SEP 24 2015

Section of  
WV Department of  
Environmental Protection  
Ellenboro 7.5 Minute Quadrangle  
SCALE 1"=1000'