WW-7	
8-30-06	



West Virginia Department of Environmental Protection Office of Oil and Gas WELL LOCATION FORM: GPS

API:___47-085-10428______ WELL NO.: _Steel Run _(80603)_____

FARM NAME: _____Mike Ross Inc._____

RESPONSIBLE PARTY NAME: ____WVDEP COUNTY: ____Ritchie ______DISTRICT: _Grant _____

QUADRANGLE: _____Petroleum_____

SURFACE OWNER: _____Mike Ross Inc._____

ROYALTY OWNER: __ Carle & Cuthbert Heirs___

UTM GPS NORTHING:__4340070.0_____

UTM GPS EASTING:__475953.0_____ Elevation 843'

The Responsible Party named above has chosen to submit GPS coordinates in lieu of preparing a new well location plat for a plugging permit or assigned API number on the above well. The Office of Oil and Gas will not accept GPS coordinates that do not meet the following requirements:

- Datum: NAD 1983, Zone: 17 North, Coordinate Units: meters, Altitude: 1. height above mean sea level (MSL) - meters.
- 2. Accuracy to Datum - 3.05 meters
- 3. Data Collection Method:

Survey grade GPS ____: Post Processed Differential _____


Real-Time Differential

Mapping Grade GPS ____: Post Processed Differential _____

Real-Time Differential

Letter size copy of the topography map showing the well location. 4. I the undersigned, hereby certify this data is correct to the best of my knowledge and belief and shows all the information required by law and the regulations issued and prescribed by the Office of Oil and Gas.

_David Scranage Signature	Inspector Specialis	RECEIVED Office of Oil and Gas
		JUN 3 2022
Date5/12/2022		WV Department of Environmental Protection

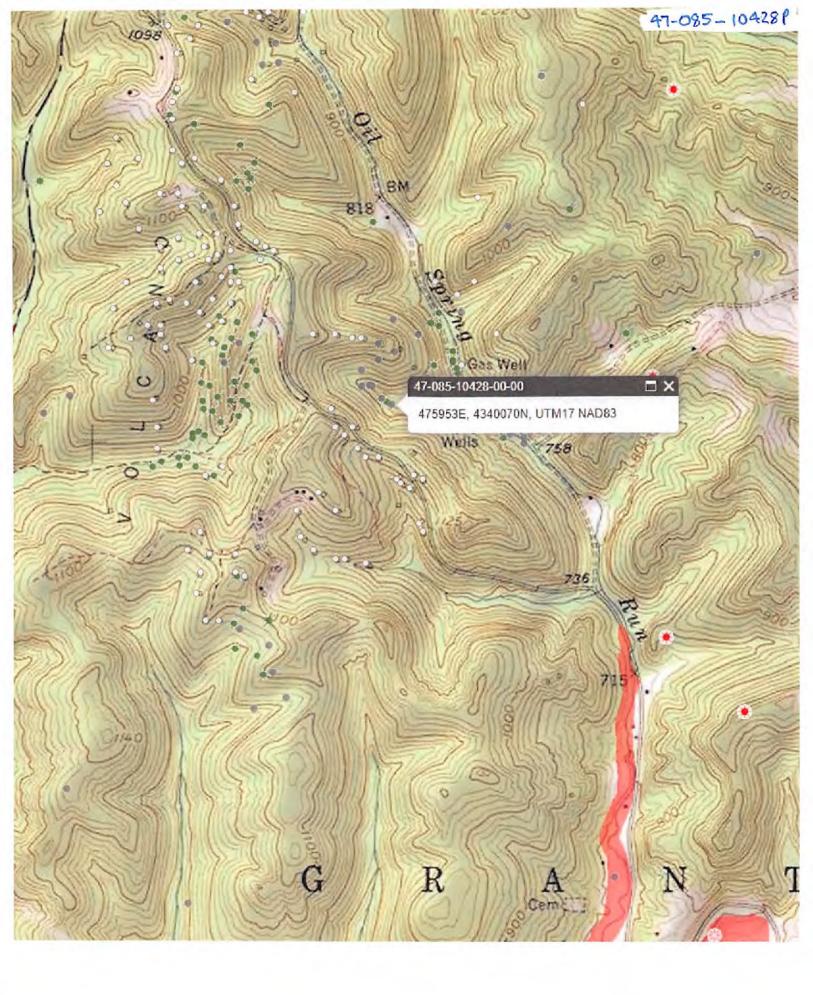

06/10/2022