

As-Drilled

LATITUDE 39°17'30"

6,009'

LATITUDE 39°15'00"

1,538' TO BOTTOM HOLE

1,753' LONGITUDE 81°00'00"

6,227' TO BOTTOM HOLE LONGITUDE 81°00'00"

Antero Resources Corporation Well No. Shipe #1H


CLAY DISTRICT - RITCHIE COUNTY
18-14-E DONALD HAYHURST
18-17-1 CAROL SPANGLER
18-20-E MICHAEL REED
18-21-E KEVIN MINOR
18-24-D DAVID LAWRENCE
24-4-1 ROGER HART
24-05 RICHARD BLOUIR
24-5-2 FREDERICK WAND III
24-29 FRANK IN OWENS
24-37-1 RODNEY WEBER
24-22 CHARLES THOMAS
24-25-1 TRIPLE B TRADING INC
24-23 D. REBECCO NICOLLOUGH
24-23-1 CLARICE BOLLAUGH
24-24 KIMBERLY BARNES
24-24-1 MATTHEW B. BLANK
24-32 ANITA WILLIAMSON
24-36-1 RONALD LANE INC
24-37 RONALD LANE INC
24-37-1 PARKS TRADING PROPERTIES LLC
24-40-1 WYDOT
24-40-2 PARKS TRADING PROPERTIES LLC
24-40-3 MICHAEL HALL
24-40-5 HILLS S WYNKOPF SUBSURFACE LLC
24-40-6 MICHAEL HALL
24-41 HALL FAMILY TRUST
24-44-1 MICHAEL HALL
24-45-1 MICHAEL HALL
24-49 RONALD LANE INC
24-04 ROBERT SHIFE
24-41 ROBERT SHIFE
24-42 ROBERT SHIFE
24-43 ROBERT SHIFE
24-44 ROBERT SHIFE
24-03 THE NATURE CONSERVANCY
24-09 ROBERT KOCH
24-10 JOHNNIE BOSTON
24-13 RICKY KOCH
24-20 THE NATURE CONSERVANCY
24-29 MARK MOSSOR
24-30 ERICA DEEM
24-31 LORRAINE RANKIN
24-31-1 CURTIS SEESE
24-47 ROBERT KOCH
24-48 RICKY KOCH
24-49 ERICA DEEM
24-50 ERICA DEEM
24-52 ERICA DEEM
24-55 ERICA DEEM
24-56 IRISTAN RAY

AS DRILLED DATA:
 WELL 1H TOP HOLE INFORMATION:
 N: 290,234ft E: 1,569,435ft
 LAT: 39°17'12.68" LON: 81°01'16.42"
 BOTTOM HOLE INFORMATION:
 N: 270,511ft E: 1,573,577ft
 LAT: 39°13'58.45" LON: 81°00'19.55"
 WEST VIRGINIA COORDINATE SYSTEM OF 1927 NORTH ZONE WAS DERIVED FROM MEASUREMENTS TAKEN WITH TRIMBLE 660XT SUBMETER MAPPING GRADE GPS UNIT. FLAT ORIENTATION, CORNER AND WELL REFERENCE TIE LINES ARE BASED ON GRID NORTH.

(NAD) 83 (UTM) ZONE 17 COORDS:
 WELL 1H TOP HOLE INFORMATION:
 N: 4,348,619m E: 498,184m
 BOTTOM HOLE INFORMATION:
 N: 4,342,632m E: 499,546m

(NAD) 27 (UTM) ZONE 17 COORDS:
 WELL 1H TOP HOLE INFORMATION:
 N: 34,266,381ft E: 1,634,410ft
 POINT OF ENTRY INFORMATION:
 N: 14,263,763ft E: 1,633,054ft
 BOTTOM HOLE INFORMATION:
 N: 14,246,737ft E: 1,638,879ft

A. TOM D. STRICHER, JR. ET UX
B. RONALD CARBON AND WIFE LORNA
C. LAUREL GROVES
D. RONALD LANE
E. RONALD LANE
F. BRUCETON FARM SERVICE, LLC
G. BRUCETON FARM SERVICE, LLC
H. TERRY LYNN SPENCER
I. PARKS & VERHART PROPERTIES, LLC
J. WYDOT, US
K. LYNNIC WELLS AND CAROL J. WELLS
L. MICHAEL T. HAD
M. HALL'S WVA WELDING EQUIPMENT, INC
N. NORMAN WATTS JR
O. WILLIAM MOORE AND MELVINA MOORE
P. WILLIAM MOORE AND MELVINA MOORE
Q. WILLIAM MOORE AND MELVINA MOORE
R. WILLIAM MOORE AND MELVINA MOORE
S. WILLIAM MOORE AND MELVINA MOORE
T. WILLIAM MOORE AND MELVINA MOORE
U. WILLIAM MOORE AND MELVINA MOORE
V. WILLIAM MOORE AND MELVINA MOORE
W. MINNIE C. RILEY
X. RIDGETOP TEN, LLC
Y. RIDGETOP TEN, LLC
Z. RIDGEWOOD DEVELOPMENT, LLC
AA. RIDGEWOOD DEVELOPMENT, LLC
AB. RIDGEWOOD DEVELOPMENT, LLC
AC. THE NATURE CONSERVANCY
AD. DRUGLESS FROM BUS LINDA G. BO
AE. W. A. B. SHARROCK, D.D.A.
AF. W. A. B. SHARROCK, D.D.A.
AG. JAMES RICHARD SMILEY
AH. VIRGINIA L. DONOVAN
AI. AGNES I. ROGERS
AJ. FRANKLIN HARRIS FAMILY TRUST
AK. FRANKLIN HARRIS FAMILY TRUST
AL. FRANKLIN HARRIS FAMILY TRUST
AM. FRANKLIN HARRIS FAMILY TRUST
AN. TOM D. STRICHER, JR. ET UX
AO. CLARENCE J. MCCOY AND STIM
AP. CLARENCE J. MCCOY AND STIM
AQ. TOM D. STRICHER, JR. ET UX
AR. EDWARD ROBERT ET AL
AS. WILLIAM MOORE ET AL
AT. CHARLES B. BROADWATER
AU. WEST VIRGINIA DIVISION OF MINERAL INDUSTRIES

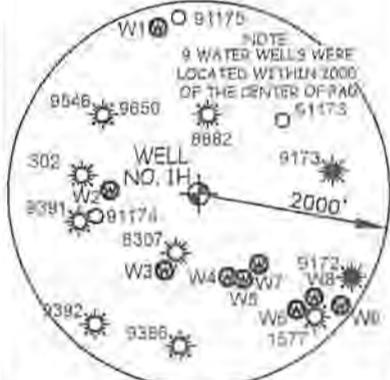

WELL	BEARING	DISTANCE
W1	S 13°36' E	1772.1'
W2	N 87°26' W	929.2'
W3	S 24°40' W	854.4'
W4	S 19°28' E	906.8'
W5	S 27°55' E	993.1'
W6	S 40°30' E	1536.5'
W7	N 40°45' W	960.8'
W8	S 48°22' E	1604.1'
W9	S 52°09' E	1872.9'

I THE UNDERSIGNED, HEREBY CERTIFY THAT THIS PLAT IS CORRECT TO THE BEST OF MY KNOWLEDGE AND BELIEF AND SHOWS ALL THE INFORMATION REQUIRED BY LAW AND THE RULES ISSUED AND PERSCRIBED BY THE DEPARTMENT OF ENVIRONMENTAL PROTECTION.



STATE OF WEST VIRGINIA, DIVISION OF ENVIRONMENTAL PROTECTION, OFFICE OF OIL AND GAS
 WILLOW LAND SURVEYING PLLC
 220 MASONIC AVE. PENNSBORO WEST VIRGINIA 26416



JOB # 23-010WA
 DRAWING # SHIPENAD
 SCALE 1" = 2000'
 MINIMUM DEGREE OF ACCURACY SUBMETER
 PROVEN SOURCE OF ELEV. SUBMETER MAPPING GRADE GPS
 STATE OF WEST VIRGINIA DEPARTMENT OF ENERGY DIVISION OF OIL AND GAS

LEGEND
 --- Surface Owner Boundary Lines +/-
 --- Interior Surface Tracts +/-
 --- Proposed Well Path
 O As Drilled Well Path

THOMAS SUMMERS P.S. 2109
 DATE 11/12/25
 OPERATOR'S WELL# SHIPE UNIT #1H
 47 - 085 - 10539
 STATE COUNTY PERMIT



WELL TYPE: OIL ___ GAS X LIQUID INJECTION ___ WASTE DISPOSAL
 (IF "GAS") PRODUCTION X STORAGE ___ DEEP SHALLOW
 LOCATION: ELEVATION AS BUILT - 1,007' WATERSHED NORTH FORK HUGHES RIVER
 QUADRANGLE ELLENBORO 7.5' DISTRICT CLAY COUNTY RITCHIE
 SURFACE OWNER RICHARD E BLOUIR ET UX ACREAGE 53.682 ACRES +/-
 OIL & GAS ROYALTY OWNER AGNES I. ROGERS LEASE ACREAGE 57 ACRES +/-
 PROPOSED WORK: DRILL ___ CONVERT ___ DRILL DEEPER ___ REDRILL ___
 FRACTURE OR STIMULATE ___ PLUG OFF OLD FORMATION PERFORATE NEW
 FORMATION ___ OTHER PHYSICAL CHANGE IN WELL (SPECIFY) AS DRILLED
 PLUG & ABANDON ___ CLEAN OUT & REPLUG ___
 TARGET FORMATION MARCELLUS ESTIMATED DEPTH 6,276 TVD / 25,079' MD
 WELL OPERATOR ANTERO RESOURCES CORP DESIGNATED AGENT CONRAD BASTON
 ADDRESS 1615 WYNKOPF ST ADDRESS 535 WHITE OAKS BLVD
 DENVER, CO 80202 BRIDGEPORT, WV 26330

DATE 11/12/25
 1. THIS DOCUMENT IS THE PROPERTY OF THE SURVEYOR AND SHOULD BE KEPT IN HIS OR HER OFFICE.
 2. THIS DOCUMENT IS NOT TO BE REPRODUCED OR TRANSMITTED IN ANY FORM OR BY ANY MEANS, ELECTRONIC OR MECHANICAL, INCLUDING PHOTOCOPYING, RECORDING, OR BY ANY INFORMATION STORAGE AND RETRIEVAL SYSTEM, WITHOUT THE WRITTEN PERMISSION OF THE SURVEYOR.
 3. FOR ALL DATA, SURVEYING, AND PROFESSIONAL SERVICES, THE SURVEYOR ASSUMES RESPONSIBILITY FOR THE ACCURACY OF THE DATA AND THE RESULTS THEREOF.
 4. THE SURVEYOR IS NOT RESPONSIBLE FOR THE DATA AND THE RESULTS THEREOF IF THE CLIENT PROVIDES INADEQUATE DATA OR INFORMATION.
 5. THE SURVEYOR IS NOT RESPONSIBLE FOR THE DATA AND THE RESULTS THEREOF IF THE CLIENT PROVIDES INADEQUATE DATA OR INFORMATION.
 6. THE SURVEYOR IS NOT RESPONSIBLE FOR THE DATA AND THE RESULTS THEREOF IF THE CLIENT PROVIDES INADEQUATE DATA OR INFORMATION.

2026/06/02

As-Drilled

LATITUDE 39°17'30"

6,009'

LATITUDE 39°15'00"

1,538' TO BOTTOM HOLE

1,753' LONGITUDE 81°00'00"

6,227' TO BOTTOM HOLE LONGITUDE 81°00'00"

Antero Resources Corporation Well No. Shipe #1H

Table listing landowners in Clay District - Ritchie County, including names like Ronald Hayhurst, Michael Reed, and Robert Shipe.

AS DRILLED DATA: WELL 1H TOP HOLE INFORMATION: N: 290,234ft E: 1,569,435ft LAT: 39°17'12.68" LON: 81°01'16.42" BOTTOM HOLE INFORMATION: N: 270,511ft E: 1,573,577ft LAT: 39°13'58.45" LON: 81°00'19.55" WEST VIRGINIA COORDINATE SYSTEM OF 1927 NORTH ZONE. ZONE WAS DERIVED FROM MEASUREMENTS TAKEN WITH TRIMBLE GEOXT SUBMETER MAPPING GRADE GPS UNIT. PLAT ORIENTATION, CORNER, AND WELL REFERENCE TIE LINES ARE BASED ON GRID NORTH.

(NAD) 83 (UTM) ZONE 17 COORDS: WELL 1H TOP HOLE INFORMATION: N: 4,348,619m E: 498,184m BOTTOM HOLE INFORMATION: N: 4,342,632m E: 499,546m

(NAD) 27 (UTM) ZONE 17 COORDS: WELL 1H TOP HOLE INFORMATION: N: 14,266,381ft E: 1,634,410ft POINT OF ENTRY INFORMATION: N: 14,263,763ft E: 1,633,034ft BOTTOM HOLE INFORMATION: N: 14,246,737ft E: 1,638,879ft

Table listing well identifiers and owners, such as TOM G. STRICKLER, JR. ET UX, FRANKLIN OWENS AND ANNE I OWENS, and LAURA GAIL GROVES.

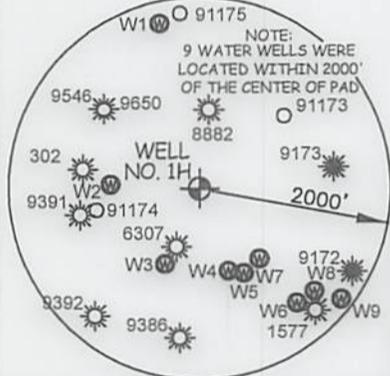


Table listing water wells W1 through W9 with their coordinates and elevations.



I THE UNDERSIGNED, HEREBY CERTIFY THAT THIS PLAT IS CORRECT TO THE BEST OF MY KNOWLEDGE AND BELIEF AND SHOWS ALL THE INFORMATION REQUIRED BY LAW AND THE RULES ISSUED AND PERSERIBED BY THE DEPARTMENT OF ENVIRONMENTAL PROTECTION.



STATE OF WEST VIRGINIA, DIVISION OF ENVIRONMENTAL PROTECTION, OFFICE OF OIL AND GAS. WILLOW LAND SURVEYING PLLC, 220 MASONIC AVE. PENNSBORO WEST VIRGINIA 26415

JOB # 23-010WA DRAWING # SHIPE1HAD SCALE 1" = 2000' MINIMUM DEGREE OF ACCURACY SUBMETER PROVEN SOURCE OF ELEV. SUBMETER MAPPING GRADE GPS STATE OF WEST VIRGINIA DEPARTMENT OF ENERGY DIVISION OF OIL AND GAS

LEGEND: Surface Owner Boundary Lines +/-, Interior Surface Tracts +/-, Proposed Well Path, As Drilled Well Path. THOMAS SUMMERS P.S. 2109 DATE 11/12/25 OPERATOR'S WELL# SHIPE UNIT #1H 47 - 085 - 10539 STATE COUNTY PERMIT

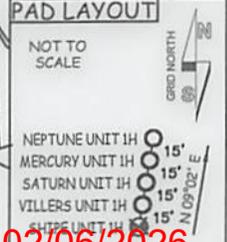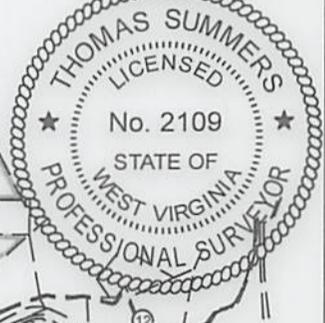

WELL TYPE: OIL GAS X LIQUID INJECTION WASTE DISPOSAL (IF "GAS") PRODUCTION X STORAGE DEEP SHALLOW LOCATION: ELEVATION AS BUILT - 1,007' WATERSHED NORTH FORK HUGHES RIVER QUADRANGLE ELLENBORO 7.5 DISTRICT CLAY COUNTY RITCHIE SURFACE OWNER RICHARD E. BLOUIR ET UX ACREAGE 53.682 ACRES +/- OIL & GAS ROYALTY OWNER AGNES L. ROGERS LEASE ACREAGE 57 ACRES +/- PROPOSED WORK: DRILL CONVERT DRILL DEEPER REDRILL FRACTURE OR STIMULATE PLUG OFF OLD FORMATION PERFORATE NEW FORMATION OTHER PHYSICAL CHANGE IN WELL (SPECIFY) AS DRILLED PLUG & ABANDON CLEAN OUT & REPLUG TARGET FORMATION MARCELLUS ESTIMATED DEPTH 6,276' TVD 25,079' MD WELL OPERATOR ANTERO RESOURCES CORP. DESIGNATED AGENT CONRAD BASTON ADDRESS 1615 WYNKOOP ST. ADDRESS 535 WHITE OAKS BLVD FORM WW-6 DENVER, CO 80202 BRIDGEPORT, WV 26330

- NOTE: 1. NO OCCUPIED DWELLINGS OR BUILDINGS... 2. TOP HOLE DATA SHOWN HEREON WAS PROVIDED BY ANTERO RESOURCES CORPORATION... 3. AS DRILLED DATA WAS PROVIDED BY ANTERO RESOURCES CORPORATION... 4. WLS IS NOT CERTIFYING THE DATA AND INFORMATION PROVIDED LISTED IN NOTES 2 AND 3... 5. WLS IS BY NO MEANS RESPONSIBLE FOR ANY ERRORS OR INACCURACIES WITH THE DATA AND INFORMATION THAT HAS BEEN PROVIDED.