



Antero Resources Corporation
Appalachian Basin
Minear Pad
Ritchie County

RECEIVED
Office Of Oil and Gas
JAN 05 2026

Quadrangle: Pullman
Watershed: South Fork Hughes River
District: Union
Date: 10-24-2023

WV Department of
Environmental Protection

02/13/2026

Antero Resources Corporation Well No. Wilburn #1H

UNION DISTRICT - RITCHIE COUNTY	
7-13	Dawn McLaughlin
7-14	Wayne & Delphene Haddox
7-15	Louis Daniel Easterday Revocable Living Trust
7-16	Louis D Easterday
7-18	Louis D Easterday
7-19	Max & Laura Dodd
8-1	Danny Haddox Et Al
8-1.1	Danny Haddox Et Al
8-1.2	Danny Haddox Et Al
8-1.3	Wayne & Delphene Haddox
8-1.4	David Haddox
8-1.6	David Haddox
8-8	David Haddox
12-2	Phillip & Sharon Estep
12-2.1	Haught Farm LLC
12-2.2	Donald J. Ensminger, III
12-6	Robert & Dorothy Layton
12-6.1	Robert & Dorothy Layton
12-7	Louis Daniel Easterday Revocable Living Trust
12-7.1	Louis Daniel Easterday Revocable Living Trust
12-12	Anthony & Steven Riddle
12-13	Clay Mossor & Victoria McGinnis
13-1	David & Rose Cox
13-1.1	David & Rose Cox
CLAY DISTRICT - RITCHIE COUNTY	
40-15	Wayne & Delphene Haddox
40-17	Duane Riggs

LEASES	
1	DANIEL HADDOX AND CLARETH HADDOX
3	DAVID L. COX AND ROSE E. COX
64	SARAH C. HOWARD
65	NORMA C. DAWSON
66	KENNETH B. PERINE AND PATRICIA PERINE
67	JOSEPH A. HOWARD
68	JOYCE ANN HOWARD

LATITUDE 39°12'30"

9,595' TO BOTTOM HOLE

NOTES:
 WELL 1H TOP HOLE INFORMATION:
 N: 258,273ft E: 1,586,681ft
 LAT: 39°11'59.64" LON: 80°57'30.51"
 BOTTOM HOLE INFORMATION:
 N: 258,069ft E: 1,588,932ft
 LAT: 39°11'57.98" LON: 80°57'01.88"
 WEST VIRGINIA COORDINATE SYSTEM OF 1927 NORTH ZONE. ZONE WAS DERIVED FROM MEASUREMENTS TAKEN WITH TRIMBLE GEOXT SUBMETER MAPPING GRADE GPS UNIT. PLAT ORIENTATION, CORNER, AND WELL REFERENCE TIE LINES ARE BASED ON GRID NORTH.

(NAD) 83 (UTM) ZONE 17 COORDS:
 WELL 1H TOP HOLE INFORMATION:
 N: 4,338,970m E: 503,600m
 BOTTOM HOLE INFORMATION:
 N: 4,338,919m E: 504,287m



(NAD) 27 (UTM) ZONE 17 COORDS:
 WELL 1H TOP HOLE INFORMATION:
 N: 14,234,724ft E: 1,652,181ft
 POINT OF ENTRY INFORMATION:
 N: 14,235,030ft E: 1,654,272ft
 BOTTOM HOLE INFORMATION:
 N: 14,234,557ft E: 1,654,434ft

WV NORTH ZONE GRID NORTH

3,071'

LONGITUDE 80°57'30"

3,240' TO BOTTOM HOLE LONGITUDE 80°55'00"

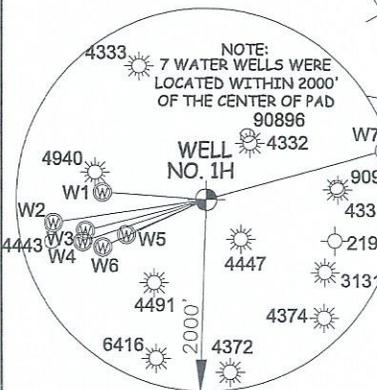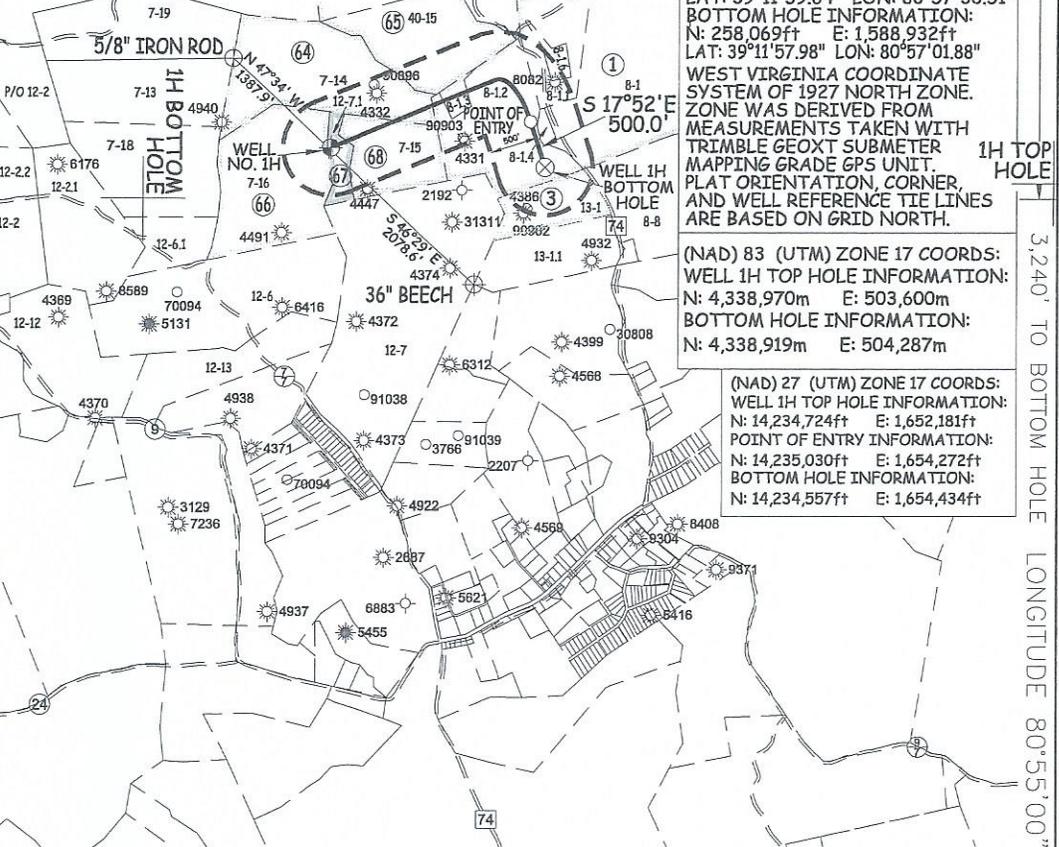

WATER WELLS		
W1	S 86°08' E	1093.5'
W2	S 81°22' W	1624.9'
W3	S 75°32' W	1309.4'
W4	S 71°11' W	1368.5'
W5	S 66°20' W	914.7'
W6	S 65°21' W	1193.6'
W7	N 74°39' E	1936.7'

I THE UNDERSIGNED, HEREBY CERTIFY THAT THIS PLAT IS CORRECT TO THE BEST OF MY KNOWLEDGE AND BELIEF AND SHOWS ALL THE INFORMATION REQUIRED BY LAW AND THE RULES ISSUED AND PERSCRIBED BY THE DEPARTMENT OF ENVIRONMENTAL PROTECTION.





STATE OF WEST VIRGINIA, DIVISION OF ENVIRONMENTAL PROTECTION, OFFICE OF OIL AND GAS

WILLOW LAND SURVEYING PLLC
 220 MASONIC AVE. PENNSBORO WEST VIRGINIA 26415


JOB # 25-020WA
 DRAWING # WILBURN1HS
 SCALE 1" = 2000'
 MINIMUM DEGREE OF ACCURACY SUBMETER
 PROVEN SOURCE OF ELEV. SUBMETER MAPPING GRADE GPS
 STATE OF WEST VIRGINIA DEPARTMENT OF ENERGY DIVISION OF OIL AND GAS

LEGEND
 — — — — — Surface Owner Boundary Lines +/-
 - - - - - Adjoining Surface Tracts +/-
 ⊕ Found monument, as noted

DOUGLAS R. ROWE, P.S. 2202
 DATE 12/30/25
 OPERATOR'S WELL# WILBURN UNIT #1H
 47 — 085 — 10579
 STATE COUNTY PERMIT

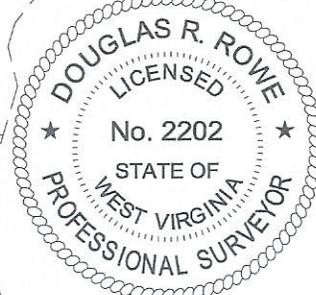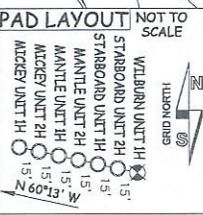

WELL TYPE: OIL ___ GAS X LIQUID INJECTION ___ WASTE DISPOSAL (IF "GAS") PRODUCTION X STORAGE ___ DEEP ___ SHALLOW
 LOCATION: ELEVATION AS BUILT - 1,097' WATERSHED SOUTH FORK HUGHES RIVER
 QUADRANGLE PULLMAN 7.5' DISTRICT UNION COUNTY RITCHIE
 SURFACE OWNER LOUIS DANIEL EASTERDAY REVOCABLE LIVING TRUST ACREAGE 5.25 ACRES +/-
 OIL & GAS ROYALTY OWNER JOSEPH A. HOWARD LEASE ACREAGE 5.25 ACRES±
 PROPOSED WORK: DRILL X CONVERT ___ DRILL DEEPER ___ REDRILL ___
 FRACTURE OR STIMULATE X PLUG OFF OLD FORMATION PERFORATE NEW
 FORMATION ___ OTHER PHYSICAL CHANGE IN WELL (SPECIFY) ___
 PLUG & ABANDON ___ CLEAN OUT & REPLUG ___
 TARGET FORMATION MARCELLUS ESTIMATED DEPTH 6,900' TVD 10,500' MD
 WELL OPERATOR ANTERO RESOURCES CORP. DESIGNATED AGENT CONRAD BASTON
 ADDRESS 1615 WYNNKOOP ST. ADDRESS 535 WHITE OAKS BLVD
 DENVER, CO 80202 BRIDGEPORT, WV 26330

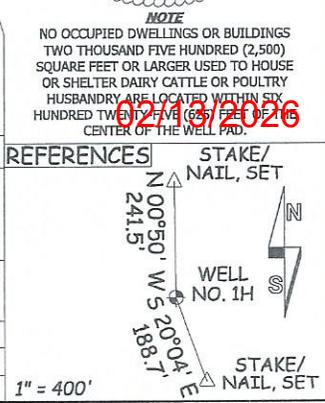

REFERENCES

STAKE/ NAIL, SET
 N 00°50' W 2000.7'
 W 5 1881.7'
 WELL NO. 1H
 STAKE/ NAIL, SET
 1" = 400'

NOTE
 NO OCCUPIED DWELLINGS OR BUILDINGS TWO THOUSAND FIVE HUNDRED (2,500) SQUARE FEET OR LARGER USED TO HOUSE OR SHELTER DAIRY CATTLE OR POULTRY HUSBANDRY ARE LOCATED WITHIN SIX HUNDRED TWENTY FIVE (625) FEET OF CENTER OF THE WELL PAD.
 02/13/2026