


0 1 2 3 LATITUDE 39° 15'

1

2

3

LONGITUDE 81° 00'

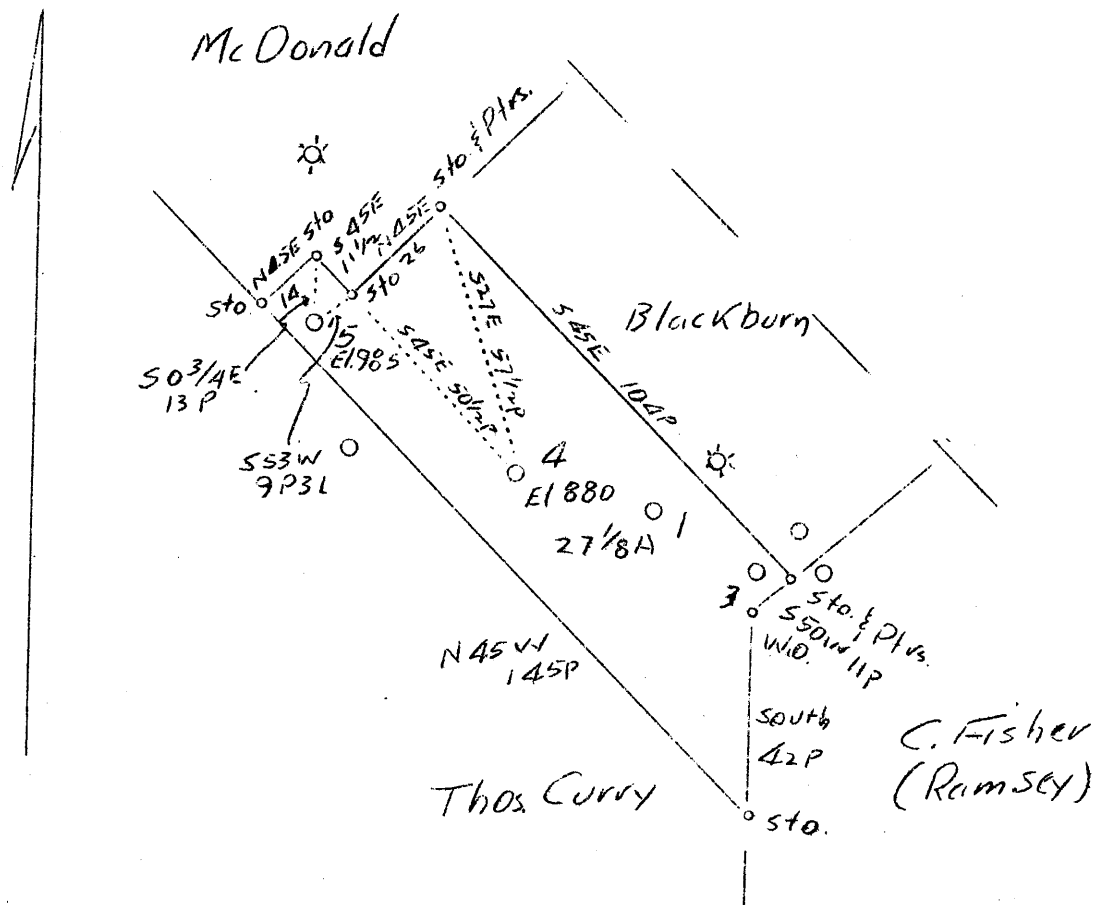

No 4	2.58W
	1.06S
No 5	2.69W
	0.98S

Abds.

Company	Reno Oil Co.
Address	Sistersville, W.Va.
Farm	John Keith
Tract	Acres 27 1/8 Lease No.
Well (Farm) No.	4 & 5 Serial No.
Elevation (Spirit Level)	880', 985'
Quadrangle	Harrisville <b>NE.</b>
County	Ritchie District Clay
Engineer	O.W. Barnhart
Engineer's Registration No.	
File No.	Drawing No.
Date	Feb. 2, 1938 Scale 1"-40 P.

STATE OF WEST VIRGINIA  
 Department of Mines  
 OIL AND GAS DIVISION  
 CHARLESTON

WELL LOCATION MAP  
 File No. **RIT-341A & 342A**

+ Denotes location of well on United States Topographic Maps, scale 1 to 62,500, latitude and longitude lines being represented by border lines as shown.

— Denotes one inch spaces on border line of original tracing.

**RECEIVED**  
**FEB 22 1938**  
**STATE OF VIRGINIA**  
**GEOLOGICAL SURVEY**