


Company Consumers Utility Co.  
 Address Pennsboro, W.Va.  
 Farm Roscoe Beall  
 Tract Acres 163.8 Lease No.  
 Well (Farm) No. 2 Serial No.  
 Elevation ( Spirit Level\* 102'  
 Quadrangle Harrisville N.W.  
 County Ritchie District Grant  
 Engineer B.J. Rinhart  
 Engineer's Registration No. 648  
 File No. Drawing No. 159-G-R  
 Date April 23, 1938 Scale 1"=500'

STATE OF WEST VIRGINIA  
 Department of Mines  
 OIL AND GAS DIVISION  
 CHARLESTON  
  
 WELL LOCATION MAP  
 File No. Rit-351-A  
  
 Denotes location of well on United States Topographic Maps, scale 1 to 62,500, latitude and longitude lines being represented by border lines as shown.  
  
 Denotes one inch spaces on border line of original tracing.

UNITED STATES DEPARTMENT OF AGRICULTURE  
BUREAU OF PLANT INDUSTRY  
WASHINGTON, D. C.

REPORT OF THE  
PLANT INDUSTRY SURVEY  
CONDUCTED BY  
DR. J. H. WOODWARD  
AND  
DR. J. H. WOODWARD

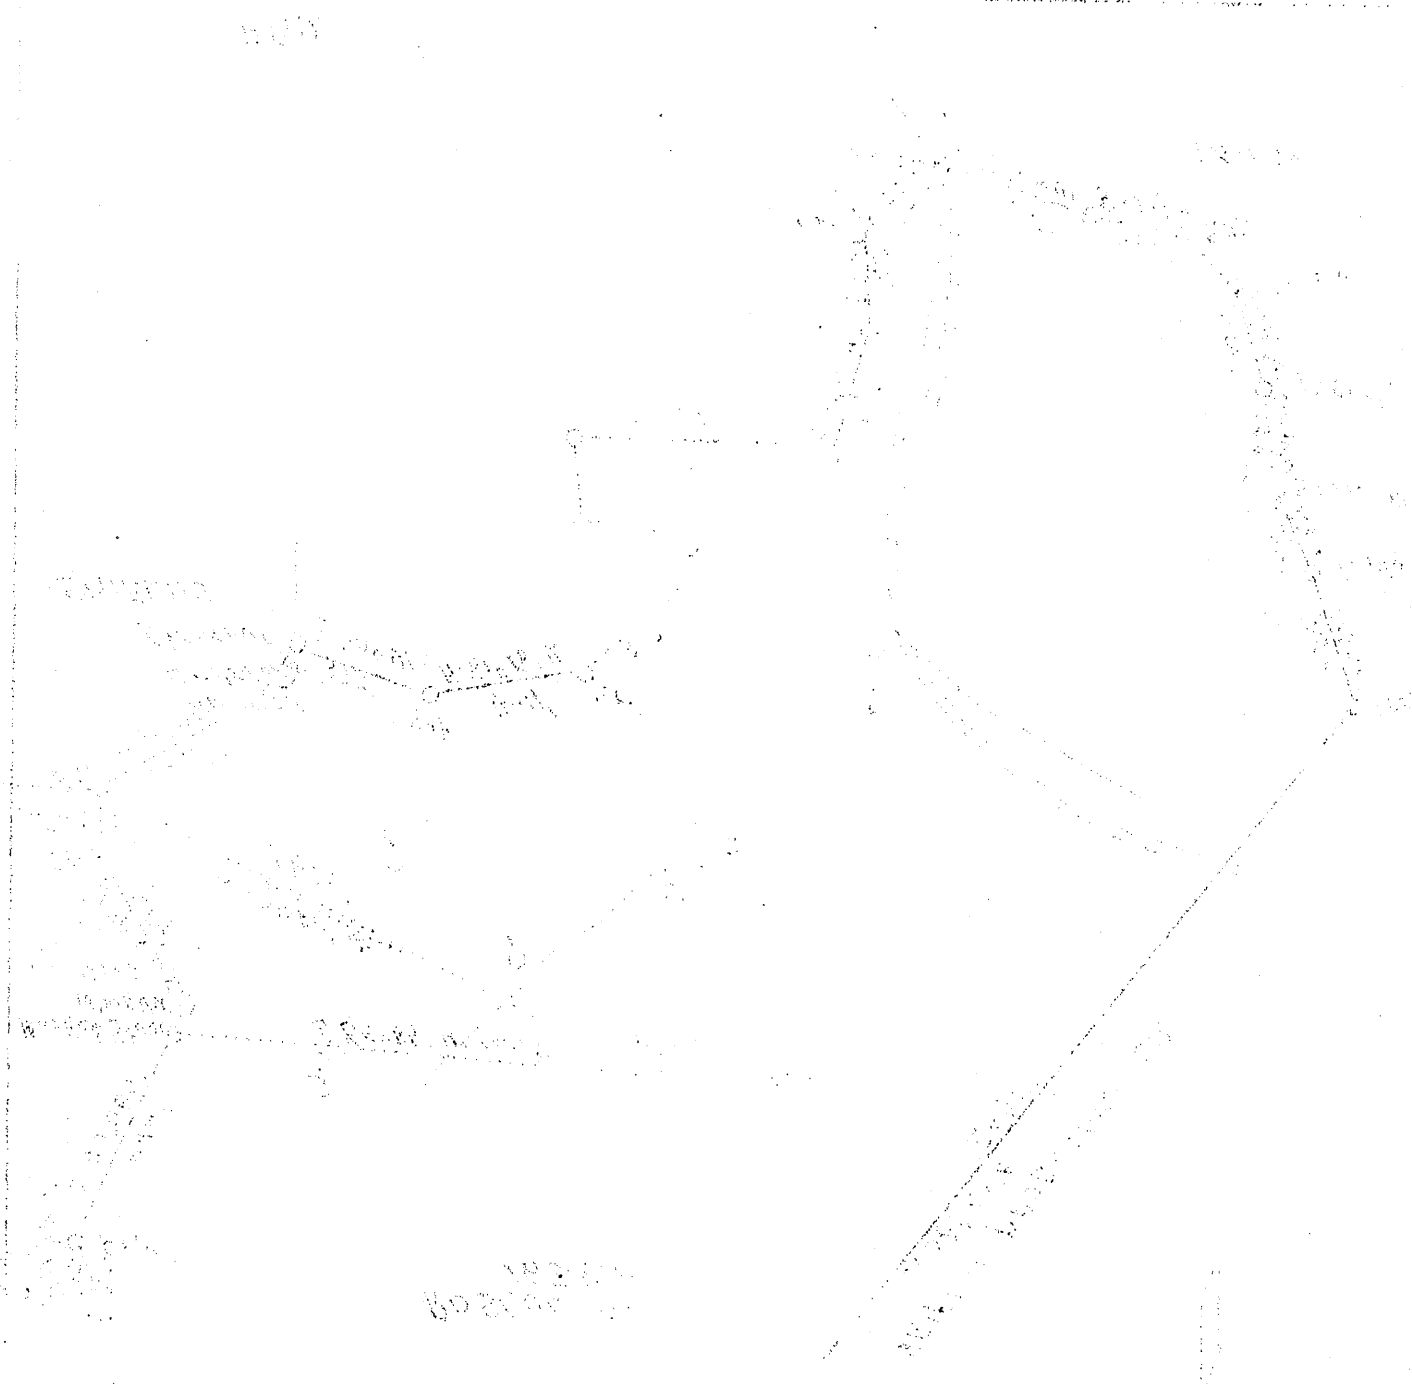

**RECEIVED**  
MAY 2 1938  
WAS. FIELD STATION  
REGIONAL SURVEY