

1,44 W  
5,38 Q

✓ SEP - 5 1938

ABANDONMENT

F.B. 665 R.9 S14 W18 Sh 80 or 81

Company	Hope Natural Gas Co.
Address	Clarksburg, W. Va.
Farm	M. V. Haught
Acres	46
Well (Farm) No.	1
Serial No.	5248
Elevation (SP)	944
Quadrangle	Harrisville
County	Ritchie
District	Murphy
Engineer	J. R. Clark
Eng. Reg. No.	744
Date	August 26, 1938
Scale	1" = 400'

Ⓢ

STATE OF WEST VIRGINIA  
Department of Mines  
OIL & GAS DIVISION  
Charleston

WELL LOCATION MAP

File No. RII-371-A

x Denotes location of well on U. S. Topographic Maps, scale 1 to 62,500, latitude and longitude lines being represented by border lines as shown.

- Denotes one inch spaces on border line of original tracing.

Murphy District, Ritchie County, W. Va.  
 By Hope Natural Gas Co., Clarksburg, W. Va.  
 On 46 acres, on Indian Creek.  
 Elevation, 944' L.  
 Surface owned by Bessie B. Remroad, Smithville, W. Va.  
 Drilling commenced 8-22-1918; completed, 9-30-1918.  
 Sept, Sept. 30, 1918, in Big Injun Sand.  
 No fresh water recorded. Salt water at 1747'.  
 10" casing, 146' (pulled); 8", 1010'; 6", 1823'; 2" tubing,  
 1929' (pulled).  
 Casing not cemented. No coal was encountered.  
 Gas well. Abandonment reported to Dept. of Mines Aug. 26, 1938.  
 Record to RCT from Mrs. Griffith Sept. 22, 1938.

	Top.	Bottom.
Little Dunkard Sand	900	- 920
Big Dunkard Sand	1005	- 1015
Gas Sand (gas, 1254-1350')	1241	- 1362
First Salt Sand	1454	- 1585
Second Salt Sand (gas, 1710')	1600	- 1715
Marion Sand (water, 1747')	1731	- 1763
Little Line	1764	- 1795
Pencil Cove	1795	- 1802
Big Line	1802	- 1884
Big Injun Sand (gas, 1896')	1884	- 1942
Total depth		1944

WEST VIRGINIA DEPARTMENT OF MINES  
OIL AND GAS DIVISION

429

WELL RECORD

AB 371-A


Oil or Gas Well **Gas**  
(Kind)

Company **Hope Natural Gas Company**  
 Address **Clarksburg, W. Va.**  
 Farm **M. V. Haught** Acres **45**  
 Location (waters) **Indian Creek**  
 Well No. **5248** Elev. **944**  
 District **Murphy** County **Ritchie**  
 The surface of tract is owned in fee by **Bessie B. Rexroad**  
 Address **Smithville, W.Va.**  
 Mineral rights are owned by \_\_\_\_\_  
 Address \_\_\_\_\_  
 Drilling commenced **8-22-1918**  
 Drilling completed **9-30-1918**  
 Date shot **Sept. 30-1918** Depth of shot **Injun**  
 Open Flow /10ths Water in \_\_\_\_\_ Inch  
 /10ths Merc. in \_\_\_\_\_ Inch  
 Volume \_\_\_\_\_ Cu. Ft.  
 Rock Pressure \_\_\_\_\_ lbs. \_\_\_\_\_ hrs.  
 Oil \_\_\_\_\_ bbls., 1st 24 hrs.  
 Fresh water **None recorded** feet \_\_\_\_\_ feet  
 Salt water **None recorded** feet **1747** feet

Casing and Tubing	Used in Drilling	Left in Well	Packers
Size			
16			Kind of Packer
13			
10	146	Pulled	Size of
8 1/4	1010	1010	
6 5/8	1823	1823	Depth set
5 3/16			
3			Perf. top
2	1929	Pulled	Perf. bottom
Liners Used			Perf. top
			Perf. bottom

CASING CEMENTED \_\_\_\_\_ SIZE \_\_\_\_\_ No. FT. \_\_\_\_\_ Date \_\_\_\_\_  
**Not cemented**  
 COAL WAS ENCOUNTERED AT \_\_\_\_\_ FEET \_\_\_\_\_ INCHES  
**No coal**  
 \_\_\_\_\_ FEET \_\_\_\_\_ INCHES \_\_\_\_\_ FEET \_\_\_\_\_ INCHES  
 \_\_\_\_\_ FEET \_\_\_\_\_ INCHES \_\_\_\_\_ FEET \_\_\_\_\_ INCHES


Formation	Color	Hard or Soft	Top	Bottom	Oil Gas or Water	Depth Found	Remarks
Little Dunkard Sand			900	920			
Big Dunkard Sand			1005	1015			
Gas Sand			1241	1362	Gas	1254-1350	
First Salt Sand			1454	1585			
Second Salt Sand			1600	1715	Gas	1710	
Maxon Sand			1731	1763	Water	1747	
Little Lime			1764	1795			
Pencil Cave			1795	1802			
Big Lime			1802	1884			
Big Injun Sand			1884	1942	Gas	1896	
Total Depth				1944			

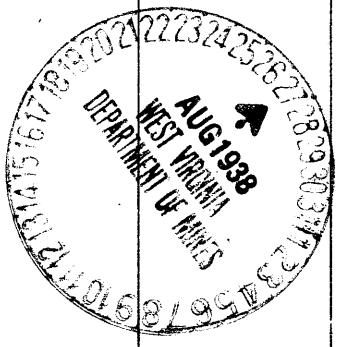

Formation	Color	Hard or Soft	Top	Bottom	Oil, Gas or Water	Depth Found	Remarks

Date August 26, \_\_\_\_\_, 1938

APPROVED Hope Natural Gas Company, Owner

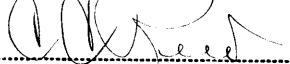By  Asst. General Supt.  
 (Title) On