


LATITUDE 39° 15'

LONGITUDE 81° 10'

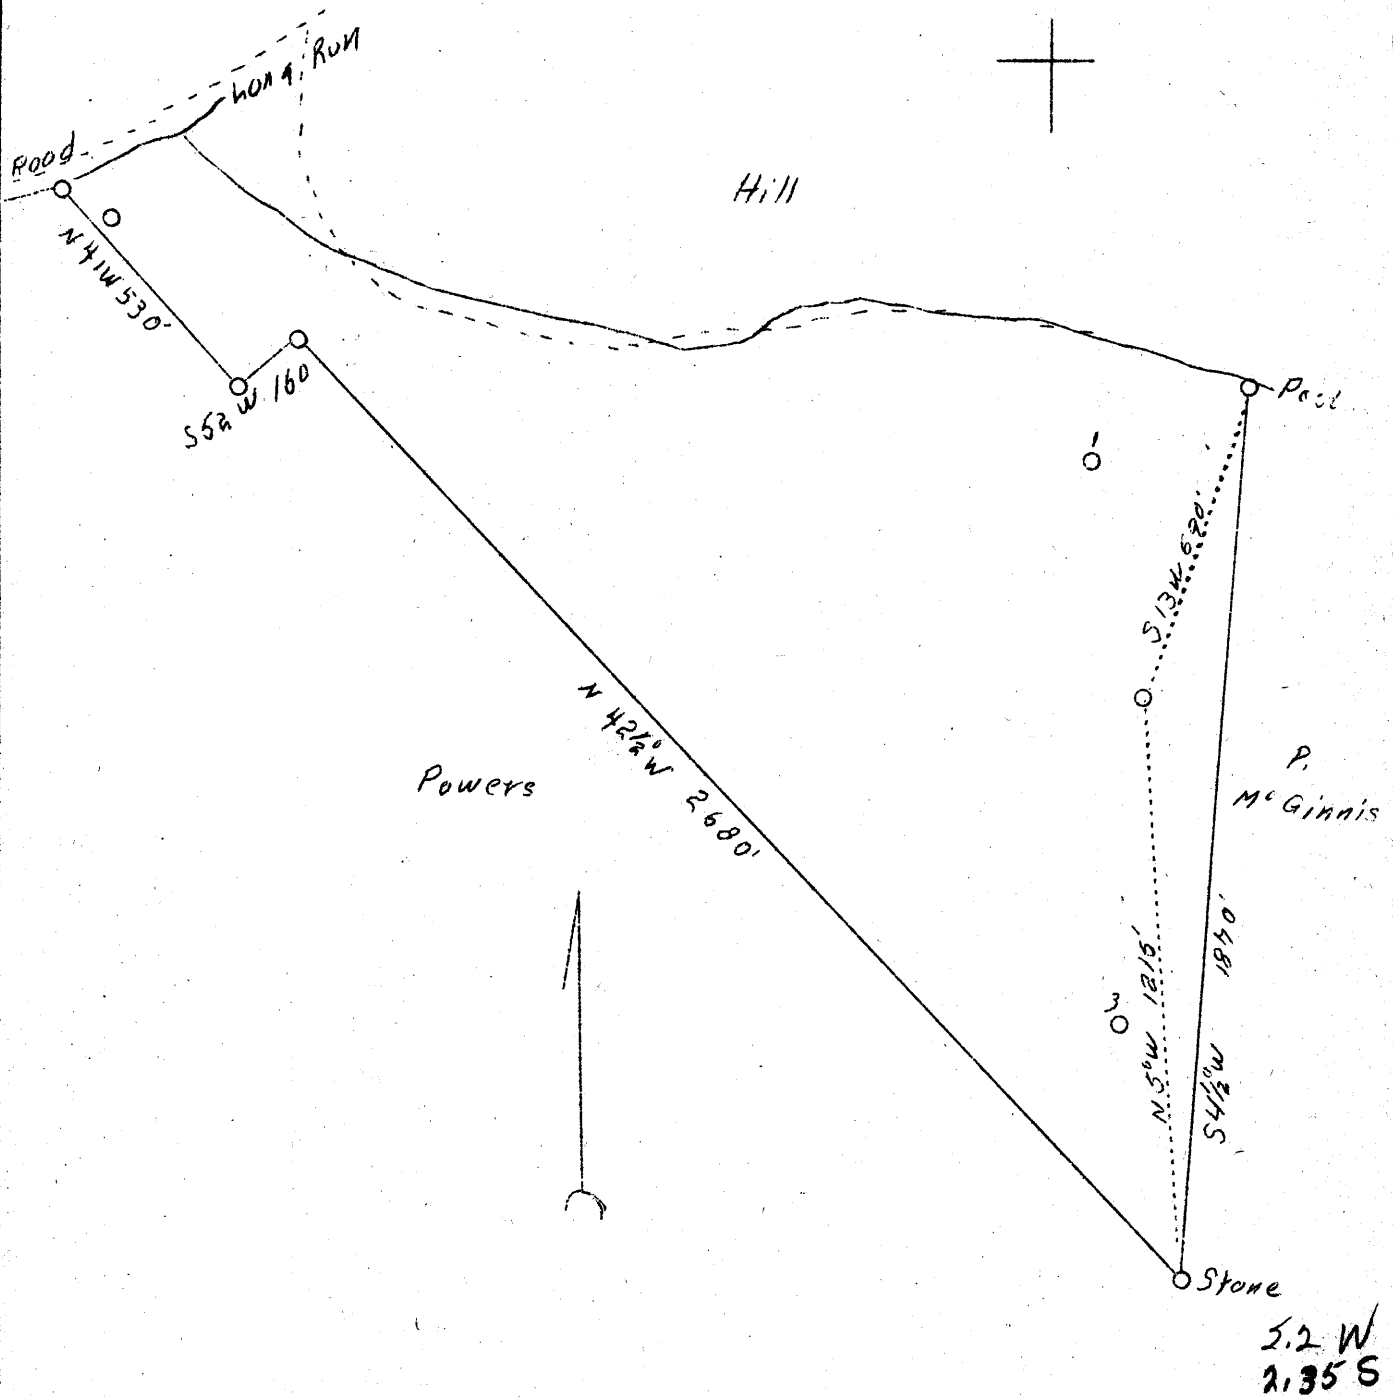

ABD.

Company	Bickle Oil Co.
Address	Parkersburg, W. Va.
Fam	H. L. McGinnis
Acres	50
Well (Fam) No.	Two
Elevation (SP)	1059
Quadrangle	Harrisville <i>N. W</i>
County	Ritchie
District	Grant
Engineer	O. Meredith
Date	Sept. 17, 1938
Scale	400' to 1 inch

STATE OF WEST VIRGINIA
 Department of Mines
 OIL & GAS DIVISION
 Charleston

WELL LOCATION MAP

File No. Rit-374-A

x Denotes location of well on U. S. Topographic maps, scale 1 to 62,500, latitude and longitude lines being represented by border lines as shown.

- Denotes one inch spaces on border line of original tracing.