

Company Earl Goodwin
 Address June Lew, W. Va.
 Farm ^{Fairview} Methodist Church ^[Hazel Green]
 Tract 1 Acres $\frac{87}{100}$ Lease No
 Well (Farm) No. 1 Serial No. 1
 Quadrangle Holbrook
 County Ritchie
 District Murphy
 Engineer M. A. Klinger
 Engineer's Registration No. 261
 Elevation (Spirit Level) 775.0
 File No. Drawing No.
 Date June 24, 1940 Scale: 1 inch = 40 Ft.

STATE OF WEST VIRGINIA
 DEPARTMENT OF MINES
 OIL AND GAS DIVISION
 CHARLESTON, W. VA

WELL LOCATION MAP
 FILE No. RIT-459A

+ Denotes location of well on United States Topographic Maps. Scale 1 to 62,500. Latitude and Longitude lines being represented by border lines as shown.

= Denotes one inch spaces on border line of original tracing.

(SW)

WEST VIRGINIA DEPARTMENT OF MINES
OIL AND GAS DIVISION

486

WELL RECORD

AB
Permit No. 459-A

Oil or Gas Well **Gas**
(Kind)


Company **Earl Goodwin**
Address **Jane Lew, W. Va.**
Farm **Fairview Methodist Church** Acres **1.87**
Location (waters) **Spruce Creek**
Well No. **1** Elev. **775.0**
District **Murphy** County **Ritchie**
The surface of tract is owned in fee by **Trustees of Fairview Church** Address **Goff, W. Va.**
Mineral rights are owned by **Same as above**
Address _____
Drilling commenced _____
Drilling completed **1913**
Date shot _____ Depth of shot _____
Open Flow /10ths Water in _____ Inch
/10ths Merc. in _____ Inch
Volume _____ Cu. Ft.
Rock Pressure _____ lbs. _____ hrs.
Oil _____ bbls., 1st 24 hrs.
Fresh water _____ feet _____ feet
Salt water _____ feet _____ feet

Casing and Tubing	Used in Drilling	Left in Well	Packers
Size			
16.			Kind of Packer
13.			
10.			Size of
8 1/4			
6 5/8		1675	Depth set
5 3/16			
3.			Perf. top
2.		1790	Perf. bottom
Liners Used			Perf. top
			Perf. bottom

CASING CEMENTED _____ SIZE _____ No. FT. _____ Date _____
COAL WAS ENCOUNTERED AT _____ FEET _____ INCHES
_____ FEET _____ INCHES _____ FEET _____ INCHES
_____ FEET _____ INCHES _____ FEET _____ INCHES

Formation	Color	Hard or Soft	Top	Bottom	Oil Gas or Water	Depth Found	Remarks
Big Lime			1658	1718			
Big Injun			1718	1783			
Gas			1725	1735	Gas		
Total Depth				1790			

Note: The above information is all that is available for this well.

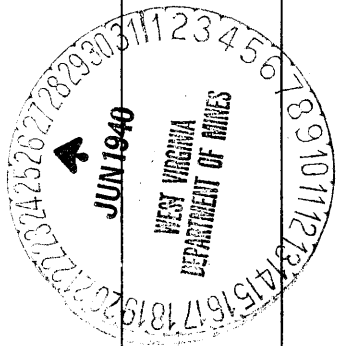

Formation	Color	Hard or Soft	Top	Bottom	Oil, Gas or Water	Depth Found	Remarks

Date **June 25 . . .** 19**40**

APPROVED *Carl Goodwin*, Owner

By _____
(Title)