

#1	0.2 W 4.15
#2	0.3 W 4.07

Company Smith, Piers, Faick & Co.  
 Address R.D. No. 2, Walker, W.Va.  
 Farm A.F. Scott  
 Acre. 150 Lease No. \_\_\_\_\_  
 Well (Farm) No. 63722 Serial No. \_\_\_\_\_  
 Elevation (Spirit Level) No. 1-716 - No. 2-954  
 Range St. Marys  
 County Ritchie District Grant  
 Engineer J.E. Anderson Surveyor  
 Engineer's Registration No. of Wood County  
 No. \_\_\_\_\_ Drawing No. \_\_\_\_\_

STATE OF WEST VIRGINIA  
 DEPARTMENT OF MINES  
 OIL AND GAS DIVISION  
 CHARLESTON

WELL LOCATION MAP  
 FILE NO. RIT-529A-530A

+ Denotes location of well on United States Topographic Maps, scale 1 to 62,500, latitude and longitude lines being represented by border lines as shown.  
 - Denotes one inch spaces on border lines of original map.

STATE OF WEST VIRGINIA  
DEPARTMENT OF MINES  
OIL AND GAS DIVISION

*J32*

WELL RECORD

*Ab*  
Permit No. **none**  
*530A*


Oil or Gas Well.....  
(KIND)

Company **Smith, Pierson, Feick & Coss (C. R. Pierson)**  
 Address **R. D. #2, Walker, W. VA.**  
 Farm **A. F. Scott** Acres **125**  
 Location (waters) **Goose Creek & Wolf Run**  
 Well No. **2** Elev. **920**  
 District **Grant** County **Ritchie**  
 The surface of tract is owned in fee by **A. F. Scott**  
 Address **R. D. #2, Cairo**  
 Mineral rights are owned by **Same**  
 Address.....  
 Drilling commenced **1903**  
 Drilling completed.....  
 Date shot..... Depth of shot.....  
 Open Flow /10ths Water in..... Inch  
 /10ths Merc. in..... Inch  
 Volume..... Cu. Ft.  
 Rock Pressure..... lbs..... hrs.  
 Oil..... bbls., 1st 24 hrs.  
 Fresh water..... feet..... feet  
 Salt water..... feet..... feet

Casing and Tubing	Used in Drilling	Left in Well	Packers
Size			Kind of Packer.....
16.....			
13.....			Size of.....
10.....			Depth set.....
8 1/4.....	<b>1350</b>	<b>1350</b>	
6 5/8.....			Perf. top.....
5 3/16.....			Perf. bottom.....
3.....			Perf. top.....
2.....			Perf. bottom.....
Liners Used.....			

CASING CEMENTED..... SIZE..... No. Ft..... Date.....  
 COAL WAS ENCOUNTERED AT..... FEET..... INCHES  
 FEET..... INCHES..... FEET..... INCHES  
 FEET..... INCHES..... FEET..... INCHES

Formation	Color	Hard or Soft	Top	Bottom	Oil, Gas or Water	Depth Found	Remarks
<b>Clay &amp; Red Rock</b>			<b>0000</b>	<b>725'</b>			
<b>Clay</b>			<b>775</b>	<b>875</b>			
<b>Shale</b>			<b>875</b>	<b>1150</b>			
<b>Sand</b>			<b>1150</b>	<b>1200</b>			
<b>Shale</b>			<b>1200</b>	<b>1375</b>			
<b>Sand</b>			<b>1375</b>	<b>1400</b>			
<b>Shale</b>			<b>1400</b>	<b>1560</b>			
<b>Sand</b>			<b>1560</b>	<b>1600</b>	<b>Bottom of well'</b>		

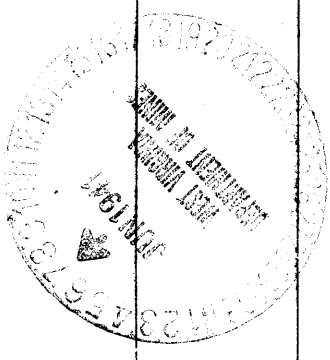

Formation	Color	Hard or Soft	Top	Bottom	Oil, Gas or Water	Depth Found	Remarks

Date 5 10 1946  
APPROVED Smith Pierisol Feick & Cobb, Owner  
By C. R. Pierisol  
(Title)