

New Location
 Drill Deeper
 Abandonment

H. N. Rinehart

JUN 22 1943


1.62 W
 4.05

Company H. N. Rinehart
 Address Cairo, W. Va.
 Farm T. B. Jenkins
 Tract _____ Acres 90 Lease No. _____
 Well (Farm) No. 1 Serial No. _____
 Elevation (Spirit Level) 955
 Quadrangle Harrisville
 County Ritchie District Grant
 Engineer A. T. Westfall
 Engineer's Registration No. County Surveyor
 File No. _____ Drawing No. _____
 Date June 5, 1943 Scale 1" = 300 feet

STATE OF WEST VIRGINIA
 DEPARTMENT OF MINES
 OIL AND GAS DIVISION
 CHARLESTON

WELL LOCATION MAP
 FILE NO. Rit-670-A

+ Denotes location of well on United States Topographic Maps, scale 1 to 62,500, latitude and longitude lines being represented by border lines as shown.
 - Denotes one inch spaces on border line of original tracing.

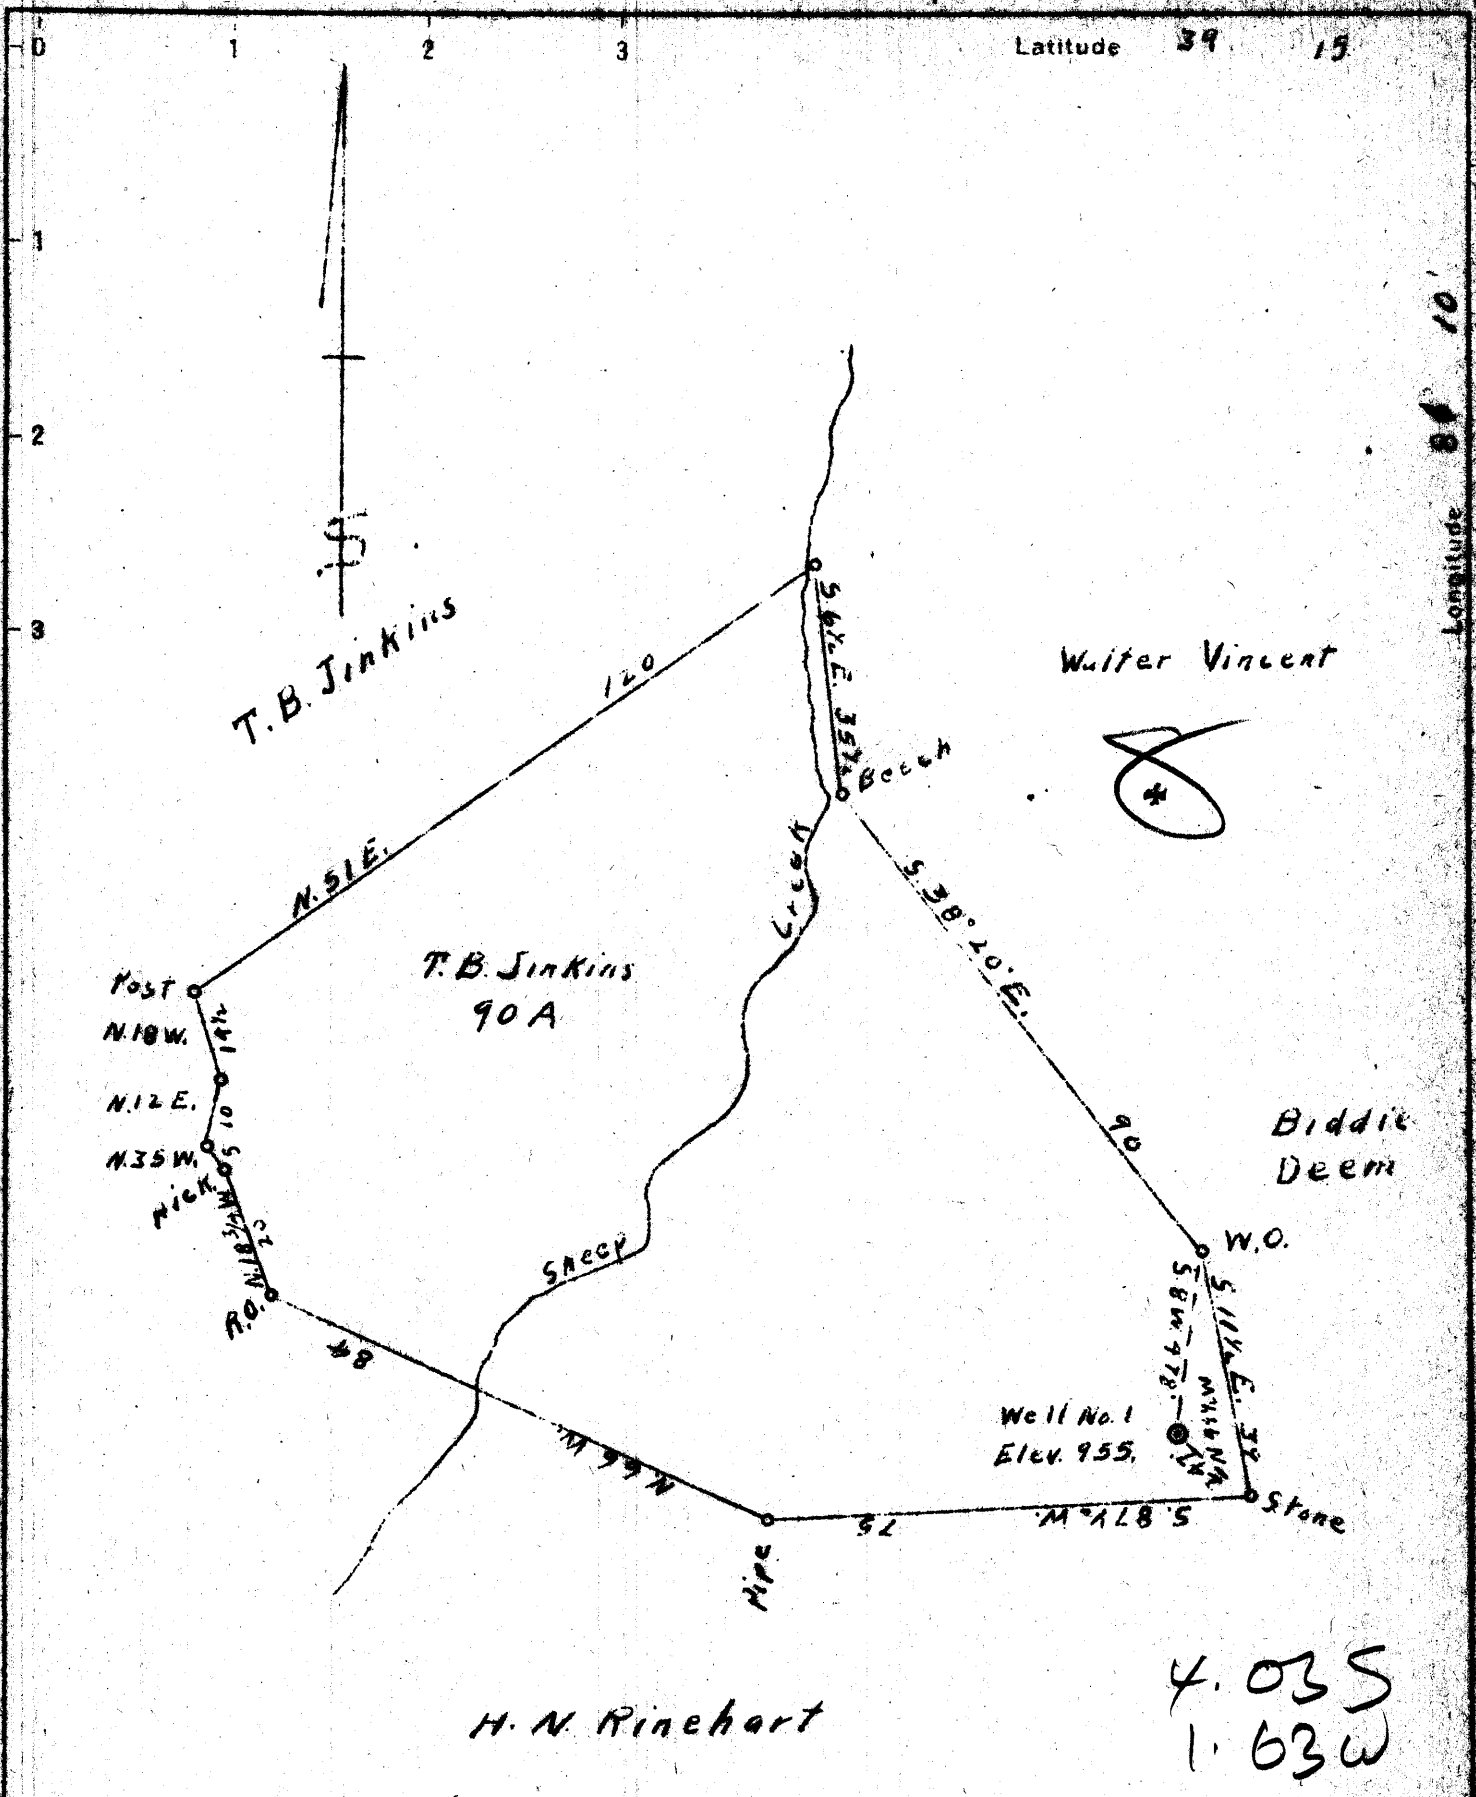

New Location
 Drill Deeper
 Abandonment

Company H. N. Rinehart
 Address Cairo, W. Va.
 Farm T. B. Jenkins
 Tract _____ Acres 90 Lease No. _____
 Well (Farm) No. 1 Serial No. _____
 Elevation (Spirit Level) 955
 Quadrangle Harrisville
 County Mitchell District Grant
 Engineer A. K. Wentz
 Engineer's Registration No. County Surveyor
 File No. _____ Drawing No. _____
 Date Jan. 5, 1902 Scale 1" = 400'

STATE OF WEST VIRGINIA
 DEPARTMENT OF MINES
 OIL AND GAS DIVISION
 CHARLESTON

WELL LOCATION MAP
 FILE NO. Rit-670-A

+ Denotes location of well on United States Topographic Maps, scale 1 to 62,500, latitude and longitude lines being represented by border lines as shown.
 - Denotes one inch spaces on border line of original tracing.

4.035
 1.63W