


2375  
0.87W

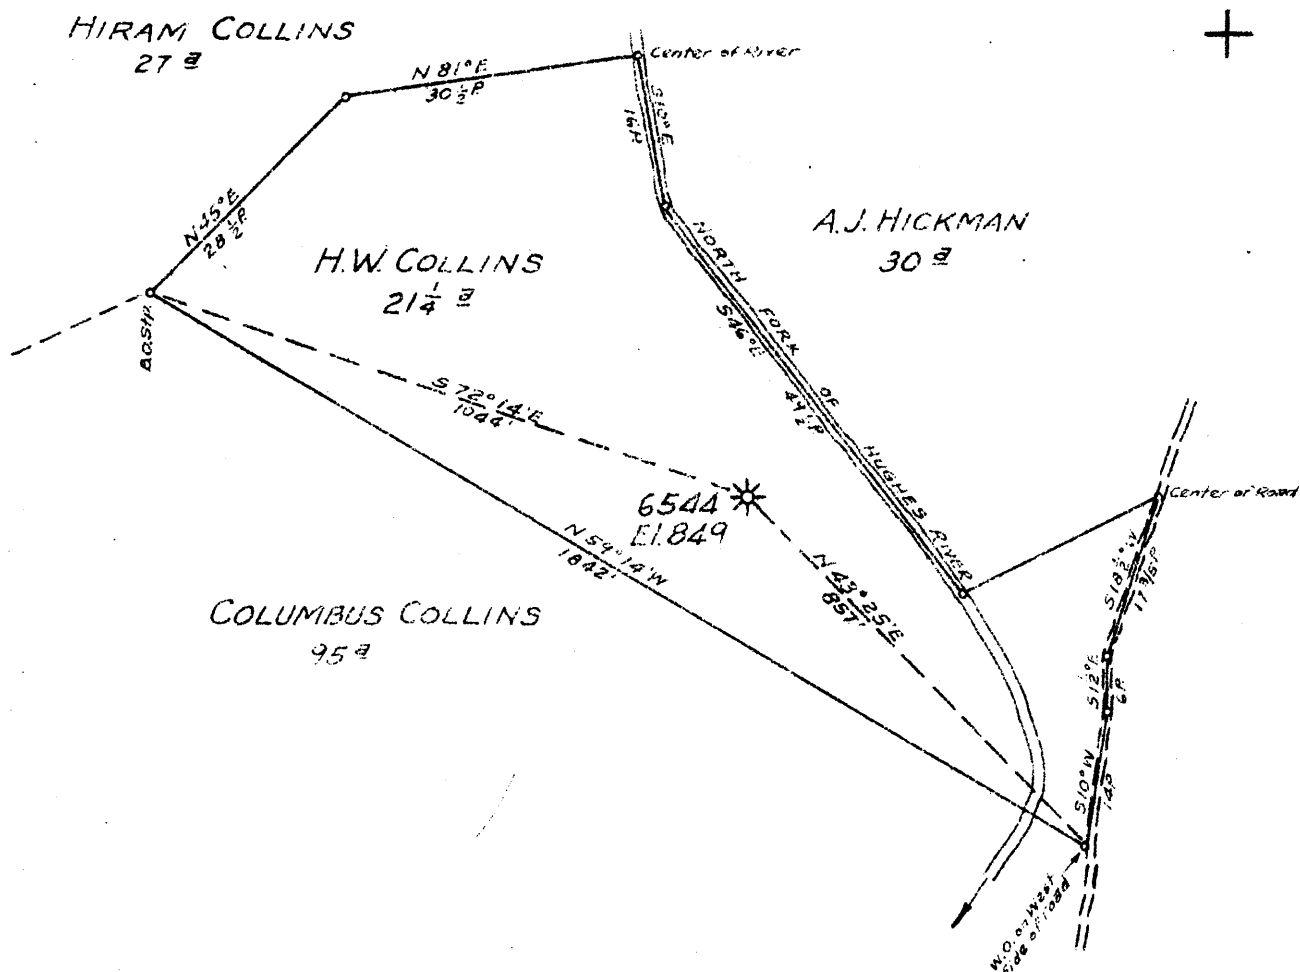

New Location   
 Drill Deeper   
 Abandonment

Map Sheet 67 S10W18 E.B.756 P.29-30

Company HOPE NATURAL GAS CO.  
 Address CLARKSBURG, W.VA.  
 Farm H. W. COLLINS  
 Tract \_\_\_\_\_ Acres 21 1/4 Lease No. 32995  
 Well (Farm) No. 1 Serial No. 6544  
 Elevation (Spirit Level) 849  
 Quadrangle WEST UNION  
 County RITCHIE District CLAY  
 Engineer Wm Bowers  
 Engineer's Registration No. 900  
 File No. \_\_\_\_\_ Drawing No. \_\_\_\_\_  
 Date DEC. 13, 1943 Scale 1" = 20P

STATE OF WEST VIRGINIA  
 DEPARTMENT OF MINES  
 OIL AND GAS DIVISION  
 CHARLESTON

WELL LOCATION MAP  
 FILE NO. Rit-689-A

+ Denotes location of well on United States Topographic Maps, scale 1" to 62,500. latitude and longitude lines being represented by border lines as shown.

- Denotes one inch spaces on border line of original tracing