

New Location
 Drill Deeper
 Abandonment


OCT 10 1944

Company A. C. Mercer
 Address Ellenboro, W Va.
 Farm Roy Delancy
 Tract _____ Acres 1.1 Lease No. _____
 Well (Farm) No. 1 Serial No. _____
 Elevation (Spirit Level) 798
 Quadrangle St Marys
 County Ritchie District Grant
 Engineer A. K. Westfall
 Engineer's Registration No. County Surveyor
 File No. _____ Drawing No. _____
 Date Sept. 22, 1944 Scale 1" = 50'

STATE OF WEST VIRGINIA
 DEPARTMENT OF MINES
 OIL AND GAS DIVISION
 CHARLESTON

WELL LOCATION MAP
 FILE NO. RIT-705-A

+ Denotes location of well on United States Topographic Maps, scale 1 to 62,500, latitude and longitude lines being represented by border lines as shown.
 - Denotes one inch spaces on border line of original tracing.

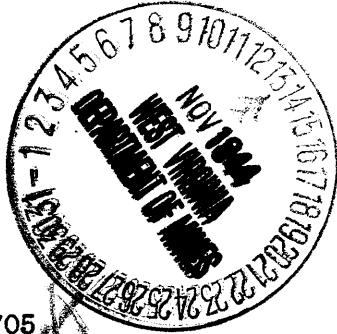

COPY

618

STATE OF WEST VIRGINIA
DEPARTMENT OF MINES
OIL AND GAS DIVISION

WELL RECORD

Permit No. RIT-705

Oil or Gas Well Gas
(KIND)

Company A. C. Mercer
Address Ellenboro, West Virginia
Farm Roy Delancy Acres 1.1
Location (waters) Bonds Creek
Well No. 1 Elev. 798
District Grant County Ritchie
The surface of tract is owned in fee by Roy Delancy
Address Pike, W. Va.
Mineral rights are owned by _____
Address _____

Casing and Tubing	Used in Drilling	Left in Well	Packers
Size			
16			Kind of Packer
13			
10	225	None	Size of
8 1/4	965	"	
6 5/8	1540		Depth set <u>1820</u>
5 3/16			
3			Perf. top
2	1923	1923	Perf. bottom
Liners Used			Perf. top
			Perf. bottom

Drilling commenced _____
Drilling completed _____
Date Shot Not shot From _____ To _____
With _____
Open Flow _____ /10ths Water in _____ Inch
_____ /10ths Merc. in _____ Inch
Volume 75,000 Cu. Ft.
Rock Pressure _____ lbs. _____ hrs.
Oil _____ bbls., 1st 24 hrs.
Fresh water _____ feet _____ feet
Salt water _____ feet _____ feet

CASING CEMENTED _____ SIZE _____ No. Ft. _____ Date _____
COAL WAS ENCOUNTERED AT _____ FEET _____ INCHES
_____ FEET _____ INCHES FEET _____ INCHES
_____ FEET _____ INCHES FEET _____ INCHES

Formation	Color	Hard or Soft	Top	Bottom	Oil, Gas or Water	Depth Found	Remarks
Maxon			1725	1745			
Big Lime			1745	1782			
Keener			1782	1810			
Injun			1810	1905	Gas	1810-1815 1860-1865	
Squaw			1908	1955	Gas	1911-1914	
		Cement	1540	1580			
		Cement	1760	1820			

Formation	Color	Hard or Soft	Top	Bottom	Oil, Gas or Water	Depth Found	Remarks

Date September 25, 194 4

APPROVED _____, Owner

By A. C. Mercer
(Title)

