81020

0-> 7.5 10c Kla 4/24/95

Topo Location

7.5' Loc. 1.65S 15' Loc. 4.53S

Company Richards + Howtman

Farm Sarah Lsimmons!


15' Quad Marrison le EC (sec.)

7.5' Quad Smithville

District Murphy

WELL LOCATION PLAT

County 085 Permit 3085

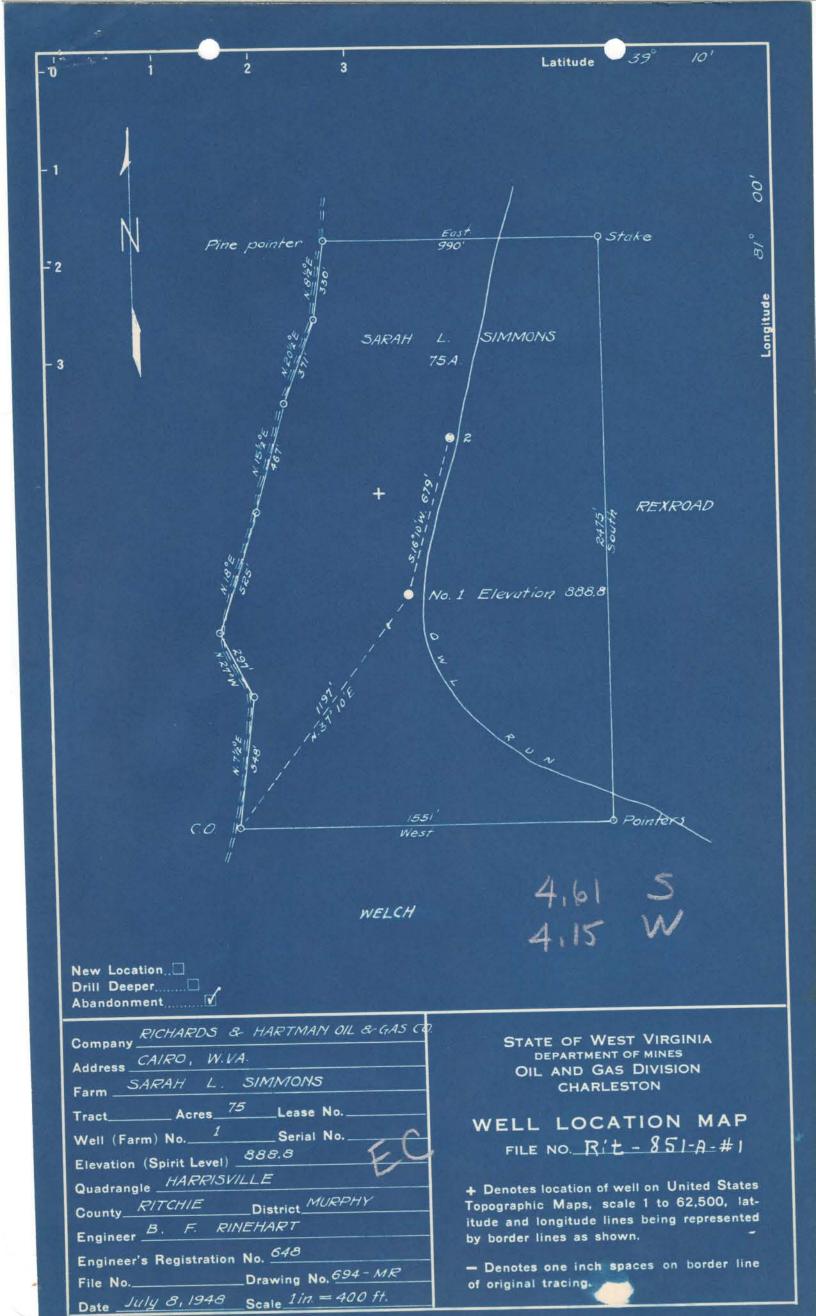

MPERIAL" TRACING CLOTH

85 A

Nurphy District, Ritchie County, W. Ve.

By Richards and Mertman Oil & Oos Co., Box 252, Cairo, W. Va.

Abandoned under permit Rit-....A?

On 75 acres, on Oul Run.

Elevation, L.

Surface and minerals owned by Sarah L. Simmons, Mahone, W. Va.

Brilling commenced in 1910.

10" casing, 180' (pulled); 8½", 1020' (pulled); 6½", 1460'.

Oil well. Abandonment reported to Dept. of Mines July 17, 1948.

Record to NCF from Mrs. Oriffith Sept. 3, 1948. Old File No. 969.

Top. Bottom.

HO WELL BUCCED AVAILABLE.

Maxton Sand, approximately

1750 (oil)



STATE OF WEST VIRGINIA

DEPARTMENT OF MINES

OIL AND GAS DIVISION

135		_	
1	20	1/5	1
1	16	1	E)E
1	/	1	1
	_		

Permit No	851-A		WELL	RECORD		Oil or	Gas Well (KIND)
		artman Oil ro, W. Va.	& Gas Co.	Casing and Tubing	Used in Drilling	Left in Well	Packers
Farm Sar	ah L Simm	nôns A	cres_75	Size			
Location (water	s) Owl Ru	n		16			Kind of Packer
		El Pita		13			
		County Ritc	and A comment of the	10	180	AL ALL SE	Size of
The surface of t		fee by Sam		81/4	1020		
Mineral rights a		Sarah L Si		6%		1460	Depth set
		Address Mahone		5 3/16		-	
Drilling commer	nced 191	0		3			Perf. top
		1		2			Perf. bottom
		тото		Liners Used			Perf. top
							Perf. bottom
		inin		CASING CEME	NAMED	SIZE	No. Ft. Date
		In.				SIZE	110. F 0.
		lbs					
		1		COAL WAS EN	COUNTERED	AT	FEETINCHES
		feet		FEET	INC	HES	FEETINCHES
Salt water	9	feet	feet	FEET.	INC	HES	FEETINCHES
Formation	Color	Hard or Soft	Тор	Bottom	Oil, Gas or Water	Depth Found	Remarks
					THE STATE OF THE PARTY OF THE P	12223242533 1448 1448 1448 1448 1448 1448 1448 14	A7282930317

	Color	Hard or Soft	Тор	Bottom	Oil, Gas or Water	Depth Found	Remarks
						1	
						79	
						1300	
	7					1 1 1 1 1 1 1 1 1 1 1 1 1 1 1 1 1 1 1 1	
				1			
\$ 1 B				Vac			
			Santa F	1			8
Carton Pr	ndApp	rowinstoly		1750	013	NO.	
Anton Ci	andrd av	nilabla rominately		1400	043		
	color anord av	Ecti Ecti Minelo replantely	200	JA80	C42	A-FEST Dates	Benefit
paragraphic states of the stat					ST AND	Period Daylo	Nemarka Inch
to water		facility of Bods on Bods	INTERNATION		GUITONI GUITONI L. LINCOL	Lieun Dalay Lie Lui	Econtin 1MGH
Languages of Association			Part Part		ST AND	Lieun Dalay Lie Lui	Econtin 1MGH
Lamaged Arguni 17 Mars 18 Common	Color	facility of Bods on Bods	Total Secret Inc.		LE ANTON CAPITATI LECATI LECATION CONTRACTOR	Lieun Dalay Lie Lui	peon, s IMCH IMCH IMCH
Taranta Services	Victis Water Violes Mars.	facility of Bods on Bods	Total See St. Mar.	CVERNO CENT	LE ANTON CAPITATI LECATI LECATION CONTRACTOR	Person Days of Paris	Decition in the party of the pa
the first overhead the first over th	Pour Pictic Water Finish Mars.	facility of Bods on Bods	Total Secret Inc.	OOVE MYS E	LE ANTON CAPITATI LECATI LECATION CONTRACTOR	Dates No.	parent pa in inchi in inchi
the first overhead the first over th	Total Water Total Mater Color	Market and Short S		CAMPIG CIDI	LE ANTON CAPITATI LECATI LECATION CONTRACTOR	Being Dalay	peorips perpent perpe
the state of the s	Color	Labor Habir		CVERNO CENT	COPPLEMENTS DECIDENT DEC	Line House Property of the Pro	to bolton to the trans-
The state of the s	Color	Address Mahura Address Mahura Address Mahura Mara Mara Mara Mara Mara Mara Mara M		CYRONO CTO	LE ANTON CAPITATI LECATI LECATION CONTRACTOR	Linear Dalay	betten 1 hetten 1 hetten
The state of the s	Color	County All to Address Andress Mally of Lebeste Mally of Andress Mally of Mark of Both		CVERNO CENT	COPPLEMENTS DECIDENT DEC	Livery Delay (1997) Livery De	betten 1 leg 2 legen 2 legen 1 lege
in No. In No.	Color	Commy All to Address Andress Labore Malbur Andress Malbur Mark		CVMDAG CIDA CVMDAG CVMDAG CIDA CVMDAG CVMDAG CIDA CVMDAG CIDA CVMDAG CVMDAG CIDA CVMDAG CVMDAG CIDA CVMDAG CVMDAG CVMD	COPPLEMENTS DECIDENT DEC		in ac in bottom in bottom in bottom in liveli
in the second of	Color Co	Comy Alternative Mahamatan		CAMING CLOS	TARIO DAMES		in and Parkers in the second
STAND IN THE STAND	Color	School (1) School		CYNDAU CENT	TARIO DAME	Tenne Property of the Property	Fachers Fac
and the same of th	Color Co	School (1) School		CAMING CLOS	DAMES DE LE CONTROL DE LE CONT		Packers Pac

APPROVED Charles San tom Oo Glo,

By Scharles
(Title)

SATHEWS PRINTING AND LITHOGRAPHING CO.