


Latitude 39° 10'

Longitude 81° 00'

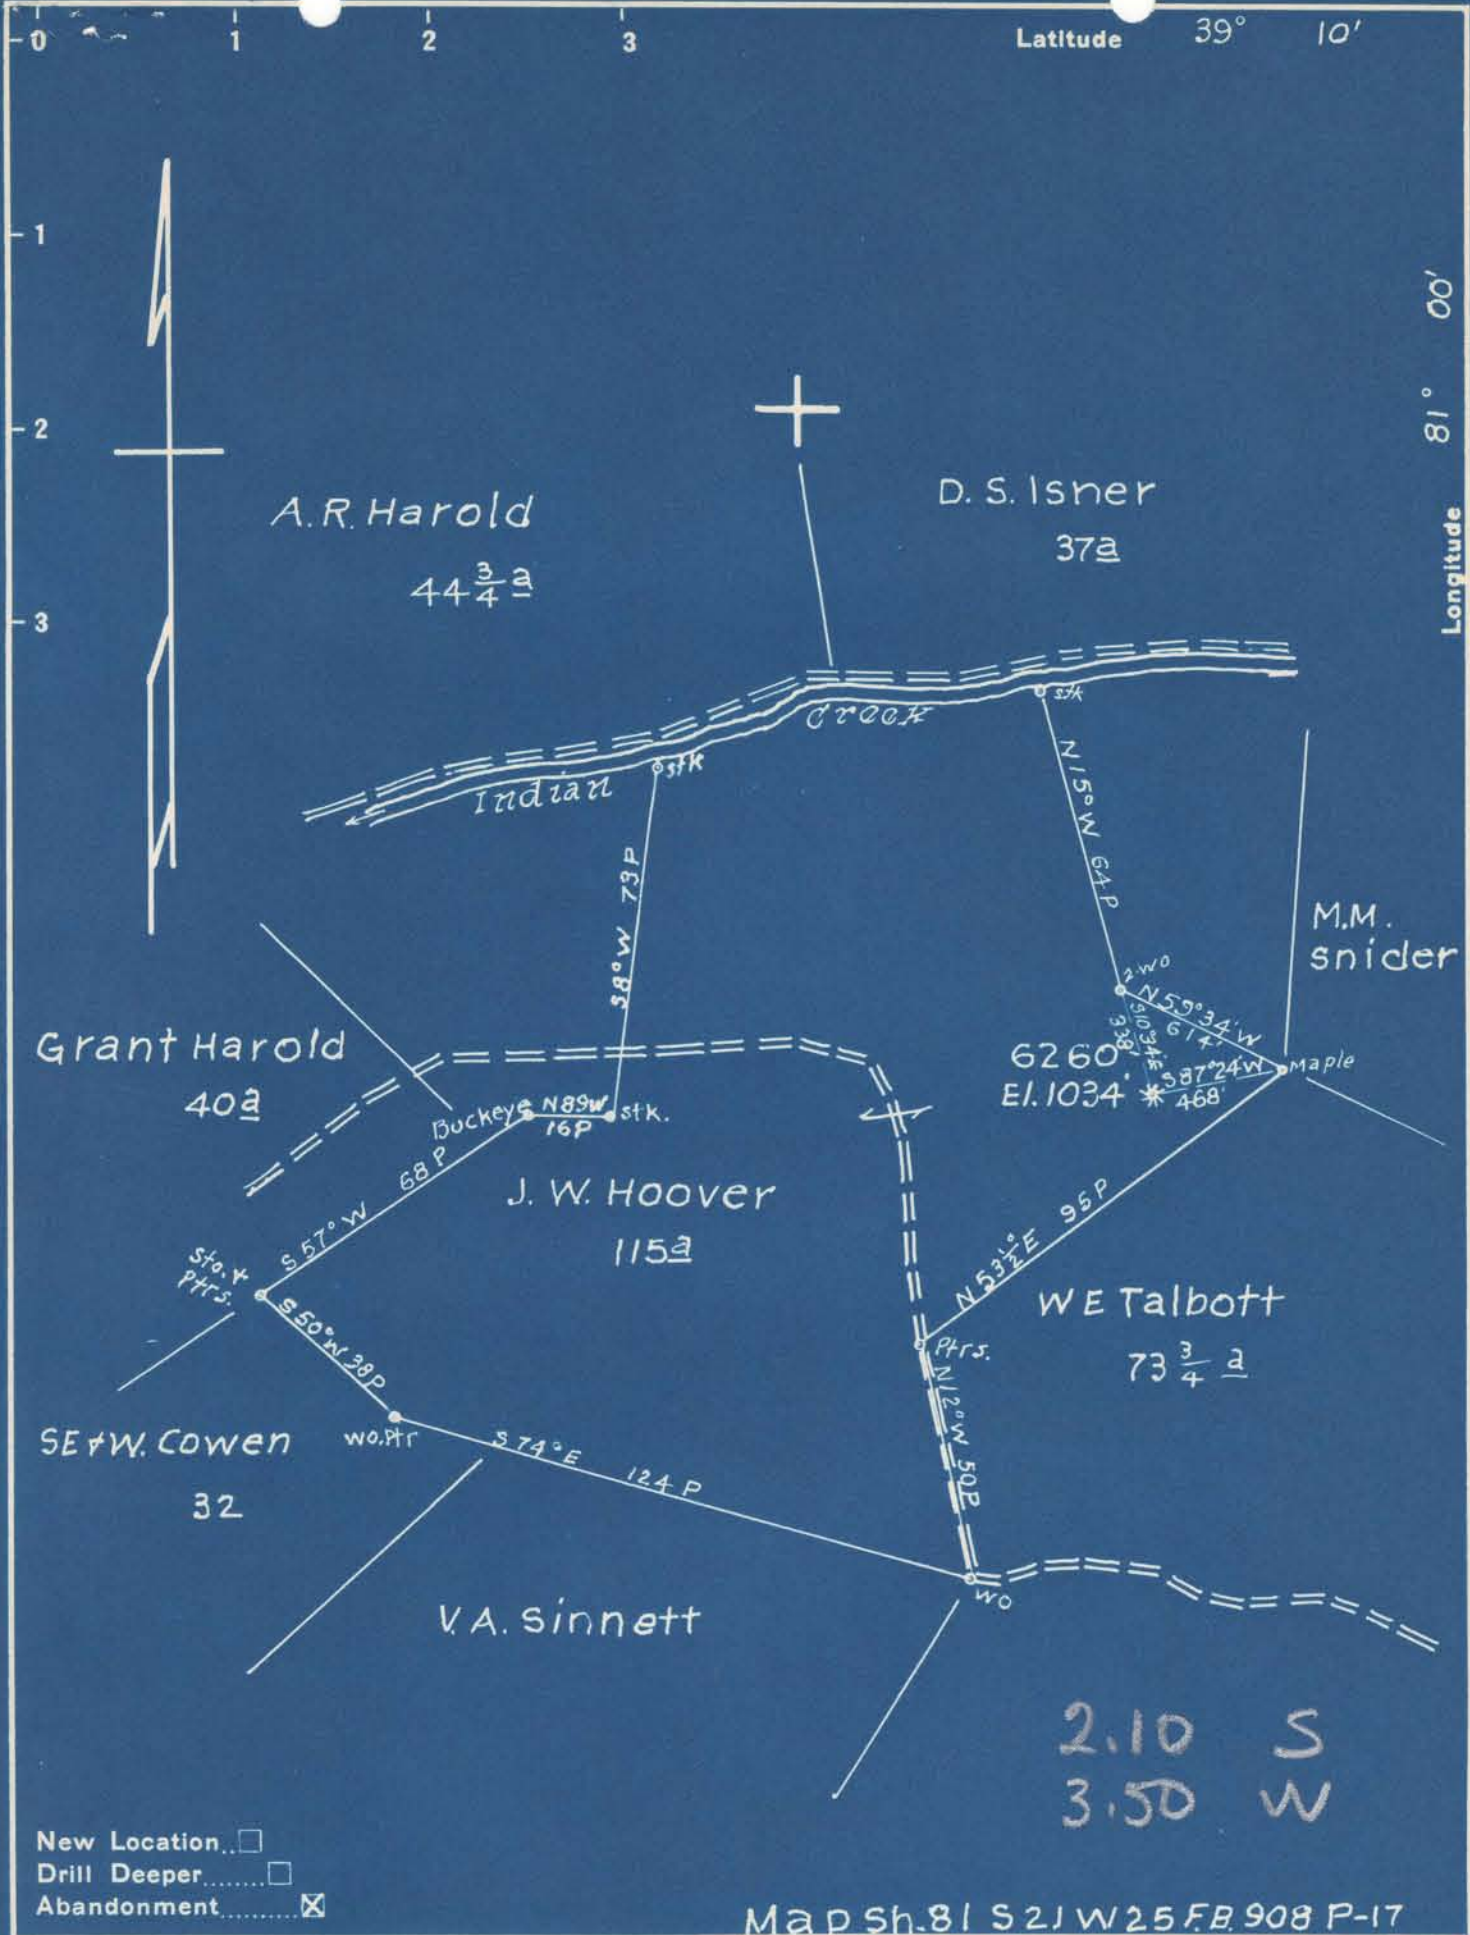

2.10 S
3.50 W

- New Location
- Drill Deeper
- Abandonment

Map Sh. 81 S 21 W 25 F.B. 908 P-17

Company Hope Natural Gas Co
 Address Clarksburg, W.Va.
 Farm J.W. Hoover
 Tract _____ Acres 115 Lease No. 11479
 Well (Farm) No. _____ Serial No. 6260
 Elevation (Spirit Level) 1034'
 Quadrangle Harrisville
 County Ritchie District Murphy
 Engineer W.M. Bowers
 Engineer's Registration No. 900
 File No. _____ Drawing No. _____
 Date 8-17-48 Scale 1" = 40 P

STATE OF WEST VIRGINIA
 DEPARTMENT OF MINES
 OIL AND GAS DIVISION
 CHARLESTON

WELL LOCATION MAP
 FILE NO. Rit-856-A

+ Denotes location of well on United States Topographic Maps, scale 1 to 62,500, latitude and longitude lines being represented by border lines as shown.

- Denotes one inch spaces on border line of original tracing.

"IMPERIAL" TRACING CLOTH
K & E CO., N. Y.



STATE OF WEST VIRGINIA
DEPARTMENT OF MINES
OIL AND GAS DIVISION

787

Permit No. 856-A

WELL RECORD

Oil or Gas Well (KIND)

Company Hope Natural Gas Company.
 Address 445 West Main St. Clarksburg, W. Va.
 Farm J.W. Hoover Acres 115
 Location (waters) _____
 Well No. 6260 Elev. 1034
 District Murphy County Ritchie
 The surface of tract is owned in fee by _____
 Address _____
 Mineral rights are owned by _____
 Address _____
 Drilling commenced June 16, 1911
 Drilling completed July 7, 1911
 Date Shot _____ From _____ To _____
 With _____
 Open Flow _____ /10ths Water in _____ Inch
 _____ /10ths Merc. in _____ Inch
 Volume _____ Cu. Ft.
 Rock Pressure _____ lbs. _____ hrs.
 Oil _____ bbls., 1st 24 hrs.
 Fresh water none recorded feet _____ feet
 Salt water none recorded feet _____ feet

Casing and Tubing	Used in Drilling	Left in Well	Packers
Size			Kind of Packer
16			
13			
10	169	Pulled	Size of
8 1/4	1093	Pulled	
6 5/8	1523	1523	Depth set
5 3/16	1953	1953	
3			Perf. top
2			Perf. bottom
Liners Used			Perf. top
			Perf. bottom

CASING CEMENTED not SIZE _____ No. Ft. _____ Date _____
 COAL WAS ENCOUNTERED AT _____ FEET _____ INCHES
 _____ FEET _____ INCHES FEET _____ INCHES
 _____ FEET _____ INCHES FEET _____ INCHES

Formation	Color	Hard or Soft	Top	Bottom	Oil, Gas or Water	Depth Found	Remarks
Red rock			900	1130			
Gas sand			1760	1785			
Salt sand			1835	1891	show gas	1881 oil 1881	88
Maxon			1894	1917			
Big Line			1917	2003			
Big Injun			2003	2029	gas	2005	
Squaw			2030	2034			
Total depth				2138			



Formation	Color	Hard or Soft	Top	Bottom	Oil, Gas or Water	Depth Found	Remarks



MET RECORD

DEPARTMENT OF MINES
BUREAU OF METALS DIVISION

Date August 12, 1948., 19

APPROVED Hope Natural Gas Company., Owner



By E. H. Tolleson
(Title)