


Latitude 39° 05'

Longitude 81° 05'

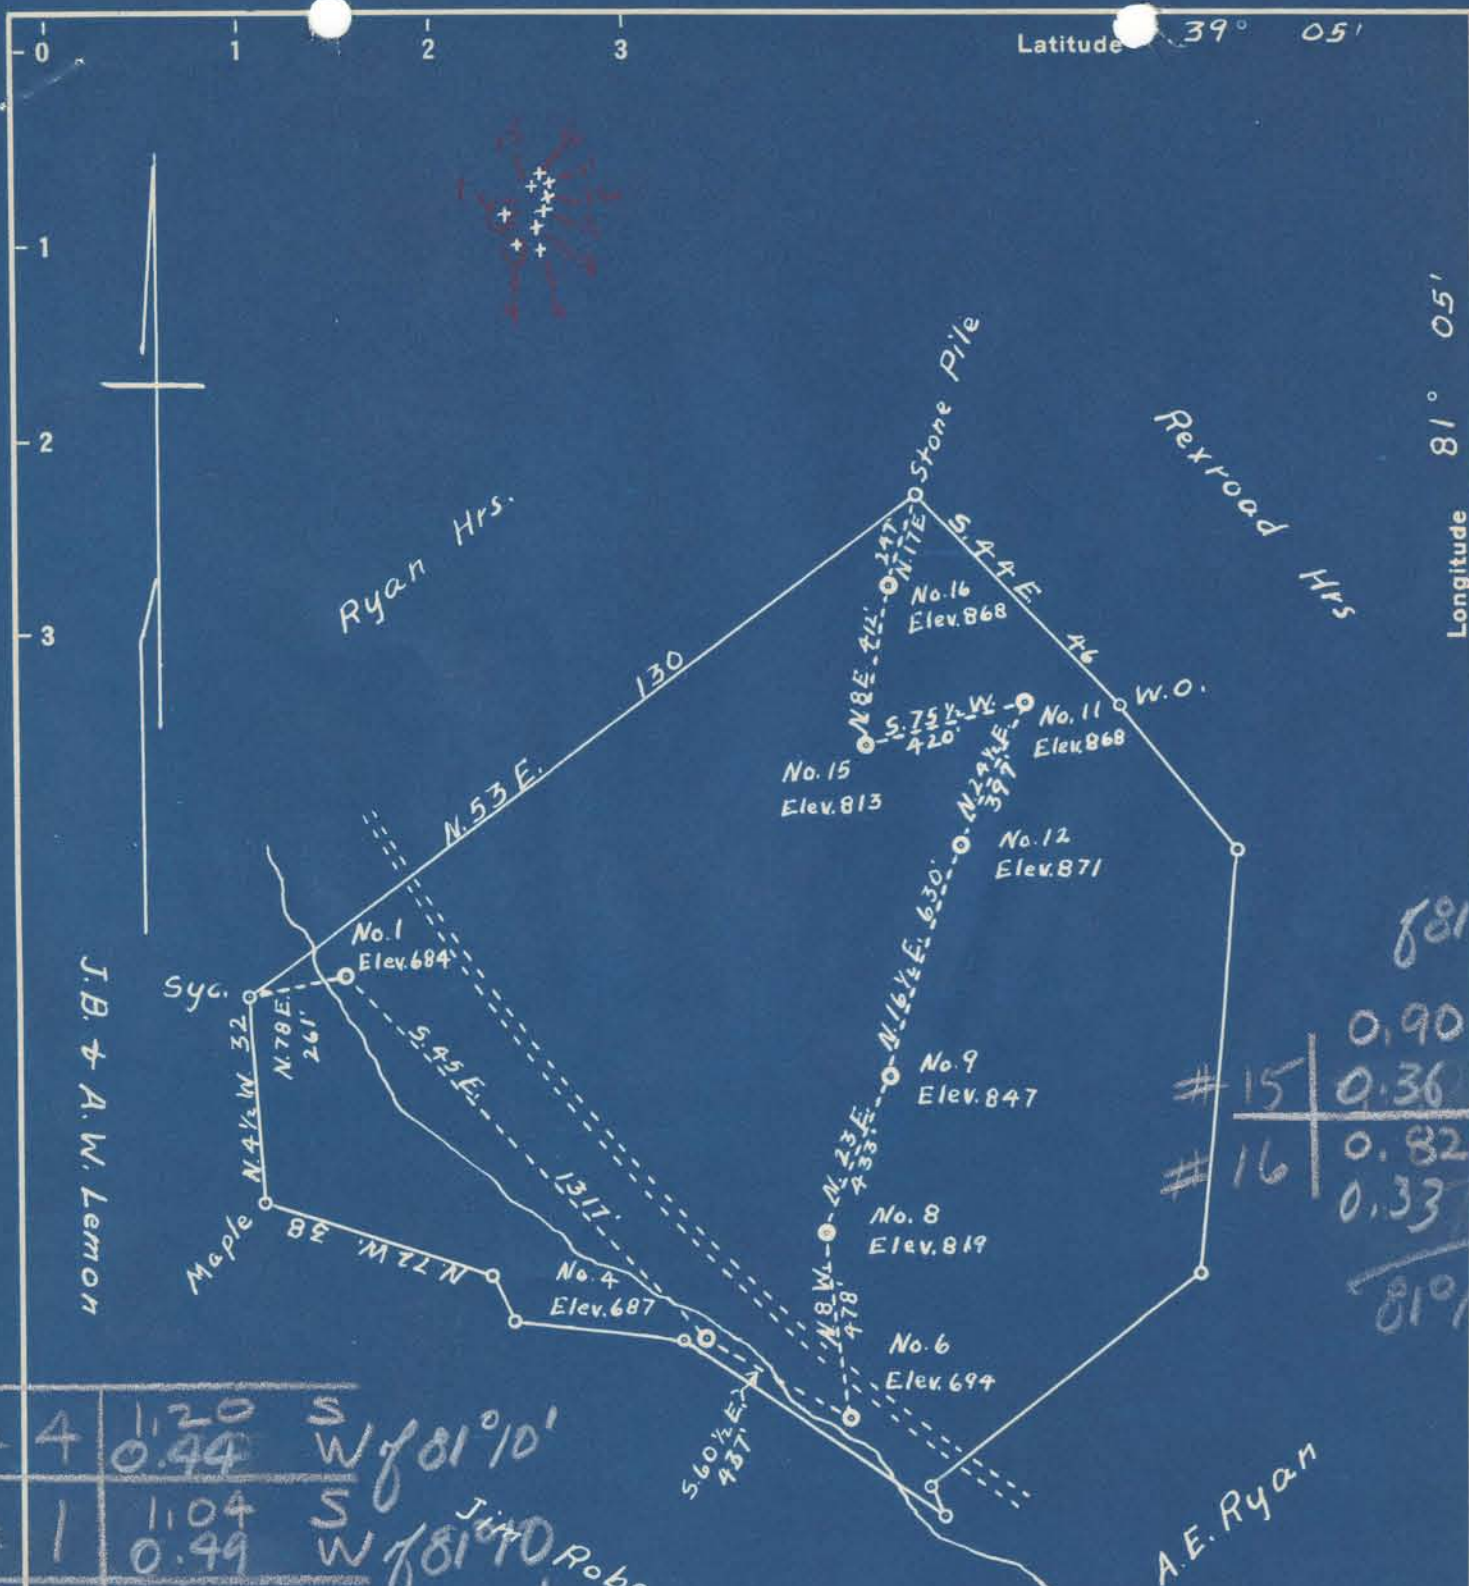

# 15	0.90	S
# 16	0.36	W
	0.82	S
	0.33	W
		81° 10'

# 4	1.20	S	W of 81° 10'
# 1	1.04	S	W of 81° 10'
# 6	1.22	S	W of 81° 10'
# 9	1.02	S	W of 81° 10'
# 8	1.11	S	W of 81° 10'
# 11	0.89	S	W of 81° 10'
# 12	0.96	S	W of 81° 10'
# 12	0.27	W	81° 10'

FILE NOS. Rit-902-A-#4, Rit-903-A-#1, Rit-904-A-#6, Rit-905-A-#9, Rit-906-A-#8, Rit-907-A-#11, Rit-908-A-#12, Rit-909-A-#15, Rit-910-A-#16

New Location 81° 10'
 Drill Deeper
 Abandonment

Survey & Plat A.K. Wutfall

Company Dr. E. S. Woodyard Est. & Paul Cromley
 Address Pennsboro, W. Va.
 Farm Alex Delaney
 Tract _____ Acres 97 Lease No. 1-4-6-8-9
 Well (Farm) No. 11-12-15-16 Serial No. 684-687-694-819-897
 Elevation (Spirit Level) 868-871-813-868
 Quadrangle Harrisville
 County Ritchie District Murphy
 Engineer B. Finckel
 Engineer's Registration No. 648
 File No. _____ Drawing No. _____
 Date Nov. 30, 1948 Scale 1" = 30 Poles

STATE OF WEST VIRGINIA
 DEPARTMENT OF MINES
 OIL AND GAS DIVISION
 CHARLESTON

WELL LOCATION MAP
 FILE NO. 902-10-A

+ Denotes location of well on United States Topographic Maps, scale 1 to 62,500, latitude and longitude lines being represented by border lines as shown.
 - Denotes one inch spaces on border line of original tracing.

ALEX. DULANEY NO. 8 WELL.

Murphy District, Ritchie County, W. Va.
By Paul Cromwell, Mrs. Lelia B. Woodyard, Admx., and Anthony Mondok,
Box 578, Pennsboro, W. Va.
Abandoned under permit Rit-906.-A?
On 97 acres.
Elevation, 819' L.
Surface and minerals owned by Alex. Dulaney Heirs, Macfarlan, W. Va.
Drilling completed Jan. 28, 1920.
Date shot, unknown.
10" casing, 126' (pulled); 8 $\frac{1}{4}$ " , 932' (pulled); 6 $\frac{1}{4}$ " , 1434 $\frac{1}{2}$ '.
No coal was encountered.
Oil well. Record to Dept. of Mines dated Dec. 13, 1948.
Record to RCT from Mrs. Griffith Nov. 18, 1950. Old File No. 852.

	Top.	Bottom.
Salt Sand (first oil, 1608'; bottom of oil pay, 1682')	1620 -
Total depth		1682 $\frac{1}{2}$

Murphy District, Ritchie County, W. Va.

By Paul Grosswell, Mrs. Lelia B. Woodyard, Admx., and Anthony Mondak,
Box 578, Pennsboro, W. Va.

Abandoned under permit Bit-.....-A7

On 97 acres.

Elevation, 819' L.

Surface and minerals owned by Alex. Dulaney Heirs, Macfarlan, W. Va.

Drilling completed Jan. 28, 1920.

Date shot, unknown.

10" casing, 126' (pulled); 8 $\frac{1}{2}$ " 932' (pulled); 6 $\frac{1}{2}$ " 1434 $\frac{1}{2}$ '.

No coal was encountered.

Oil well. Record to Dept. of Mines dated Dec. 13, 1948.

Record to RCF from Mrs. Griffith Nov. 18, 1950. Old File No. 852.

	Top.	Bottom.
Salt Sand (first oil, 1668'; bottom of oil pay, 1682')	1620 -	1682 $\frac{1}{2}$
Total depth		