

- New Location..
- Drill Deeper.....
- Abandonment.....

APR. 13 1956

Company	L. H. DRAKE
Address	NEWTON, W. VA.
Farm	ANNA M. WILSON
Tract	Acres 400 Lease No.
Well (Farm) No.	18 Serial No.
Elevation (Spirit Level)	105.8
Quadrangle	HARRISVILLE
County	RITCHIE District MURPHY
Engineer	PAULE. JOACHIM
Engineer's Registration No.	669
File No.	84-111 Drawing No.
Date	MARCH 21, 1956 Scale 1" = 800'

STATE OF WEST VIRGINIA
DEPARTMENT OF MINES
OIL AND GAS DIVISION
CHARLESTON

WELL LOCATION MAP
FILE NO. RIT-1253-A

+ Denotes location of well on United States Topographic Maps, scale 1 to 62,500, latitude and longitude lines being represented by border lines as shown.

- Denotes one inch spaces on border line of original tracing.

ANNA M. WILSON No. 18 - L. H. DRAKE - RIT-1253-A



1115

STATE OF WEST VIRGINIA
DEPARTMENT OF MINES
OIL AND GAS DIVISION

WELL RECORD

Oil or Gas Well **OIL**
(KIND)

Quadrangle _____
Permit No. _____

Company **L. H. Drake**
Address **Newton, W. Va.**
Farm **Anna M. Wilson** Acres **400**
Location (waters) _____
Well No. **18** Elev. **1029**
District **Murphy** County **Ritchie**
The surface of tract is owned in fee by _____
Address _____
Mineral rights are owned by _____
Address _____


Drilling commenced **4-11-29**
Drilling completed **5-10-29**
Date Shot **5-21-29** From **1863** To **1878**
With **?**
Open Flow /10ths Water in _____ Inch
/10ths Merc. in _____ Inch
Volume _____ Cu. Ft.
Rock Pressure _____ lbs. _____ hrs.
Oil _____ bbls., 1st 24 hrs.
Fresh water _____ feet _____ feet
Salt water _____ feet _____ feet

Casing and Tubing	Used in Drilling	Left in Well	Packers
Size			Kind of Packer
16			
13			
10	909	None	Size of
8 1/4	1130	None	
6 5/8	1670	1670	Depth set
5 3/16			
3			Perf. top
2			Perf. bottom
Liners Used			Perf. top
			Perf. bottom

CASING CEMENTED _____ SIZE _____ No. Ft. _____ Date _____

COAL WAS ENCOUNTERED AT _____ FEET _____ INCHES
_____ FEET _____ INCHES _____ FEET _____ INCHES
_____ FEET _____ INCHES _____ FEET _____ INCHES

Formation	Color	Hard or Soft	Top	Bottom	Oil, Gas or Water	Depth Found	Remarks
Consuetor water				16			
Big red rock			890	146			
Little Dunkard			990	970			
Big Dunkard			1100	1000			
Sand			1260	1128			
Sand			1330	1290			
Long Streak			1425	1400			
Gas Sand			1605	1560			
Salt Sand			1710	1660			
Mason Sand			1845	1760			
Oil			1863	1878	OIL	1863	
Total Depth	1880						

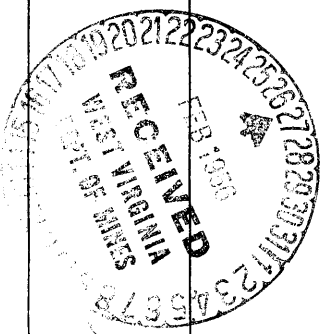

JUNE 21 1956