

Company Piersol Feick Skidmore & Feick
 Address R2 Walker W. Va.
 Farm McKinney & McCullum
 Tract _____ Acres _____ Lease No. _____
 Well (Farm) No. 1, 2, 3 Serial No. _____
 Elevation (Spirit Level) #1-841 #2-777 #3-804
 Quadrangle Harrisville
 County Ritchie District Grant
 Engineer Robert R. Anderson
by O. Meredith
 Engineer's Registration No. 296
 File No. _____ Drawing No. _____
 Date Apr. 6, 56 Scale 1 in = 30 Poles

STATE OF WEST VIRGINIA
 DEPARTMENT OF MINES
 OIL AND GAS DIVISION
 CHARLESTON

WELL LOCATION MAP
 FILE NO. Ric-1257-A-#1
Ric-1258-A-#2
Ric-1259-A-#3

+ Denotes location of well on United States Topographic Maps, scale 1 to 62,500, latitude and longitude lines being represented by border lines as shown.
 - Denotes one inch spaces on border line of original tracing.

McKINNEY & McCULLUM Nos. 1, 2 & 3 - SKIDMORE & FEICK - RIT-125789A



STATE OF WEST VIRGINIA
DEPARTMENT OF MINES
OIL AND GAS DIVISION

1121

Quadrangle _____

Permit No. 107-4

WELL RECORD

Oil or Gas Well _____
(KIND)


Company Fiersol, Feick, Skidmore & Feick
 Address Walker, rt, 2 W. VA
 Farm McKenny & McCullum Acres 157
 Location (waters) N. FK. Hughes, river
 Well No. 1. Elev. 841
 District Grant County Ritchie
 The surface of tract is owned in fee by Woy, money Penny
cairo Address W. VA
 Mineral rights are owned by same
 Address _____

| Casing and Tubing | Used in Drilling | Left in Well | Packers |
|-------------------|------------------|--------------|----------------|
| Size | | | Kind of Packer |
| 16 | | | |
| 13 | | | |
| 10 | 200 | none | Size of |
| 8 1/4 | 840 | none | |
| 6 1/2 | 1340 | 1340 | Depth set |
| 5 3/16 | | | |
| 3 | | | Perf. top |
| 2 | 1765 | 1765 | Perf. bottom |
| Liners Used | | | Perf. top |
| | | | Perf. bottom |

Drilling commenced _____
 Drilling completed _____
 Date Shot _____ From _____ To _____
 With _____
 Open Flow _____ /10ths Water in _____ Inch
 _____ /10ths Merc. in _____ Inch
 Volume _____ Cu. Ft.
 Rock Pressure _____ lbs. _____ hrs.
 Oil _____ bbls., 1st 24 hrs.
 Fresh water _____ feet _____ feet
 Salt water _____ feet _____ feet

CASING CEMENTED _____ SIZE _____ No. Ft. _____ Date _____
 COAL WAS ENCOUNTERED AT _____ FEET _____ INCHES
 _____ FEET _____ INCHES _____ FEET _____ INCHES
 _____ FEET _____ INCHES _____ FEET _____ INCHES

| Formation | Color | Hard or Soft | Top | Bottom | Oil, Gas or Water | Depth Found | Remarks |
|-----------|------------------------------|--------------|----------------|--------|-------------------|-------------|---------|
| | clay & red rock | | 000 | 990 | | | |
| | slate & shale | | 990 | | | | |
| | red cave | | 990' | 1090' | | | |
| | slate & shale | | 1090' | 1390' | | | |
| | lime | | 1390' | 1465' | | | |
| | slate & shale | | 1465' | 1645' | | | |
| | First & third salt sand | | 1645' | 1765' | | | |
| | | | total depth | 1765' | | | |

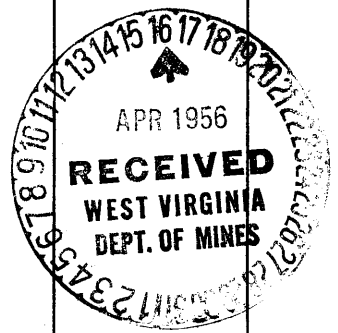

JUNE 21 1956

| Formation | Color | Hard or Soft | Top | Bottom | Oil, Gas or Water | Depth Found | Remarks |
|-----------|-------|--------------|-----|--------|-------------------|-------------|---------|
| | | | | | | | |

Date 4-12-56, 19__

APPROVED Piersol, Feick, & Hedimatz, Owner

By ER Piersol & Feick

(Title)