

Company Piersol Feick Skidmore & Feick

Address R2 Walker W. Va.

Farm McKinney & McCullum

Tract _____ Acres _____ Lease No. _____

Well (Farm) No. 1, 2, 3 Serial No. _____

Elevation (Spirit Level) #1-841 #2-777 #3-804

Quadrangle Harrisville

County Ritchie District Grant

Engineer Robert R. Anderson
by O. Meredith

Engineer's Registration No. 296

File No. _____ Drawing No. _____

Date Apr. 6, 56 Scale 1 in = 30 Poles

STATE OF WEST VIRGINIA
DEPARTMENT OF MINES
OIL AND GAS DIVISION
CHARLESTON

WELL LOCATION MAP
Rit - 1257-A-#1
FILE NO. Rit - 1258-A-#2
Rit - 1259-A-#3

+ Denotes location of well on United States Topographic Maps, scale 1 to 62,500, latitude and longitude lines being represented by border lines as shown.

- Denotes one inch spaces on border line of original tracing.

McKINNEY & McCULLUM NOS. 1, 2 & 3 - SKIDMORE & FEICK - RIT-125789A



STATE OF WEST VIRGINIA
DEPARTMENT OF MINES
OIL AND GAS DIVISION

1108

Quadrangle _____
Permit No. 1108

WELL RECORD

Oil or Gas Well _____
(KIND)



Company Pierson, Feick, Killbuck & Feick
 Address Walker, rt, 2 W. VA
 Farm Penney & McCullum Acres 157
 Location (waters) N. FK. Hughes, River
 Well No. 2 Elev. 777
 District Grant County Witchie
 The surface of tract is owned in fee by ROY, MONEY PENNY
Cairo Address W. VA
 Mineral rights are owned by same
 Address _____
 Drilling commenced about 1995
 Drilling completed same
 Date Shot From _____ To _____
 With _____

Casing and Tubing	Used in Drilling	Left in Well	Packers
Size			Kind of Packer
16			
13			
10	250'	none	Size of
8 1/4	800'	none	
6 3/8 = 1/4	1300'	1300'	Depth set
5 3/16			
3			Perf. top
2	1720'	1720'	Perf. bottom
Liners Used			Perf. top
			Perf. bottom

Open Flow _____ /10ths Water in _____ Inch
 _____ /10ths Merc. in _____ Inch
 Volume _____ Cu. Ft.
 Rock Pressure _____ lbs. _____ hrs.
 Oil _____ bbls., 1st 24 hrs.
 Fresh water _____ feet _____ feet
 Salt water _____ feet _____ feet

CASING CEMENTED _____ SIZE _____ No. Ft. _____ Date _____
 COAL WAS ENCOUNTERED AT _____ FEET _____ INCHES
 _____ FEET _____ INCHES FEET _____ INCHES
 _____ FEET _____ INCHES FEET _____ INCHES

Formation	Color	Hard or Soft	Top	Bottom	Oil, Gas or Water	Depth Found	Remarks
	clay & red rock		900	950'			
	red cave		950'	1055'			
	slate & shale		1055'	1350'			
	lime		1350'	1425'			
	slate & shale		1425'	1605'			
	first & third salt sand		1605	1725'			
			total depth 1725				

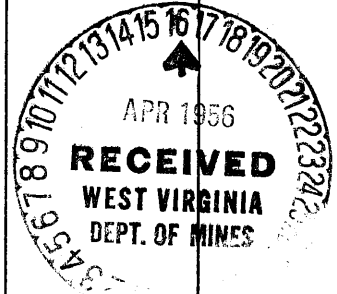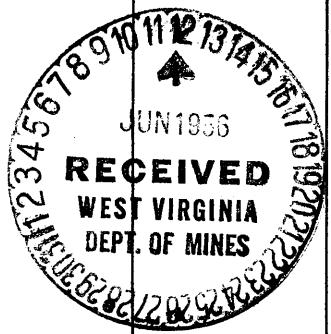

JUNE 21 1956

Formation	Color	Hard or Soft	Top	Bottom	Oil, Gas or Water	Depth Found	Remarks

Date 4-12-56, 19

APPROVED Piersol, Feick, Spidmorg Owner
By E R Piersol & Feick
(Title)