

Company Pierson Feick Skidmore & Feick
 Address R2 Walker W. Va.
 Farm McKinney & McCullum
 Tract _____ Acres _____ Lease No. _____
 Well (Farm) No. 1, 2, 3 Serial No. _____
 Elevation (Spirit Level) #1-841 #2-777 #3-804
 Quadrangle Harrisville
 County Ritchie District Grant
 Engineer Robert R. Anderson
by O. Meredith
 Engineer's Registration No. 296
 File No. _____ Drawing No. _____
 Date Apr. 6, 56 Scale 1 in = 30 Poles

STATE OF WEST VIRGINIA
DEPARTMENT OF MINES
OIL AND GAS DIVISION
CHARLESTON

WELL LOCATION MAP
 Ric - 1257-A-#1
 FILE NO. Ric - 1258-A-#2
 Ric - 1259-A-#3

+ Denotes location of well on United States Topographic Maps, scale 1 to 62,500, latitude and longitude lines being represented by border lines as shown.

- Denotes one inch spaces on border line of original tracing.

McKINNEY & McCULLUM NOS. 1, 2 & 3 - SKIDMORE & FEICK - RIT-125789A



STATE OF WEST VIRGINIA
DEPARTMENT OF MINES
OIL AND GAS DIVISION

1171

Quadrangle W. Va. 1171

Permit No. 1171

WELL RECORD

Oil or ~~Gas~~ Well _____
(KIND)


Company Piersol, Feick, Skidmore & Feick
Address Walker, rt, 2 W. VA
Farm McHenry & McCullum Acres 157
Location (waters) N. Fk. Hughes river
Well No. 3. Elev. 804
District Grant County Ritchie
The surface of tract is owned in fee by Roy Honey Penny
cairo W. VA Address _____
Mineral rights are owned by Same
Address _____

Casing and Tubing	Used in Drilling	Left in Well	Packers
Size			
16			Kind of Packer
13			
10	255'	none	Size of
8 3/4	805	none	
6 1/4	1305	1305	Depth set
5 3/16			
3			Perf. top
2	1725	1725	Perf. bottom
Liners Used			Perf. top
			Perf. bottom

Drilling commenced _____
Drilling completed _____
Date Shot _____ From _____ To _____
With _____
Open Flow _____ /10ths Water in _____ Inch
_____ /10ths Merc. in _____ Inch
Volume _____ Cu. Ft.
Rock Pressure _____ lbs. _____ hrs.
Oil _____ bbls., 1st 24 hrs.
Fresh water _____ feet _____ feet
Salt water _____ feet _____ feet

CASING CEMENTED _____ SIZE _____ No. Ft. _____ Date _____
COAL WAS ENCOUNTERED AT _____ FEET _____ INCHES
_____ FEET _____ INCHES _____ FEET _____ INCHES
_____ FEET _____ INCHES _____ FEET _____ INCHES

Formation	Color	Hard or Soft	Top	Bottom	Oil, Gas or Water	Depth Found	Remarks
clay & red rock			000	955			
red cave			955	1055			
slate & shale			1055	1355			
lime			1355	1430			
slate & shale			1430	1610			
First & Third salt sand			1610	1730'			
			total depth	1730'			

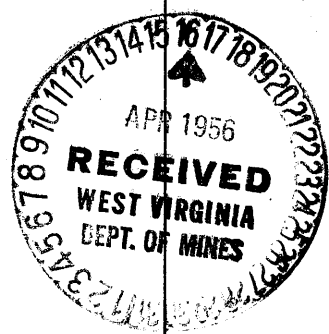

JUNE 21 1956

Formation	Color	Hard or Soft	Top	Bottom	Oil, Gas or Water	Depth Found	Remarks

Date 4-12-36, 19

APPROVED Piersol, Feuck, Skidmore Owner

By E. A. Piersol & Feuck
(Title)