


Latitude 39° 15'

Longitude 80° 55'

N

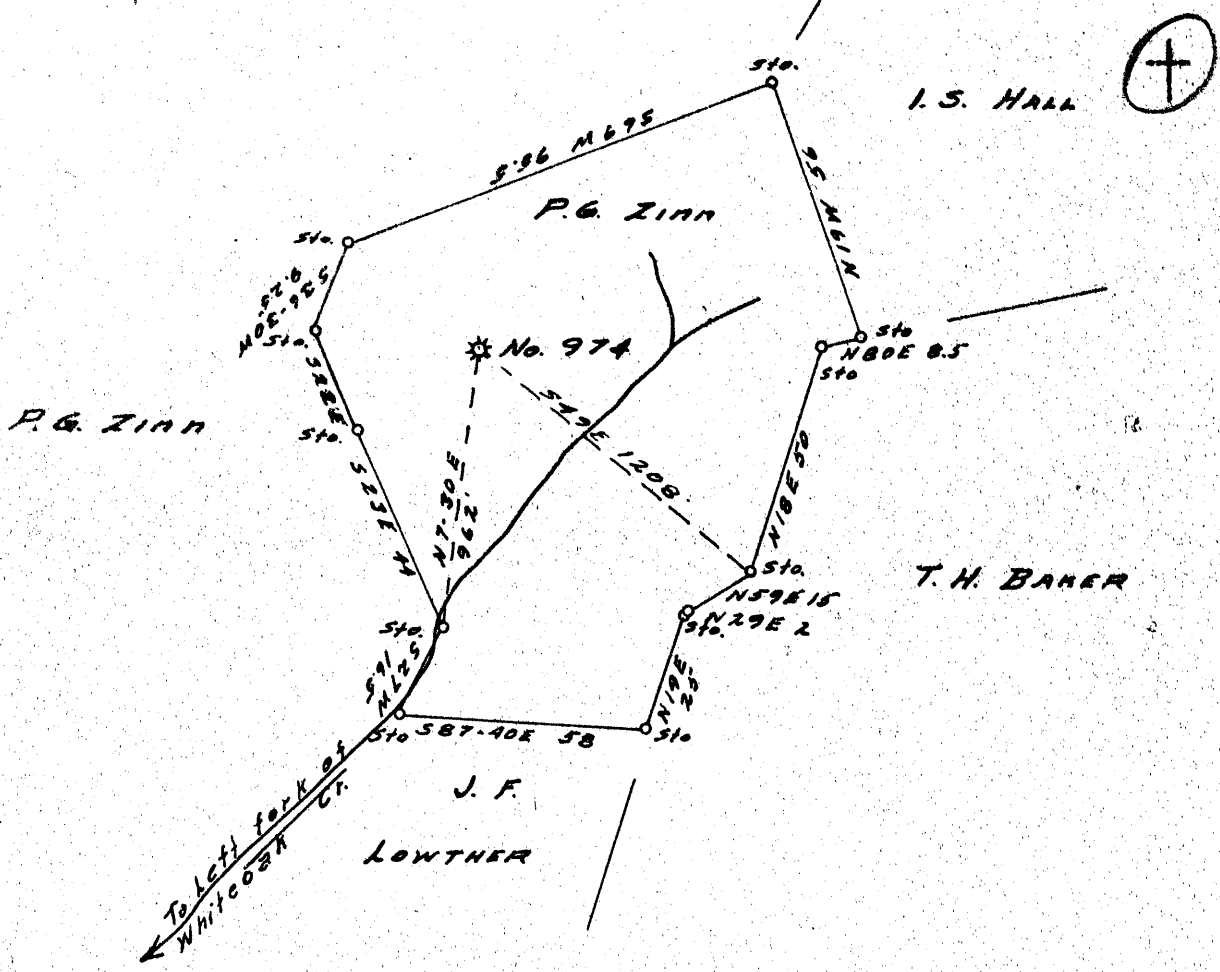

New Location..
 Drill Deeper.....
 Abandonment.....

NOV. 12 1956

0.9 W
 3.44

Company CARNEGIE NATURAL GAS
 Address PITTSBURGH PA.
 Farm P.G. ZINN
 Tract _____ Acres 66 Lease No. E-10138
 Well (Farm) No. 1 Serial No. E 974
 Elevation (Spirit Level) 1023'
 Quadrangle HOLBROOK
 County FITCHIE District UNION
 Engineer John O. Book
 Engineer's Registration No. 1850
 File No. _____ Drawing No. _____
 Date 9-27-56 Scale 1" = 40 FEET

STATE OF WEST VIRGINIA
 DEPARTMENT OF MINES
 OIL AND GAS DIVISION
 CHARLESTON

WELL LOCATION MAP
 FILE NO. RIT-1266-A

+ Denotes location of well on United States Topographic Maps, scale 1 to 62,500, latitude and longitude lines being represented by border lines as shown.
 - Denotes one inch spaces on border line of original tracing.



1119

STATE OF WEST VIRGINIA
DEPARTMENT OF MINES
OIL AND GAS DIVISION

WELL RECORD

Holbrook Gen'd
Permit No. 1266A

WELL TO BE ABANDONED

Oil or Gas Well Gas
(KIND)

Company Carnegie Natural Gas Company
 Address 1015 Frick Building, Pittsburgh 19, Pa.
 Farm P. G. Zinn Acres 66
 Location (waters) Left Fork, White Oak
 Well No. 1-974 Elev. 1023
 District Union County Ritchie
 The surface of tract is owned in fee by James G. Zinn
7500 Pearl Street Address Bethesda 11, Md.
 Mineral rights are owned by See below
 Address _____
 Drilling commenced 5-25-20
 Drilling completed 7-15-20
 Date Shot _____ From _____ To _____
 With _____
 Open Flow _____ /10ths Water in _____ Inch
 _____ /10ths Merc. in _____ Inch
 Volume 830,000 Cu. Ft.
 Rock Pressure 515 lbs. _____ hrs.
 Oil _____ bbls., 1st 24 hrs.
 Fresh water _____ feet _____ feet
 Salt water _____ feet _____ feet

Casing and Tubing	Used in Drilling	Left in Well	Packers
Size			Kind of Packer
16			
13			
10	<u>103</u>	<u>None</u>	Size of
8 1/4	<u>1210</u>	<u>None</u>	
6 1/2	<u>1939</u>		Depth set
5 3/16			
3			Perf. top
2			Perf. bottom
Liners Used			Perf. top
			Perf. bottom

CASING CEMENTED _____ SIZE _____ No. Ft. _____ Date _____


COAL WAS ENCOUNTERED AT 685 FEET _____ INCHES
 _____ FEET _____ INCHES _____ FEET _____ INCHES
 _____ FEET _____ INCHES _____ FEET _____ INCHES

Formation	Color	Hard or Soft	Top	Bottom	Oil, Gas or Water	Depth Found	Remarks
Pittsburgh Coal			685	690			
Gas Sand			1290	1310			
1st Salt Sand			1515	1600			
2nd Salt Sand			1685	1850	Show gas	1745	
Maxon Sand			1860	1880			
Big Lime			1909	1986	Show oil	1925 - 1929	
Big Injun			1986	2040	Gas	1989 - 1997	
TOTAL DEPTH				2089			

MINERAL RIGHTS OWNED BY:

Cliff Wilson, Attorney-in-fact for Heirs of P. G. Zinn
Pennsboro, W. Va.

Hugh S. Lowther,
P. O. Box 276
San Gabriel, California

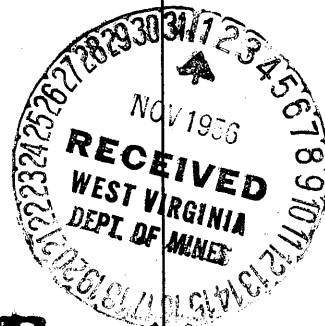

JUN 20 1957

Formation	Color	Hard or Soft	Top	Bottom	Oil, Gas or Water	Depth Found	Remarks

Date October 29, 1956

APPROVED Carnegie Natural Gas Company, Owner

By [Signature]
(Title) Land Agent.