


Latitude 39° 10'

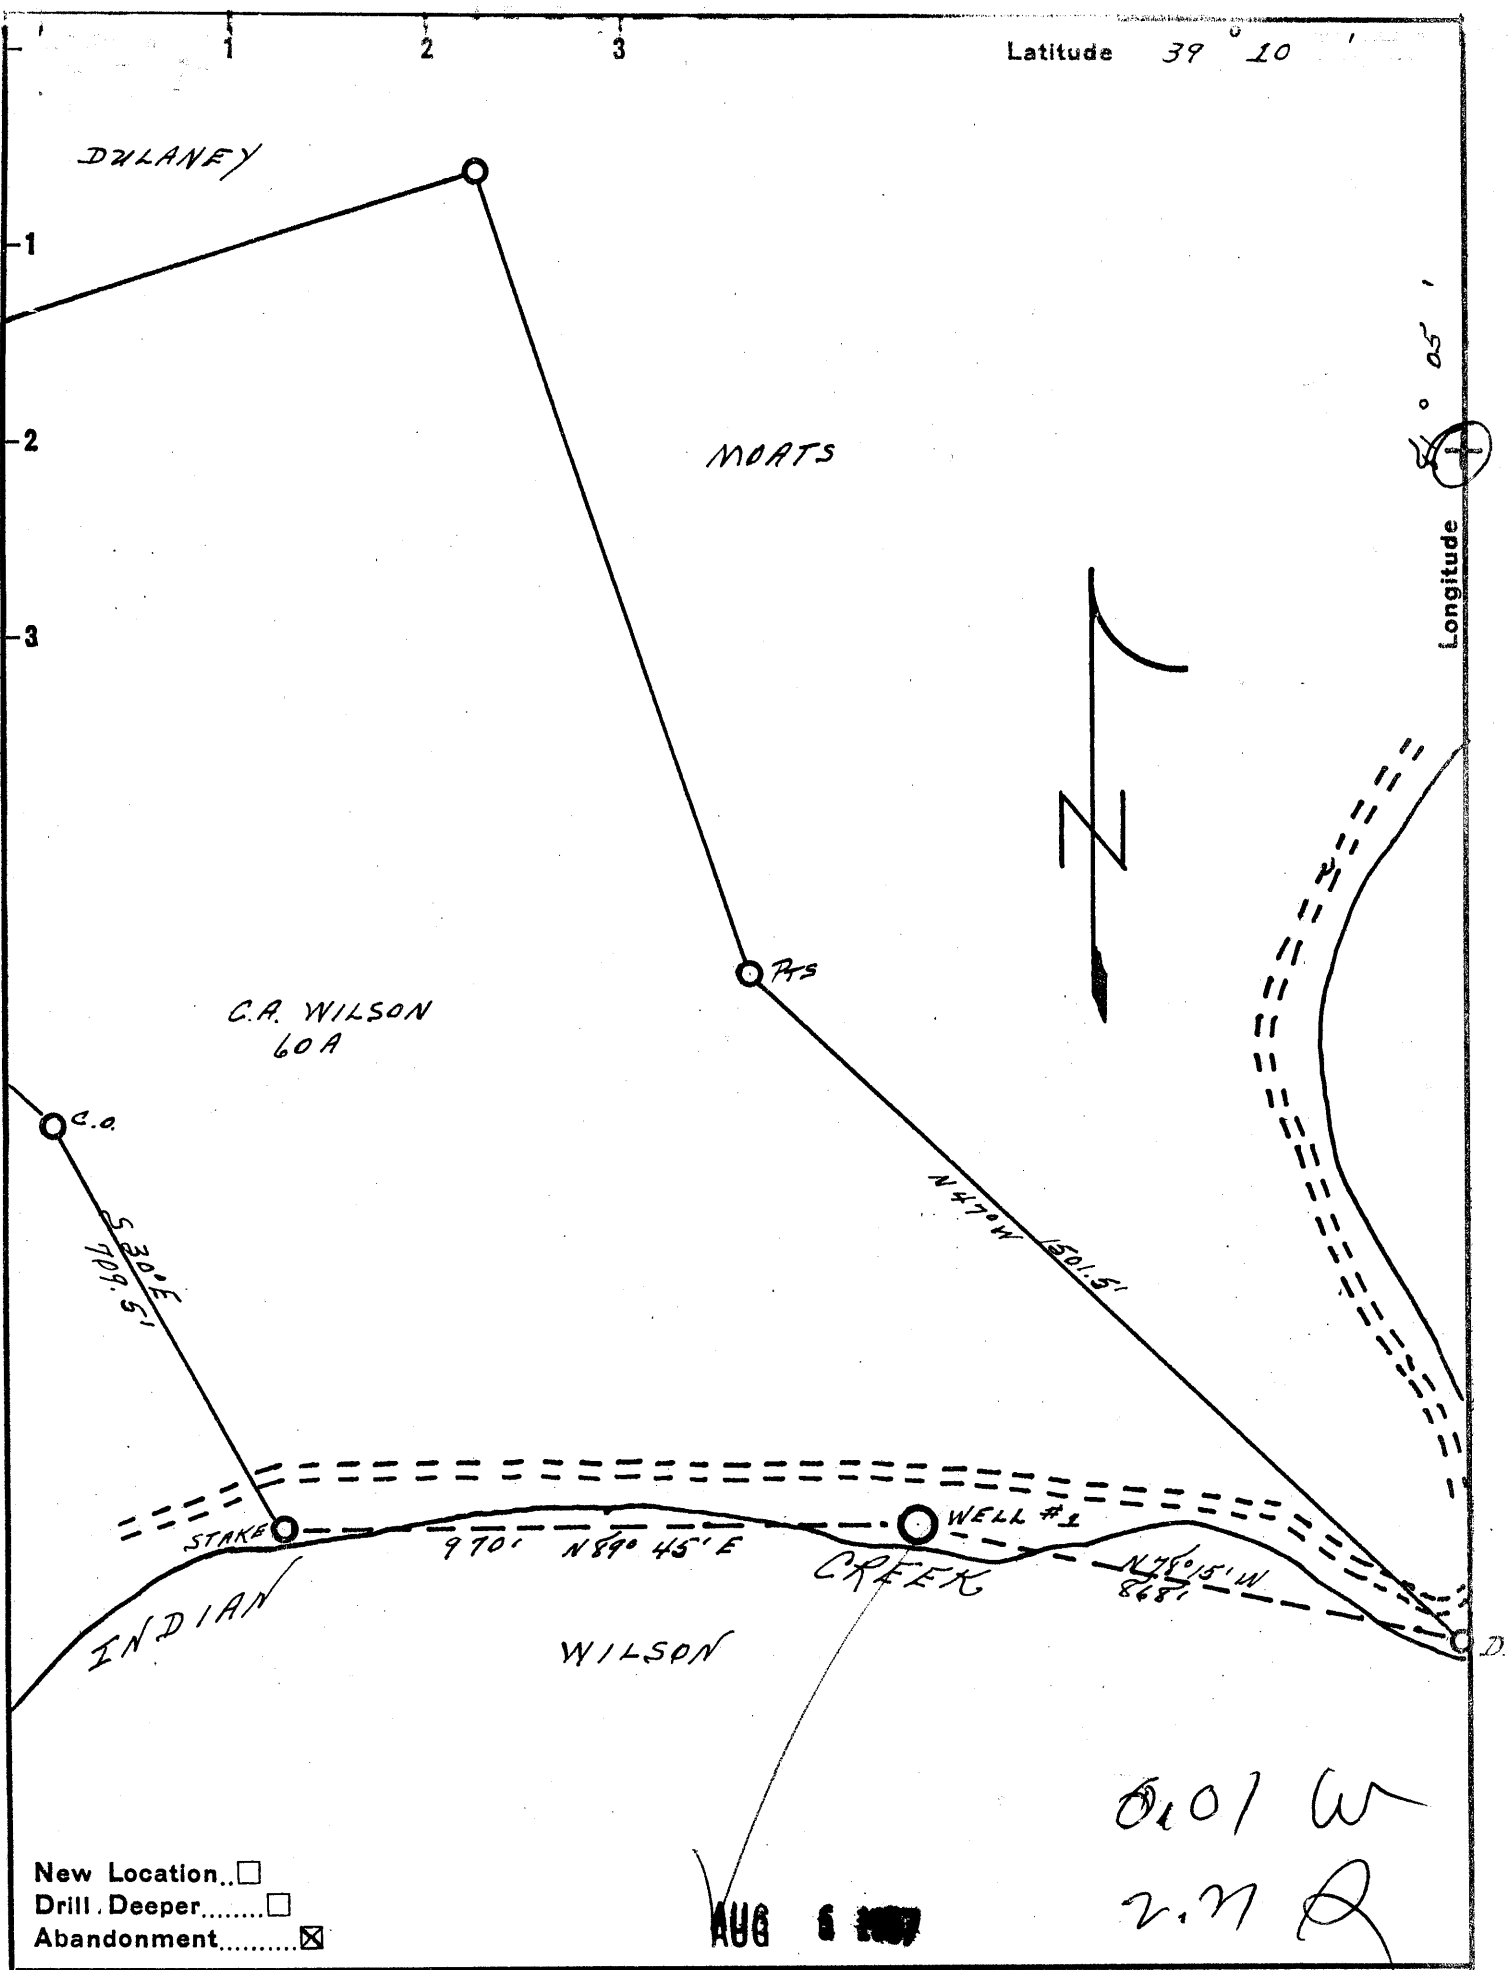

New Location..
 Drill Deeper.....
 Abandonment.....

AUG 6 1957

0.01 W
 2.77 Q

Company HANLON OIL CO.
 Address HARRISVILLE, W. VA.
 Farm C. A. WILSON
 Tract _____ Acres 60 Lease No. _____
 Well (Farm) No. 1 Serial No. _____
 Elevation (Spirit Level) _____ 730'
 Quadrangle HARRISVILLE
 County RITCHIE District MURPHY
 Engineer Donald W. Morris
 BY: J. F. DEEM
 Engineer's Registration No. 1653
 File No. _____ Drawing No. _____
 Date JULY 6, 1957 Scale 1" = 300'

STATE OF WEST VIRGINIA
 DEPARTMENT OF MINES
 OIL AND GAS DIVISION
 CHARLESTON

WELL LOCATION MAP
 FILE NO. Rit-1273-A

+ Denotes location of well on United States Topographic Maps, scale 1 to 62,500, latitude and longitude lines being represented by border lines as shown.
 - Denotes one inch spaces on border line of original tracing.

C. A. WILSON No. 1

HANLON OIL CO.

RIT-1273-A

STATE OF WEST VIRGINIA
DEPARTMENT OF MINES
OIL AND GAS DIVISION

1123

WELL RECORD

Harrisonville
Ab 1273-A

Permit No. 1273-A Oil or Gas Well Oil
(Kind)

Company Hanlon Oil Company
Address Sistersville, W. Va.
Farm C. A. Wilson Acres 164 1/2
Location (waters) _____
Well No. 1 Elev. 730
District Murphy County Ritchie
The surface of tract is owned in fee by C. A. Wilson
952 35th St., Parkersburg, W. Va.
Mineral rights are owned by R. I. - C. A. Wilson
W. I. - Hanlon Oil Co., Press.
Drilling commenced _____
Drilling completed _____
Date shot _____ Depth of shot _____
Open Flow /10ths Water in _____ Inch
/10ths Merc. in _____ Inch
Volume _____ Cu. Ft.
Rock Pressure _____ lbs. _____ hrs.
Oil _____ bbls., 1st 24 hrs.
Fresh water _____ feet _____ feet
Salt water _____ feet _____ feet

Casing and Tubing	Used in Drilling	Left in Well	Packers
Size			
16	16		Kind of Packer
13			
10	66		Size of
8 1/4	832		
6 5/8		1270	Depth set
5 3/16			
3			Perf. top
2			Perf. bottom
Liners Used			Perf. top
			Perf. bottom

CASING CEMENTED _____ SIZE _____ No. Ft. _____ Date _____
COAL WAS ENCOUNTERED AT _____ FEET _____ INCHES
_____ FEET _____ INCHES _____ FEET _____ INCHES
_____ FEET _____ INCHES _____ FEET _____ INCHES

Formation	Color	Hard or Soft	Top	Bottom	Oil, Gas or Water	Depth Found	Remarks
Sand			1270	1380			
Gas Sand			1484	1535			
Maxon Sand			1552	1579	Gas	1554	
					Oil	1556-60	
Big Lime			1621	1699			
Injun (Limey)			1699	1744	Gas	1715-25	
Total depth,				1789			

DEC 6 1957

Formation	Color	Hard or Soft	Top	Bottom	Oil, Gas or Water	Depth Found	Remarks

Date July 17, 19 57

APPROVED HANLON OIL COMPANY, Owner

By [Signature]
Secretary. (Title)