

New Location..   
 Drill Deeper.....   
 Abandonment.....

NOTE: Well No. 1 formerly Hope Natural Gas Co.  
 Well No. 2518  
**AUG 17 1958**

3.5 W  
 4.9 x 2

Company A. M. SNIDER  
 Address HUNDRED, W. VA.  
 Farm J. C. BEARD  
 Tract \_\_\_\_\_ Acres 36 Lease No. \_\_\_\_\_  
 Well (Farm) No. 1 Serial No. \_\_\_\_\_  
 Elevation (Spirit Level) 1010'  
 Quadrangle WEST UNION  
 County RITCHIE District CLAY  
 Engineer JOHN W. HAMILTON  
 Engineer's Registration No. 2274  
 File No. \_\_\_\_\_ Drawing No. \_\_\_\_\_  
 Date JAN. 31, 1958 Scale 1" = 20 POLES

STATE OF WEST VIRGINIA  
 DEPARTMENT OF MINES  
 OIL AND GAS DIVISION  
 CHARLESTON

**WELL LOCATION MAP**  
 FILE NO. RIT-1281-A

PLUGGED BY: PENNSBORO PIPE & SUPPLY.

+ Denotes location of well on United States Topographic Maps, scale 1 to 62,500, latitude and longitude lines being represented by border lines as shown.

- Denotes one inch spaces on border line of original tracing.

J. C. BEARD (No. 1) — (PENNSBORO PIPE & SUPPLY Co.)  
 A. M. SNIDER — RIT-1281A



1124

STATE OF WEST VIRGINIA  
DEPARTMENT OF MINES  
OIL AND GAS DIVISION

WELL RECORD

Permit No. West Union  
Rit-1281-A

Oil or Gas Well Gas  
(KIND)



Company Pennsboro Pipe Supply  
Address Pennsboro, W. Va.  
Farm J. C. Board Acres 36  
Location (waters) \_\_\_\_\_  
Well No. 1 Elev. 1010  
District Clay County Ritchie  
The surface of tract is owned in fee by Florence Hurst  
Address Pennsboro, W. Va.  
Mineral rights are owned by \_\_\_\_\_  
Address \_\_\_\_\_  
Drilling commenced \_\_\_\_\_  
Drilling completed 1912  
Date Shot None From \_\_\_\_\_ To \_\_\_\_\_  
With \_\_\_\_\_  
Open Flow /10ths Water in \_\_\_\_\_ Inch  
/10ths Merc. in \_\_\_\_\_ Inch  
Volume \_\_\_\_\_ Cu. Ft.  
Rock Pressure \_\_\_\_\_ lbs. \_\_\_\_\_ hrs.  
Oil \_\_\_\_\_ bbls., 1st 24 hrs.  
Fresh water \_\_\_\_\_ feet \_\_\_\_\_ feet  
Salt water \_\_\_\_\_ feet \_\_\_\_\_ feet

Casing and Tubing	Used in Drilling	Left in Well	Packers
Size			
16			Kind of Packer _____
13			<u>Bottom Hole</u>
10	<u>296</u>	<u>-0-</u>	Size of _____
8 1/4	<u>1116</u>	<u>-0-</u>	<u>6 1/2</u>
6 5/8	<u>1564</u>	<u>1564</u>	Depth set <u>1964</u>
5 3/16	<u>1964</u>	<u>1964</u>	
3			Perf. top _____
2			Perf. bottom _____
Liners Used			Perf. top _____
			Perf. bottom _____

CASING CEMENTED \_\_\_\_\_ SIZE \_\_\_\_\_ No. Ft. \_\_\_\_\_ Date \_\_\_\_\_

COAL WAS ENCOUNTERED AT \_\_\_\_\_ FEET \_\_\_\_\_ INCHES  
\_\_\_\_\_ FEET \_\_\_\_\_ INCHES FEET \_\_\_\_\_ INCHES  
\_\_\_\_\_ FEET \_\_\_\_\_ INCHES FEET \_\_\_\_\_ INCHES

Formation	Color	Hard or Soft	Top	Bottom	Oil, Gas or Water	Depth Found	Remarks
Dunkard Sand			1115	1125			
Salt Sand			1225	1530			
Waxon Sand			1790	1875			
Injun Sand			2026	2120	Gas 2077 Gas 2096		
Total Depth				2228			

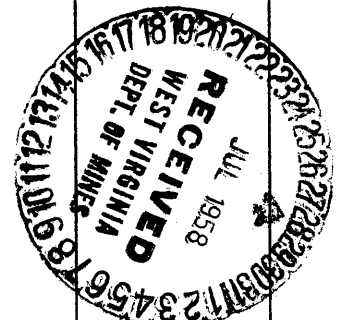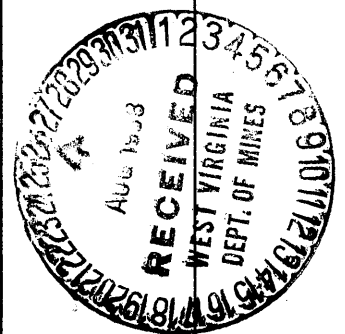

DEC 20 1958

Formation	Color	Hard or Soft	Top	Bottom	Oil, Gas or Water	Depth Found	Remarks

Date July 25, 19 58

APPROVED Bennett Pipe Supply, Owner

By J. Walker, Owner  
(Title)