

New Location   
 Drill Deeper   
 Abandonment

Company LURAY LAND, INC.  
 Address POINT PLEASANT, W.VA.  
 Farm MAXWELL BROS.  
 Tract \_\_\_\_\_ Acres 318 Lease No. 6333  
 Well (Farm) No. 1 Serial No. 6333 (H.P.)  
 Elevation (Spirit Level) 879'  
 Quadrangle HOLBROOK  
 County RITCHIE District MURPHY  
 Engineer H.P. SUTER  
 Engineer's Registration No. 1805  
 File No. \_\_\_\_\_ Drawing No. \_\_\_\_\_  
 Date 4 MAR. 1959 Scale 1" = 30 POLES

STATE OF WEST VIRGINIA  
 DEPARTMENT OF MINES  
 OIL AND GAS DIVISION  
 CHARLESTON

**WELL LOCATION MAP**  
 FILE NO. Rit-1290-A

+ Denotes location of well on United States Topographic Maps, scale 1 to 62,500, latitude and longitude lines being represented by border lines as shown.  
 - Denotes one inch spaces on border line of original tracing.

MAXWELL BROS. No. 1 (6333) LURAY LAND INC. - RIT-1290-A



114

STATE OF WEST VIRGINIA  
DEPARTMENT OF MINES  
OIL AND GAS DIVISION

Quadrangle Halbrook

Permit No. 1240 A

WELL RECORD

Oil or Gas Well \_\_\_\_\_ (KIND)

Company Hope Natural Gas Company  
Address Clarksburg, West Virginia  
Farm Maxwell Bros. Acres 318

Location (waters) \_\_\_\_\_  
Well No. 6333 Elev. 879'  
District Murphy County Ritchie

The surface of tract is owned in fee by \_\_\_\_\_  
Address \_\_\_\_\_

Mineral rights are owned by \_\_\_\_\_  
Address \_\_\_\_\_

Drilling commenced 5-18-1923  
Drilling completed 7-31-23

Date Shot \_\_\_\_\_ From \_\_\_\_\_ To \_\_\_\_\_

With \_\_\_\_\_

Open Flow \_\_\_\_\_ /10ths Water in \_\_\_\_\_ Inch  
\_\_\_\_\_ /10ths Merc. in \_\_\_\_\_ Inch

Volume \_\_\_\_\_ Cu. Ft.

Rock Pressure \_\_\_\_\_ lbs. \_\_\_\_\_ hrs.

Oil \_\_\_\_\_ bbls., 1st 24 hrs.

WELL ACIDIZED \_\_\_\_\_

WELL FRACTURED \_\_\_\_\_

RESULT AFTER TREATMENT \_\_\_\_\_

ROCK PRESSURE AFTER TREATMENT \_\_\_\_\_

Fresh Water \_\_\_\_\_ Feet Salt Water \_\_\_\_\_ Feet

Casing and Tubing	Used in Drilling	Left in Well	Packers
Size			Kind of Packer _____
16			
13			
10	344'	-0-	Size of _____
8 3/4	1167'	1167'	
6 3/8	1773'	1773'	Depth set _____
5 3/16			
3			Perf. top _____
2	1869'	1869'	Perf. bottom _____
Liners Used			Perf. top _____
<u>Packer 1785'</u>			Perf. bottom _____



CASING CEMENTED \_\_\_\_\_ SIZE \_\_\_\_\_ No. Ft. \_\_\_\_\_ Date \_\_\_\_\_

COAL WAS ENCOUNTERED AT \_\_\_\_\_ FEET \_\_\_\_\_ INCHES

\_\_\_\_\_ FEET \_\_\_\_\_ INCHES FEET \_\_\_\_\_ INCHES

\_\_\_\_\_ FEET \_\_\_\_\_ INCHES FEET \_\_\_\_\_ INCHES

Formation	Color	Hard or Soft	Top	Bottom	Oil, Gas or Water	Depth	Remarks	
Dunkard Sand L			825	850	Water at 125  	1785		
Dunkard Sand B			950	1060				
Gas Sand			1150	1265				
1st Salt Sand			1295	1330				
2nd Salt Sand			1400	1465				
Sand			1535	1560				
Maxon Sand			1595	1635				
Sand			1686	1705				
Little Line			1705	1728				
Sand			1730	1737				
Big Line			1737	1800				
Injun Sand			1800	1857				
Total Depth				1840				
Deeper				1861				

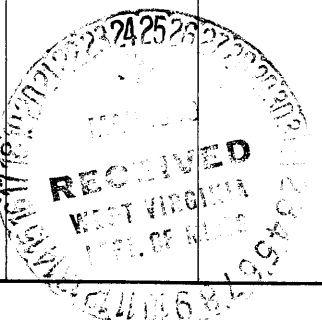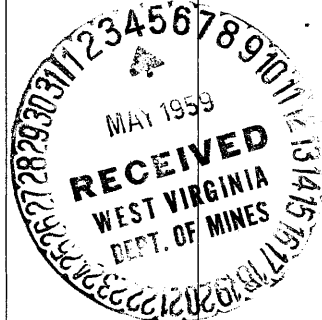

JUL 23 1959

Formation	Color	Hard or Soft	Top	Bottom	Oil, Gas or Water	Depth Found	Remarks

Date **March 19,** 19 **59**

APPROVED **Lutay Land, Inc.**, Owner

*Byron M. Finch*  
**Byron M. Finch** (Title) **Consultant**