

- New Location ..
- Drill Deeper ..
- Abandonment ..

Formerly Hope Natural Gas Co. Well No 6385

Company	LURAY LAND, INC.	
Address	POINT PLEASANT, W. VA.	
Farm	J. W. GOFF	
Tract	Acres 220	Lease No.
Well (Farm) No.	1	Serial No. 6385 (H.P.)
Elevation (Spirit Level)	779'	
Quadrangle	HOLBROOK	
County	RITCHIE	District MURPHY
Engineer	H. P. SUTER	
Engineer's Registration No.	1805	
File No.	Drawing No.	
Date 4 MAR. 1959	Scale 1" = 800'	

STATE OF WEST VIRGINIA
DEPARTMENT OF MINES
OIL AND GAS DIVISION
CHARLESTON

WELL LOCATION MAP

FILE NO. RIT-1291-A

+ Denotes location of well on United States Topographic Maps, scale 1 to 62,500, latitude and longitude lines being represented by border lines as shown.

- Denotes one inch spaces on border line of original tracing.

J. W. GOFF (6385) — LURAY LAND, INC. — RIT-1291A



1140

STATE OF WEST VIRGINIA
DEPARTMENT OF MINES
OIL AND GAS DIVISION

Quadrangle Nalbrook

Permit No. 1291-A

WELL RECORD

~~Oil~~ or Gas Well _____ (KIND)

Company Hope Natural Gas Company
Address Clarksburg, West Virginia
Farm J.W. Goff Acres 270

Location (waters) _____
Well No. 6385 Elev. 779'
District Murphy County Ritchie

The surface of tract is owned in fee by _____
Address _____

Mineral rights are owned by _____
Address _____

Drilling commenced Sept. 10, 1923

Drilling completed Dec. 23, 1923

Date Shot 1-7-24 From Injun To _____

With _____

Open Flow _____ /10ths Water in _____ Inch

_____ /10ths Merc. in _____ Inch

Volume _____ Cu. Ft.

Rock Pressure _____ lbs. _____ hrs.

Oil _____ bbls., 1st 24 hrs.

WELL ACIDIZED _____

WELL FRACTURED _____

RESULT AFTER TREATMENT _____

ROCK PRESSURE AFTER TREATMENT _____

Fresh Water _____ Feet

Salt Water _____ Feet

Casing and Tubing	Used in Drilling	Left in Well	Packers
Size			Kind of Packer _____
16			
13			
10	56'	Pulled	Size of _____
8 1/4	414'	414'	
6 5/8	1123'	Pulled	Depth set _____
5 3/16	1650'	1650'	
3			Perf. top _____
2	1811'	1811'	Perf. bottom _____
Liners Used			Perf. top _____
			Perf. bottom _____

CASING CEMENTED _____ SIZE _____ No. Ft. _____ Date _____

COAL WAS ENCOUNTERED AT _____ FEET _____ INCHES


_____ FEET _____ INCHES _____ FEET _____ INCHES

_____ FEET _____ INCHES _____ FEET _____ INCHES

Formation	Color	Hard or Soft	Top	Bottom	Oil, Gas or Water	Depth	Remarks
Pittsburgh Coal			115'				
Sand			350	370			
Dunkard Sand			730	760			
Gas Sand			880	990			
Sand			1010	1158			
1st Salt Sand			1170	1215	Gas at 1030		
Sand			1280	1305	"	1353'	
2nd Salt Sand			1310	1385	"	1455'	
Maxon Sand			1410	1485	"		
Little Lime			1600	1625	"		
Big Lime			1630	1690	"	1637-39'	
Injun Sand			1690	1768	"	1746'	

to 1811 (R) from top

JUL 23 1959

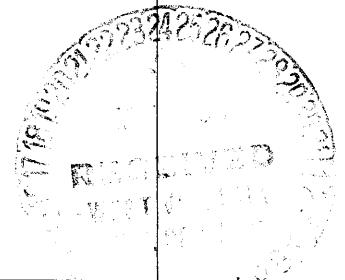

Formation	Color	Hard or Soft	Top	Bottom	Oil, Gas or Water	Depth Found	Remarks

March 19, 1959

Date _____, 19____

Lurray Land, Inc.

APPROVED _____, Owner

By Byron M. Finch
 Byron M. Finch (Title) Consultant