

Company LURAY LAND, INC.
 Address POINT PLEASANT, WEST VA.
 Farm A. G. BEE
 Tract _____ Acres 118 Lease No. _____
 Well (Farm) No. 1 Serial No. _____
 Elevation (Spirit Level) 944'
 Quadrangle HOLBROOK
 County RITCHIE District UNION
 Engineer H. P. SUTER
 Engineer's Registration No. 1805
 File No. _____ Drawing No. _____
 Date 8 APRIL, 1959 Scale 1" = 30 POLES

STATE OF WEST VIRGINIA
 DEPARTMENT OF MINES
 OIL AND GAS DIVISION
 CHARLESTON

WELL LOCATION MAP
 FILE NO. Rit-1294-A

+ Denotes location of well on United States Topographic Maps, scale 1 to 62,500, latitude and longitude lines being represented by border lines as shown.
 - Denotes one inch spaces on border line of original tracing.



1135

STATE OF WEST VIRGINIA
DEPARTMENT OF MINES
OIL AND GAS DIVISION

Quadrangle Halbrook

Permit No. 1294-A

WELL RECORD

Oil or Gas Well _____ (KIND)

Company Hope Natural Gas Company
Address Clarksburg, West Virginia
Farm A. G. Bee Acres 118

Location (waters) _____
Well No. 5993 Elev. 944'
District Union County Ritchie

The surface of tract is owned in fee by _____
Address _____

Mineral rights are owned by _____
Address _____

Drilling commenced 5-4-21
Drilling completed 9-12-21

Date Shot 10-8-30 From Injun To _____

With _____
Open Flow _____ /10ths Water in _____ Inch
_____ /10ths Merc. in _____ Inch

Volume _____ Cu. Ft.

Rock Pressure _____ lbs. _____ hrs.

Oil _____ bbls., 1st 24 hrs.

WELL ACIDIZED _____

WELL FRACTURED _____

RESULT AFTER TREATMENT _____

ROCK PRESSURE AFTER TREATMENT _____


Fresh Water _____ Feet Salt Water _____ Feet

Casing and Tubing	Used in Drilling	Left in Well	Packers
Size			Kind of Packer _____
16			
13			
10	163'	163'	Size of _____
8 1/4	1004'	1004'	
6 5/8	1771'	1771'	Depth set _____
5 3/16			
3	59'	-0-	Perf. top _____
2	1844'	-0-	Perf. bottom _____
Liners Used			Perf. top _____
			Perf. bottom _____

CASING CEMENTED _____ SIZE _____ No. Ft. _____ Date _____

COAL WAS ENCOUNTERED AT 600 FEET _____ INCHES
_____ FEET _____ INCHES FEET _____ INCHES
_____ FEET _____ INCHES FEET _____ INCHES

Formation	Color	Hard or Soft	Top	Bottom	Oil, Gas or Water	Depth	Remarks
			300	305			
Pittsburgh Coal			600'	605'			
L. Dunkard Sand			780'	840			
Red Rock			840	860			
B. Dunkard Sand			1004	1040			
Gas Sand			1175	1235			
Salt Sand			1250	1465			
Maxon Sand			1670	1705		Gas at 1687-88 1844-48	
Little Lime			1760	1765			
Big Lime			1770	1835			
Injun Sand			1825x				
Total Depth				1856			

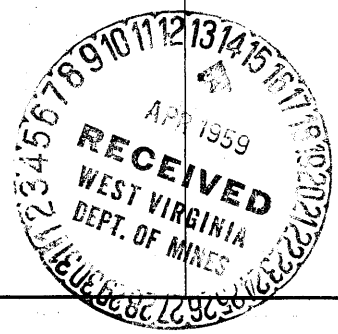

Formation	Color	Hard or Soft	Top	Bottom	Oil, Gas or Water	Depth Found	Remarks

Date March 5, 19 59

APPROVED LuRay Land, Inc., Owner

By Byron M. Finch
 Byron M. Finch (Title) Consultant