


2350

Latitude 39 ° 10 '

Longitude 80 ° 55 '

23,100

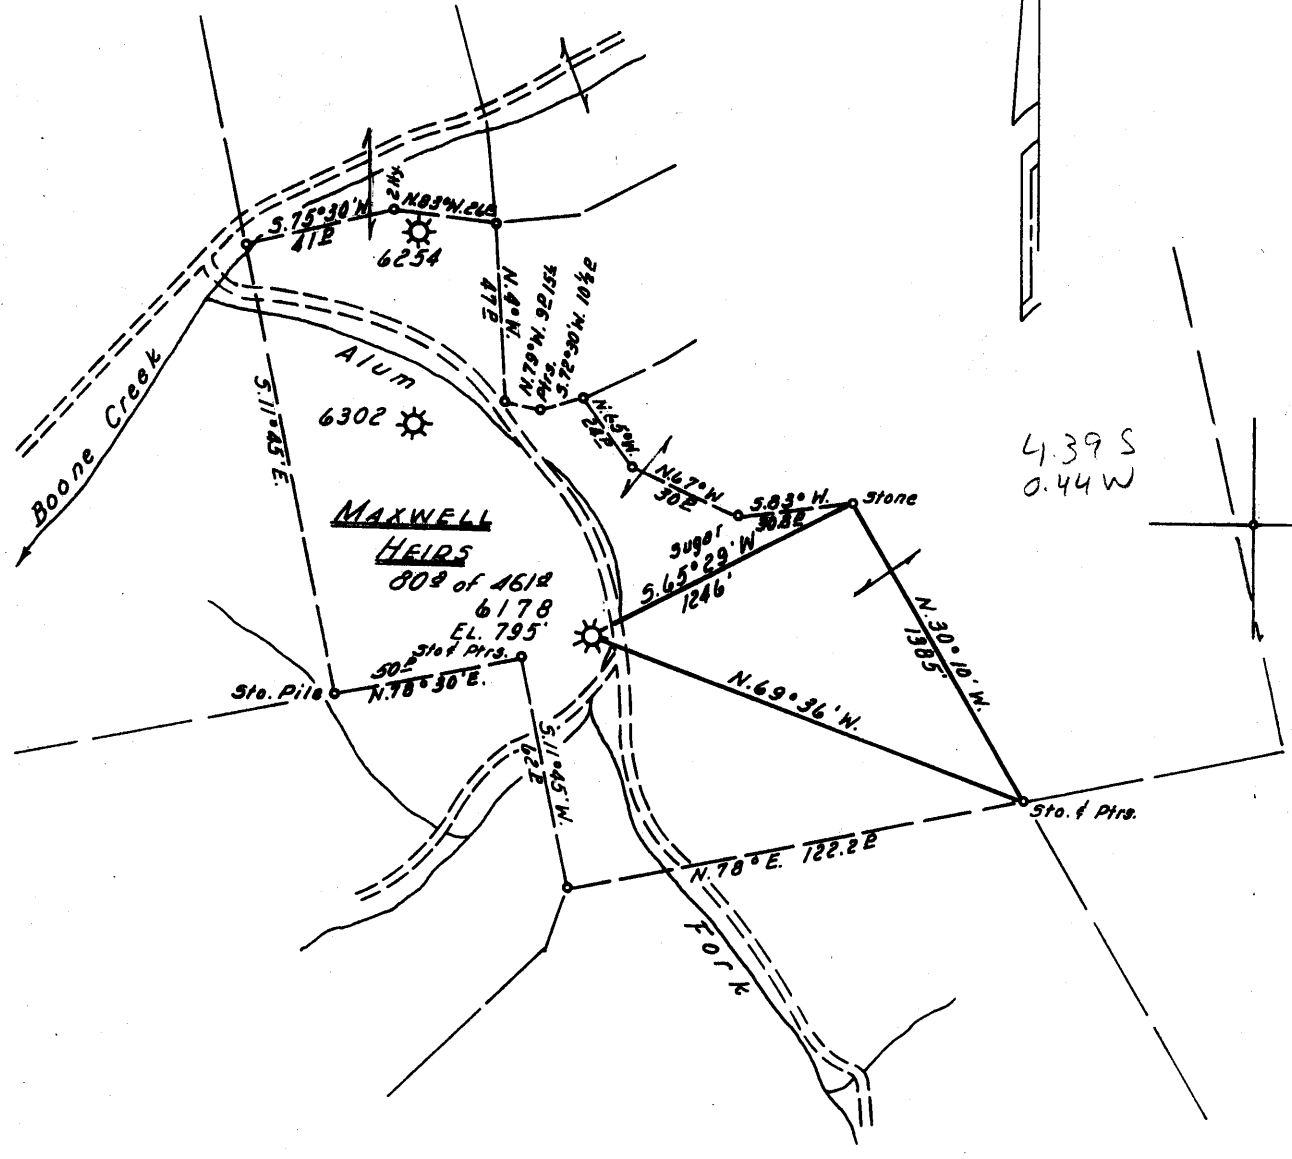

4.39 S
0.44 W

MAP SHEET 74, S-23 W-18, F.B. 683 P.22124

Minimum Error of Closure 1' IN 200'

Source of Elevation H.M.G.Co. WELL # 6177 EL. 1074'

New Location

Drill Deeper

Abandonment

"I, the undersigned, hereby certify that this map is correct to the best of my knowledge and belief and shows all the information required by paragraph 6 of the rules and regulations of the oil and gas section of the mining laws of West Virginia."

Company HOPE NATURAL GAS Co.

Address CLARKSBURG, W.VA.

Farm MAXWELL HEIRS

Tract _____ Acres 461 Lease No. 37959

Well (Farm) No. _____ Serial No. 6178

Elevation (Spirit Level) 795'

Quadrangle HOLBROOK W.C.

County RITCHIE District UNION

Engineer Jackson M. Jarvis

Engineer's Registration No. 2397

File No. _____ Drawing No. _____

Date 12-31-64 Scale 1" = 50 POLES

STATE OF WEST VIRGINIA
DEPARTMENT OF MINES
OIL AND GAS DIVISION
CHARLESTON

WELL LOCATION MAP
FILE NO. Rit-1408-A

+ Denotes location of well on United States Topographic Maps, scale 1 to 62,500, latitude and longitude lines being represented by border lines as shown.

- Denotes one inch spaces on border line of original tracing.