


LATITUDE

39 20

0 → OGIS
7.5' loc

05 08

LONGITUDE

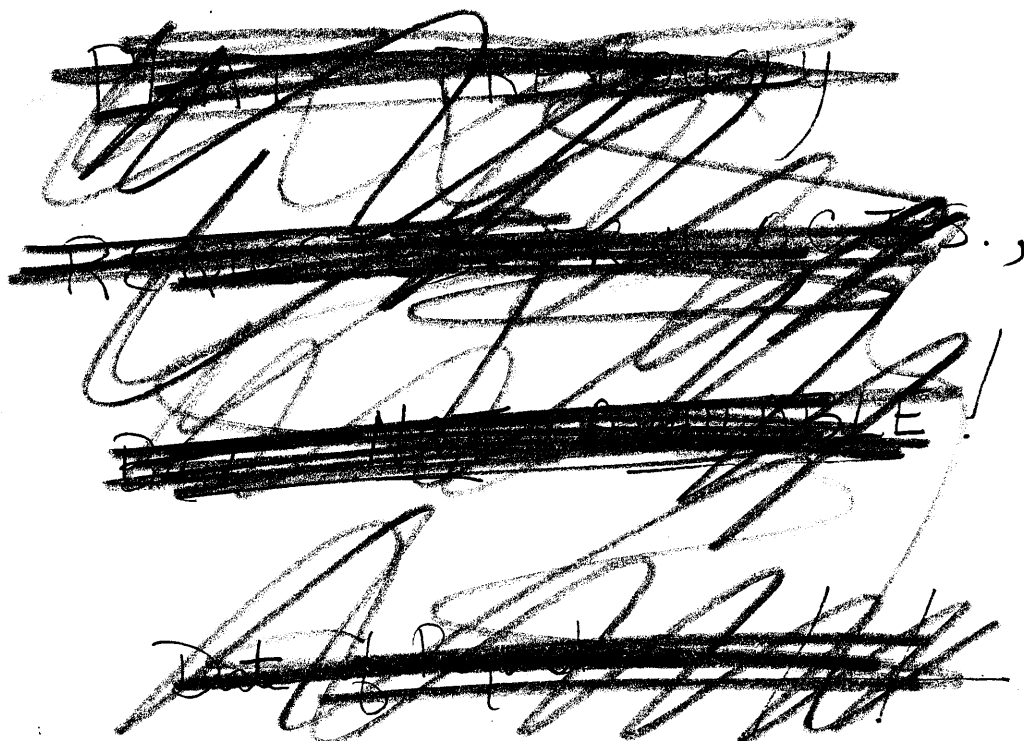

7.5 OGIS topo location

7.5' loc	<u>0.54S</u>	15' loc	<u>0.54S</u>
	<u>1.41W</u>	(calc.)	<u>1.41W</u>

Company _____

Farm _____

Topo Elev. 1130' - Kla 1/24/92

Quad West Union - 15' SC

County _____

District Centerville

WELL LOCATION MAP

File No. Tyler 9

WAIN SPRING NO. 4 WELL.

Centerville District, Tyler County, W. Va.

By Clifton Oil & Gas Co.,

On 278 acres.

Elevation, 1130' (b. T 1/24/92)

TYL-9

Big contractor, John Craig.

Drilling commenced Jan. 28, 1931; completed May 18, 1931.

10" casing, 702' (pulled); 8 1/2", 1206'; 6 3/4", 1927'.

Gas well. 16/10 Water in 2" opening = 190 M., cu. ft.

Record in Eastern Petroleum Co. Well Record book of Clifton Oil & Gas Co.

	Top.	Bottom.
Sand	25	- 125
Coal	220	- 221
Gasletown (?) Coal	430	- 431
Pittsburgh Coal	689	- 690
Red.....	865	- 1034
Little Bunkard Sand	1064	- 1080
Big Bunkard Sand	1193	- 1235
First Salt Sand	1387	- 1446
Second Salt Sand (water at 1500', 4 bailers per hour) ^{1st}	1455	- 1570
3rd Salt Sand	1665	- 1779
Shell	1785	- 1840
Black rock	1845	- 1870
Little Lime	1908	- 1919
Pencil Cave	1919	- 1922
Big Lime (oil at 1950-1955')	1922	- 1993
Big Injun Sand (gas, 1999-2003') (first pay, 2015-2020') (second pay, 2076-2087')	1993	- 2100
Total depth		2106 1/2

WR-38
DATE: April 6, 2001

API # ~~47-035-1172~~
47-099-0009

STATE OF WEST VIRGINIA
DIVISION OF ENVIRONMENTAL PROTECTION
OFFICE OF OIL AND GAS
AFFIDAVIT OF PLUGGING AND FILLING WELL

AFFIDAVIT SHOULD BE IN TRIPLICATE, one copy mailed to the Division, one copy to be retained by the Well Operator and the third copy (and extra copies if required) should be mailed to each coal operator/owner at their respective addresses.

FARM NAME: Cain heirs OPERATOR WELL NO: Cain heirs #4
LOCATION: Elevation: 1030' Quadrangle: West Union
District: Centerville County: Tyler
Latitude: _____ Feet South of _____ Deg _____ Min _____ Sec
Longitude: _____ Feet West of _____ Deg _____ Min _____ Sec

Well Type: Oil _____ Gas X

Company: PEAKE ENERGY, INC.
PO BOX 8
Ravenswood, WV 26164


Coal Operator NONE
or Owner _____

Agent: Thomas S. Liberatore

Coal Operator NONE
or Owner _____

PERMIT ISSUED DATE: 01/23/01

AFFIDAVIT

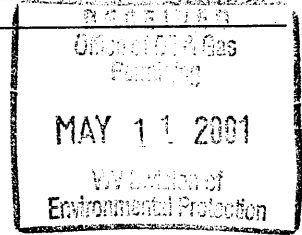

STATE OF WEST VIRGINIA,
COUNTY OF JACKSON

JON ULLOM and MIKE WINE being first duly sworn according to law depose and say that they are experienced in the work of plugging and filling oil and gas wells and were employed by the above named well operator, and participated in the work of plugging and filling the above well, and Mike Underwood Oil and Gas Inspector representing the director, say that said work was commenced on the 26TH day of March 2001, and that the well was plugged and filled in the following manner:

TYPE	FROM	TO	PIPE REMOVED	LEFT
Cement (Class A)	1975'	1875'	1961' of 5-1/2"	0
Cement (Class A)	1497'	1397'	NONE*	
Cement (Class A)	980'	880'	700* of 7"	1207'
Cement (Class A)	698'	598'	0 of 8-5/8"	1206'
Cement (Class A)	445'	395'		
Cement (Class A)	99'	Surface		

Perforated 8-5/8" casing 4 holes 689' 4 holes 430'
Plugging procedures ok'd by Mike Underwood prior to completion
Description of Monument: 4' of 7" casing above ground level with API #
and that the work of plugging and filling said well was completed on the 4th day of April, 2001.
And further deponents saith not.

Jon Ullom _____ Mike Wine _____

Sworn and subscribed before me this 8th day of May, 2001.
My commission expires: August 5, 2005

May 8 Merritt
Notary Public

Oil and Gas Inspector: _____

MAY 18 2001