

LATITUDE 392730

030625
75'10"

05 08

LONGITUDE

7'5 OGIS topo location

7.5' 10c	<u>0.38S</u>	15' 10c	<u>3.26S</u>
	<u>1.56W</u>	(calc.)	<u>1.56W</u>

Company _____

Farm _____

Quad Shirley West Union NC

County _____

District Ellsworth

WELL LOCATION MAP

File No. Tyler 30



471

STATE OF WEST VIRGINIA
DEPARTMENT OF MINES
OIL AND GAS DIVISION

WELL RECORD

Permit No. TYL-30

Oil or Gas Well Oil Well
(KIND)

Company American Oil Development Co.,
 Address Sisteraville, W. Va.
 Farm E. Reppard & R. Pierpoint Acres 129.90
 Location (waters) Middle Island Creek
 Well No. I (Farm Line Well) Elev 1163.00
 District Ellsworth County Tyler
 The surface of tract is owned in fee by E. Reppard and R. Pierpoint Address Middlebourne, W. Va.
 Mineral rights are owned by Same Address _____
 Drilling commenced June 14, 1935
 Drilling completed July 11, 1935
 Date Shot _____ From _____ To _____
 With _____
 Open Flow _____ /10ths Water in _____ Inch
 _____ /10ths Merc. in _____ Inch
 Volume _____ Cu. Ft.
 Rock Pressure _____ lbs. _____ hrs.
 Oil _____ bbls., 1st 24 hrs.
 Fresh water _____ feet _____ feet
 Salt water _____ feet _____ feet

Casing and Tubing	Used in Drilling	Left in Well	Packers
Size			
16			Kind of Packer _____
13			
10	I88	I88	Size of _____
8 1/4	I283		
6 1/2	2046	2046	Depth set _____
5 3/16			
3			Perf. top _____
2			Perf. bottom _____
Liners Used			Perf. top _____
			Perf. bottom _____


CASING CEMENTED _____ SIZE _____ No. Ft. _____ Date _____

COAL WAS ENCOUNTERED AT **856** FEET **24** INCHES

_____ FEET _____ INCHES _____ FEET _____ INCHES

_____ FEET _____ INCHES _____ FEET _____ INCHES

Formation	Color	Hard or Soft	Top	Bottom	Oil, Gas or Water	Depth Found	Remarks
Pitts. Coal			856	858			
Big Dunkard			1305	1320			
1st Salt Sand			1458	1470			
2nd Salt Sand			1640	1752			
3rd Salt Sand			1755	1900			
Maxton Sand			1985	1995			
Lime (Little)			1995	2015			
Pencil Cave			2015	2028			
Big Lime			2028	2111			
Big Injun Sand			2111		Gas	2134 1/8	
					Gas	2167	
					Oil	2169	
Total Depth			2179 1/8				

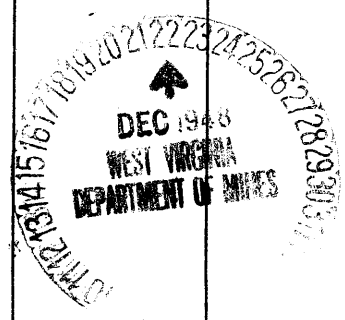

Formation	Color	Hard or Soft	Top	Bottom	Oil, Gas or Water	Depth Found	Remarks

Date December 20th, 1948, 19

APPROVED American Oil Development Co., Owner

By Halter N. Blay Sup't.
(Title)