


LATITUDE

39°25'

05 08 50

LONGITUDE

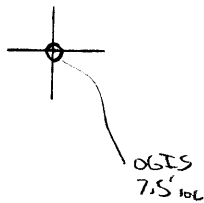

7.5 OGIS topo location

7.5' 10c	<u>1.62 S</u>	15' 10c	<u>1.62 S</u>
	<u>1.20 W</u>	(calc.)	<u>1.20 W</u>

Company MR Phillips (O&P base obs val)

Farm: _____

Quad Shirley (West Union, G)


County Tyler

District Centerville

WELL LOCATION MAP

File No. 095-44

This plat represents 117 1/2^a of land
 in Centerville Dist, Tyler Co wva
 a Leasehold of the
 company scale 1" = 40 rods

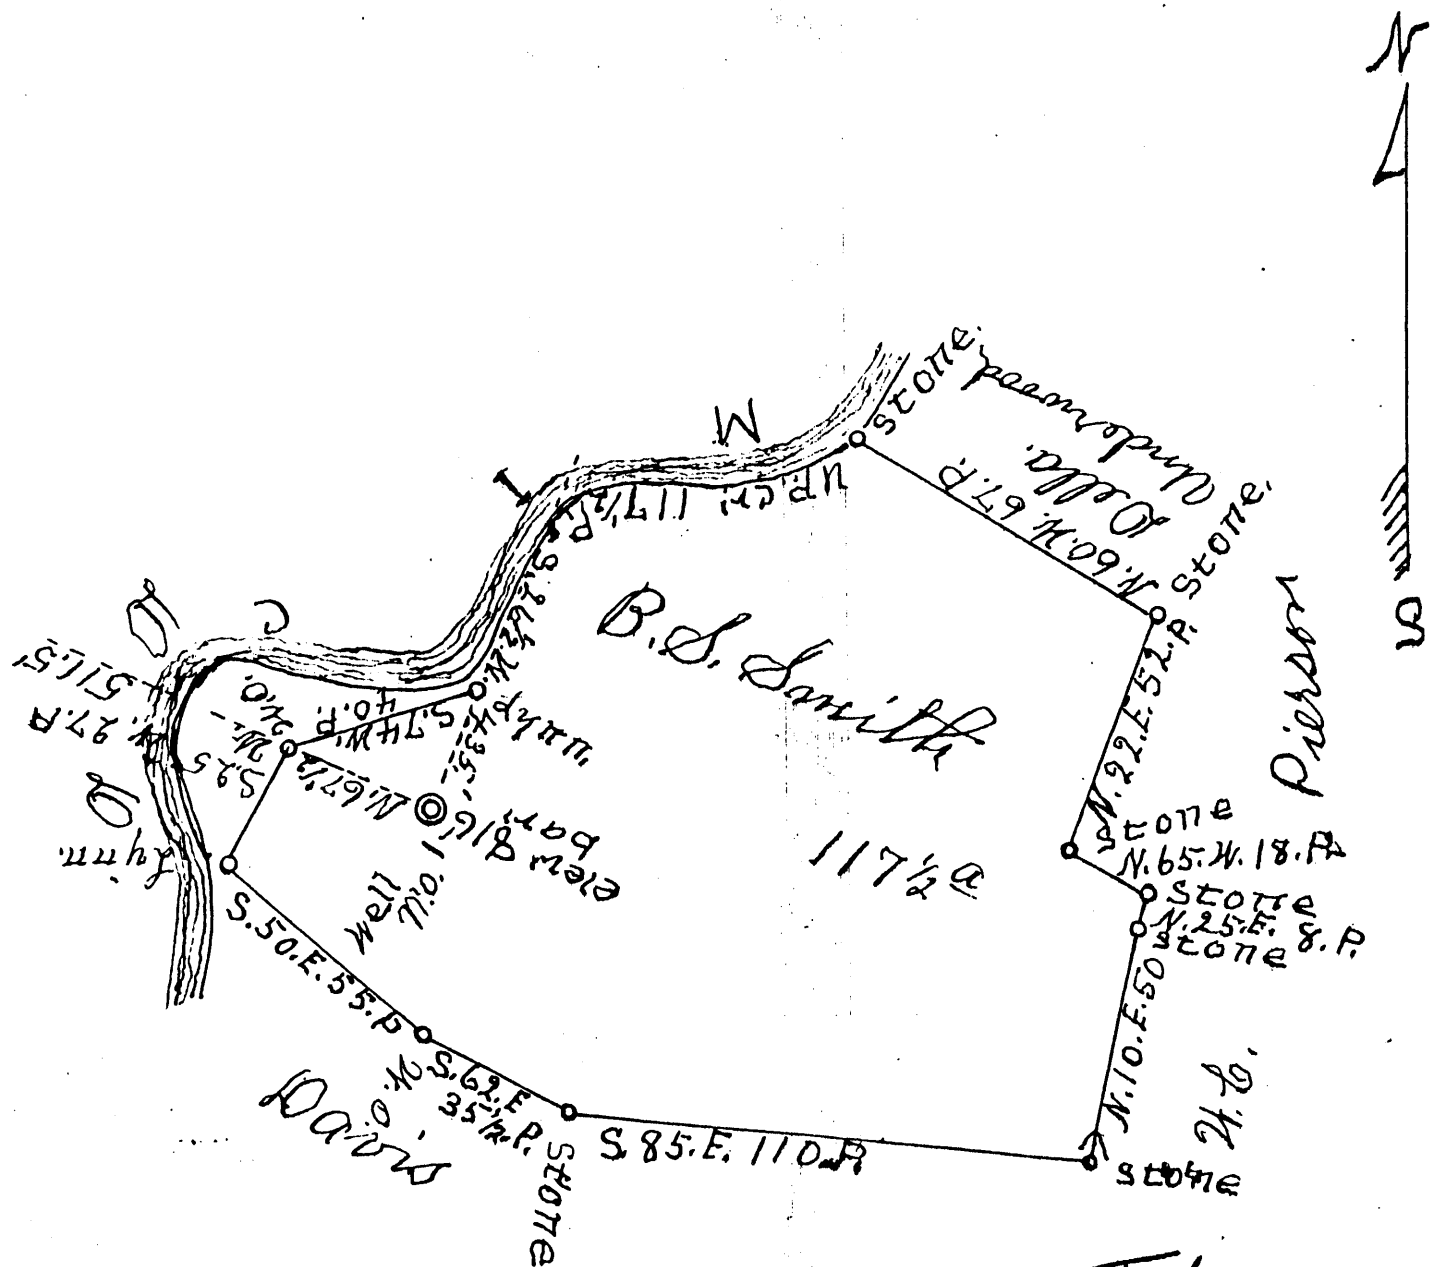

Ty-44

I hereby certify that the above plat
 is correct to the best of my skill
 and judgment and contains all the
 information required by the state
 bureau of mines for a permit to
 operate said farm. J.S. Haught / Engineer

Subscribed and sworn to before me this the 19th day of August 1935

My Commission Expires
 June 10th, 1945

[Signature]
 Notary Public