


LATITUDE 39° 25'

30° 25' 00"

LONGITUDE

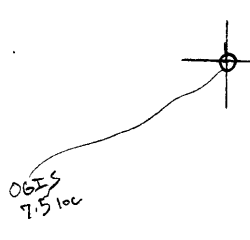

7.5 OGIS topo location

7.5' loc	<u>1.90 S</u>	15' loc	<u>1.90 S</u>
	<u>0.13 W</u>	(calc.)	<u>2.36 W</u>

Company _____

Farm _____

Quad Middlebourne ^{75'} (West Union)

County Tyler C

District Centerville


WELL LOCATION MAP

File No. 095-48

no well record

Latitude 39° 25'

Longitude 80° 50'

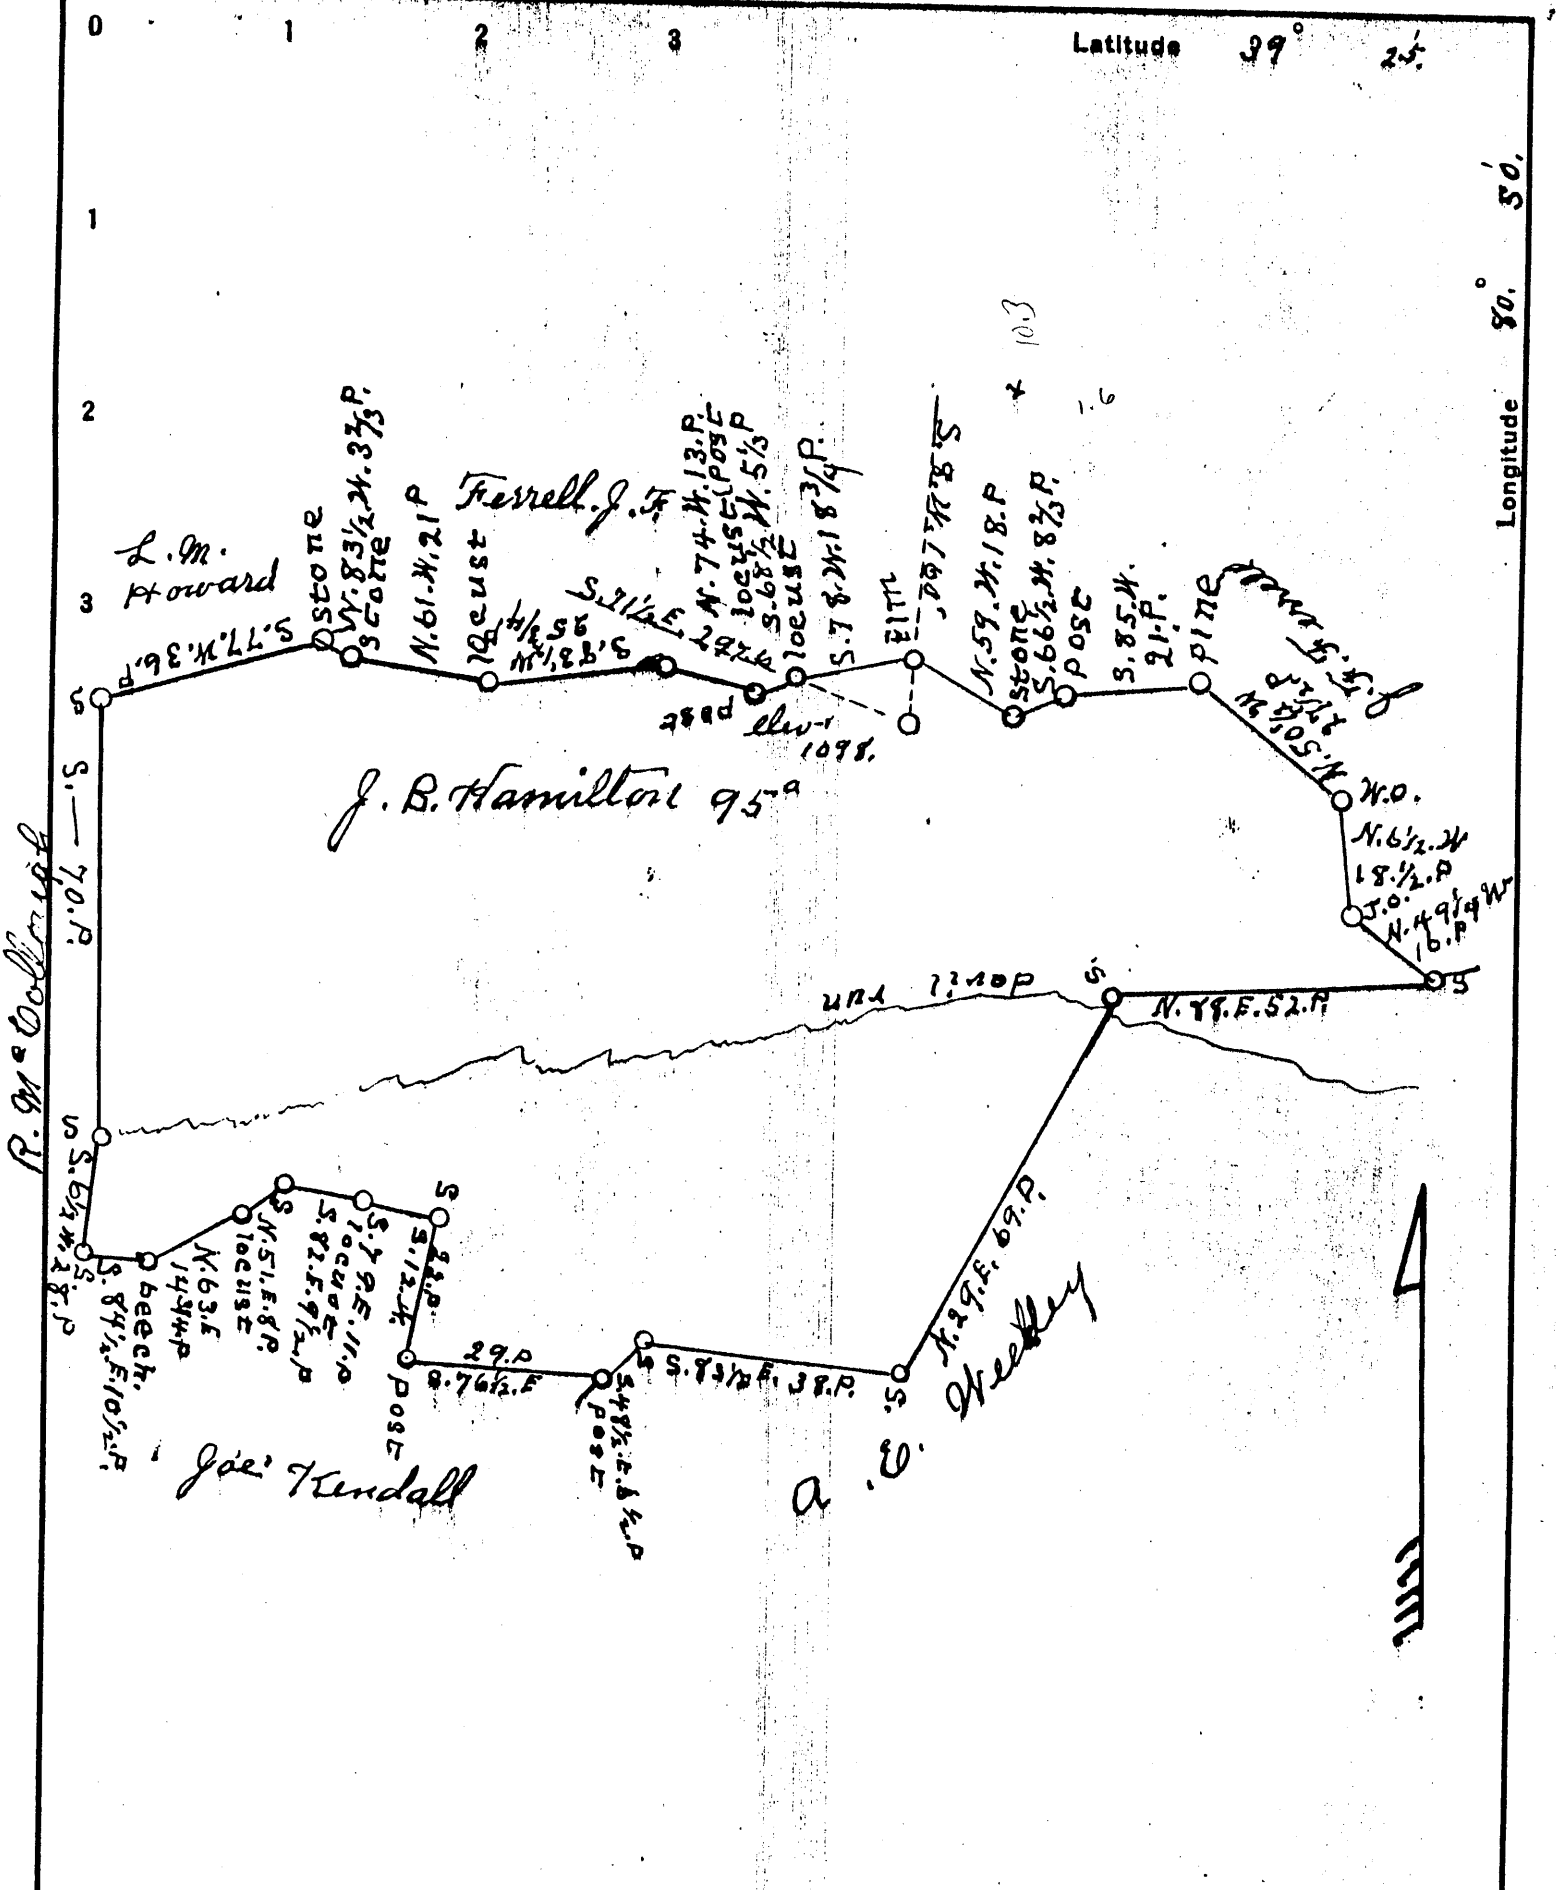

Company M. R. Phillips
 Address Blacksville W. Va
 Farm J. B. Hamilton
 Tract 95 Acres _____ Lease No. _____
 Well (Farm) No. 1 Serial No. _____
 Quadrangle Chest Union Cuv
 County Taylor
 District Centerville
 Engineer J. S. Haught
 Engineer's Registration No. Surv T. C.
 File No. _____ Drawing No. _____
 Date 6-6-36 Scale 1" = 30 fms

STATE OF WEST VIRGINIA
 DEPARTMENT OF MINES
 OIL AND GAS DIVISION
 CHARLESTON

WELL LOCATION MAP

FILE NO. TYL-48

No Well Record

+ Denotes location of well on United States Topographic Maps, scale 1 to 62,500, latitude and longitude lines being represented by border lines as shown.

- Denotes one inch spaces on border line of original tracing.

DRILLER'S RECORD

Previously Requested, but NOT
AVAILABLE

DATE: 3-2-92

095
COUNTY

48
PERMIT