


MA

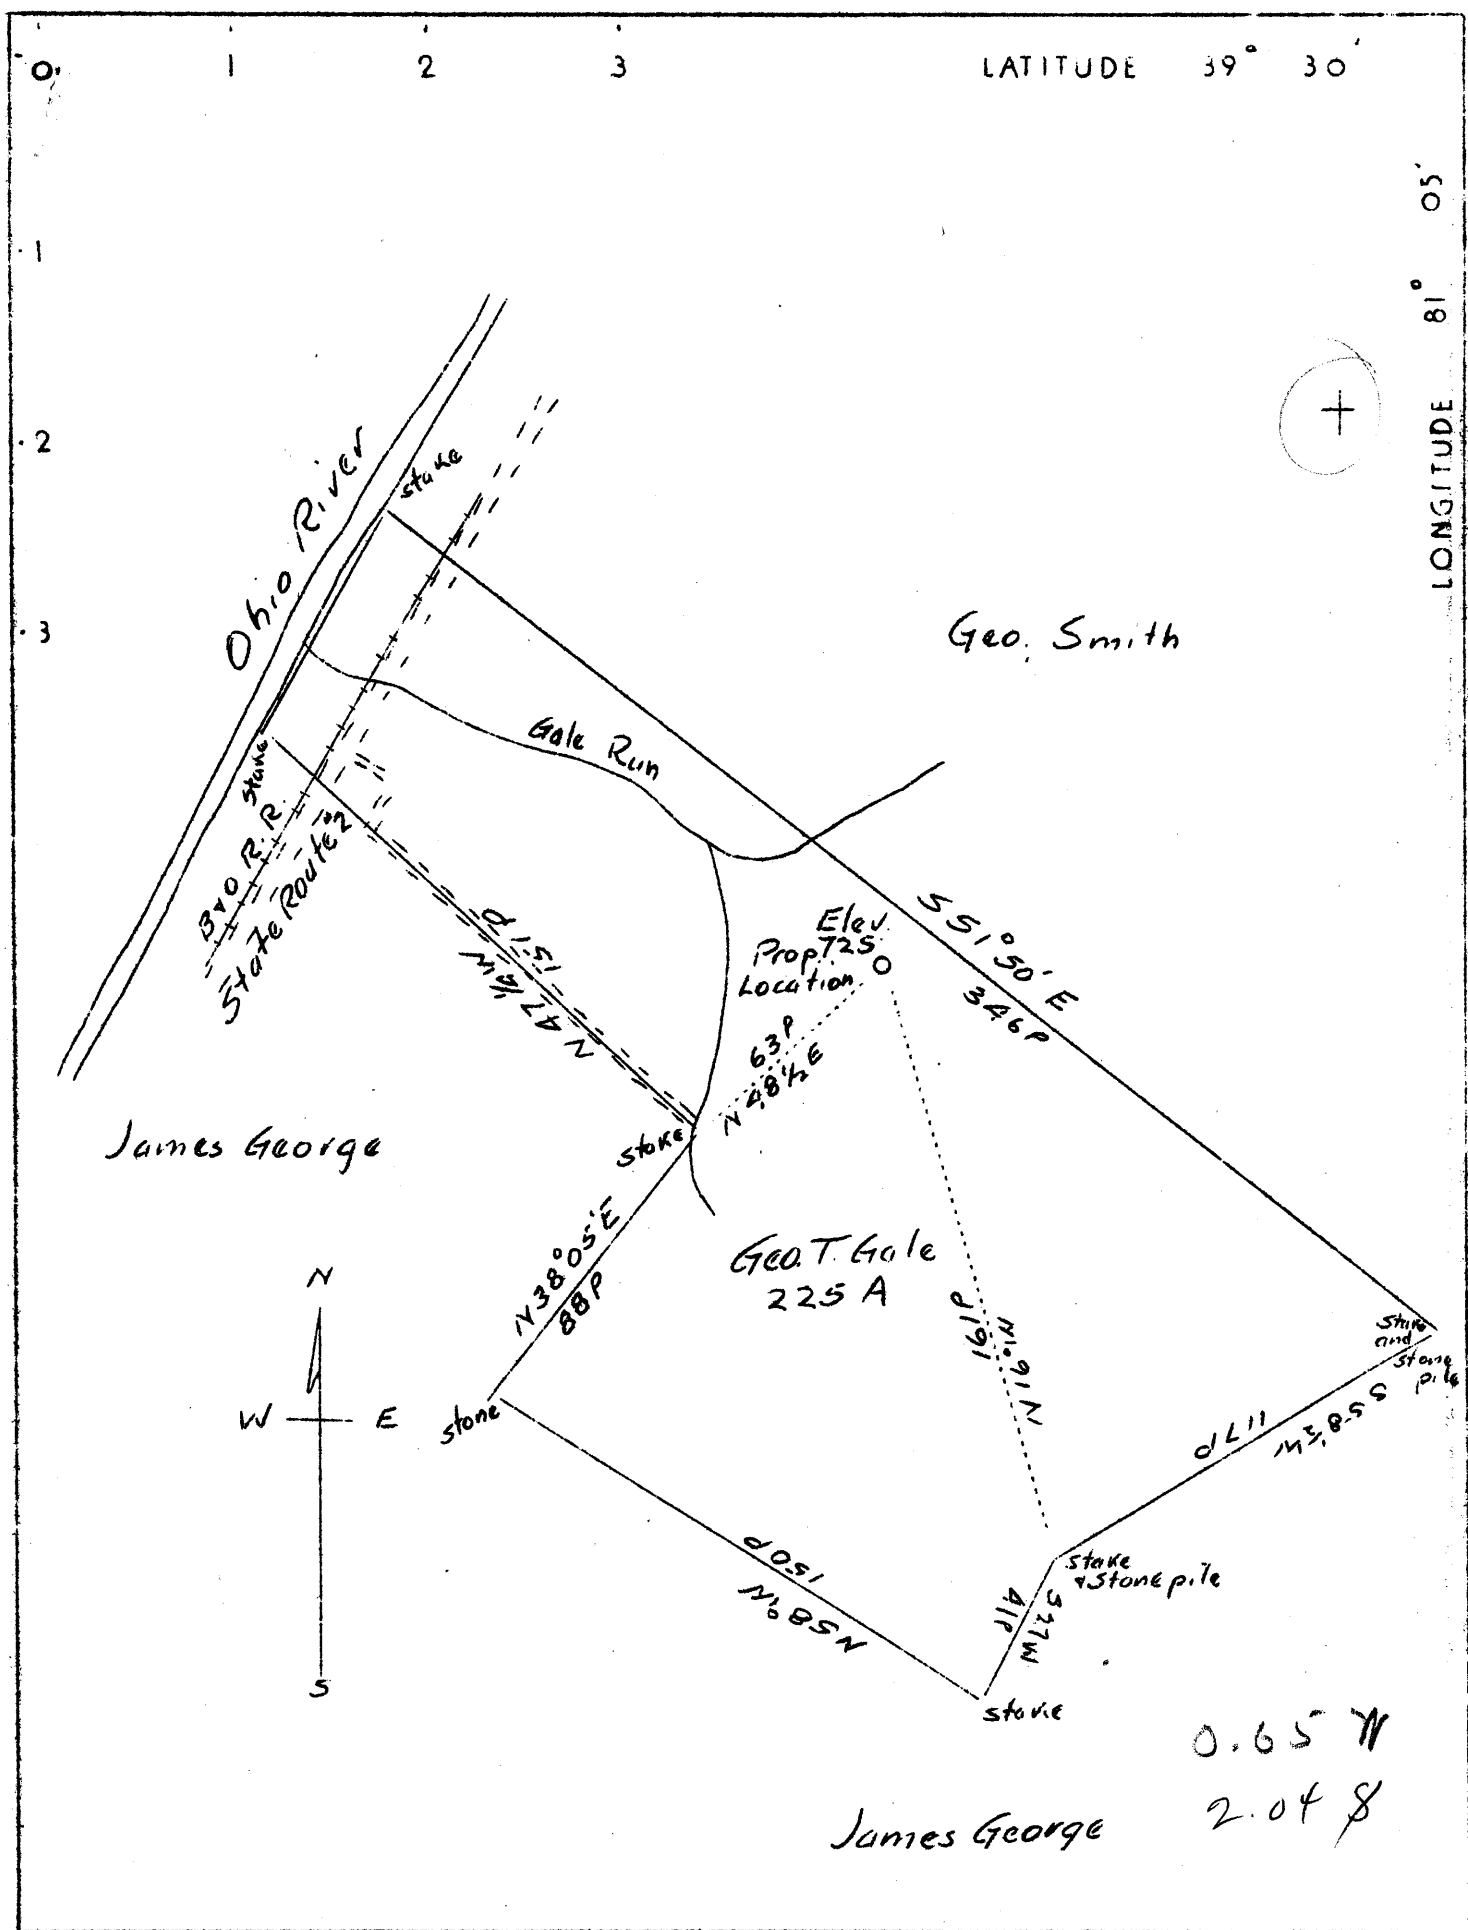

Company Gale Oil Co.
 Address Newport, Ohio
 Farm Geo. T. Gale
 Tract Acres 225 Lease No. _____
 Serial No. 19 Well (Farm) No. 19
 Elevation (Spirit Level) 725'
 Quadrangle St. Marys (A.L.)
 County Tyler District Union
 Engineer Jno. Triplett
 Engineer's Registration No. _____
 File No. _____ Drawing No. _____
 Date 9-1-36 Scale 50 p. to 1"

STATE OF WEST VIRGINIA
 Department of Mines
 OIL AND GAS DIVISION
 Charleston

WELL LOCATION MAP
 File No. TYL-67

+ Denotes location of well on U. S. Topographic Maps, scale 1 to 62,500 latitude and longitude lines being represented by border lines as shown

— Denotes one inch spaces on border line of original tracing.

