


LATITUDE 39° 30'

LONGITUDE 81° 50'

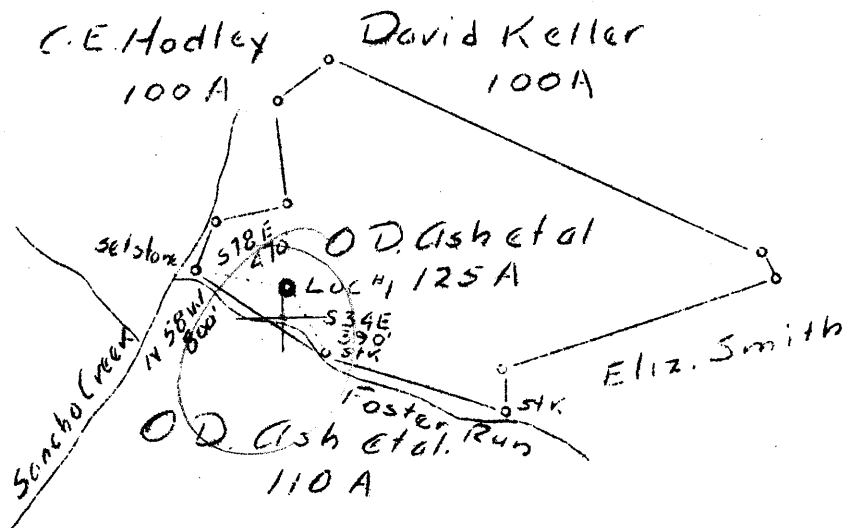

A. 15 W
A. 15 S

~~0.25 W~~
~~0.25 S~~

Clear with dist.

Company Thomas M. King, Trustee
 Address 730 12th St., Huntington, W. Va.
 Farm O. D. Ash et als
 Tract 1 Acres 125 Lease No. _____
 Well (Farm) No. 1 Serial No. _____
 Elevation (Spirit Level) 725.00'
 Quadrangle West Union nc
 County Tyler District load
 Engineer C. E. Krebs
 Engineer's Registration No. 9
 File No. 11,435 Scale 1" - 1000'
 Date 3-16-37 Drawing No. _____

STATE OF WEST VIRGINIA
 Department of Mines
 OIL AND GAS DIVISION
 Charleston

W E L L L O C A T I O N M A P

File No. TVL-69

+ Denotes location of well on U. S. Topographic Maps, scale 1 to 62,500 latitude and longitude lines being represented by border lines as shown.

— Denotes one inch spaces on border line of original tracing.

WEST VIRGINIA DEPARTMENT OF MINES

OIL AND GAS DIVISION

Permit No. Tyl-69

W E L L R E C O R D

Gas Well

West Union Quad.

Company - Thos. M. King, Trustee
 Address - 730 12th St. West, Huntington, W. Va.
 Farm - O. D. Ash et al. Acres-125
 Location - Little Sancho Creek
 Well No. - Ono. Elev. 725.00'
 District - ~~Meade~~ County- Tyler
 Surface & Mineral - O. D. Ash et al Middlebourne, W. Va.
 Drilling - Commenced- 4-5-37
 Completed- 4-30-37
 Date Shot - Not shot
 Open Flow - 213,120 cu. ft.
 Rock Press.- 430 lbs. 15 hrs
 Oil -
 Fresh Water- 55 feet
 Salt Water -

CASING & TUBING

8 1/4 190
 6-5/8 910
 2 1107

PACKER

Kind - Gas Anchor
 Size - 2 x 6-5/8
 16" rubber
 Depth- 1067'
 Perf. Top- 1098
 Perf. Bot- 1101

Coal was encountered at 110'10"; 368'
 395'; 440'

Formation Color ^{Hor} TOP Bottom Result					Formation Color ^{Hor} TOP Bottom Result				
Alluvial				8					
Shale & Shells		H	8	50					
Sand	Gray	S	50	75	Water 55	Sulphur			
Shale	Red	S	75	100					
Shale	White	S	100	110					
Coal	Blossom		110	111					
Shale	White	S	111	127					
Shale	Red	S	127	160					
Shell- Lime		H	160	175					
Shale	Red	S	175	182					
Lime	Very	H	182	190					
Shale	White	S	190	205	8 1/4 casing	190			
Lime Shells		H	205	255					
Shale	White	S	255	320					
Shale	Red	S	320	330					
Shale	White	S	330	360					
Lime	Gray	H	360	368					
Coal, Blossom			368	370					
Lime	Gray	H	370	395					
Coal, Blossom			395	396					
Shale	Dark	S	396	440					
Coal	Slaty		440	442					
Lime	Gray	H	442	460					
Shale	Gray	S	460	490					
Shale	Red	S	490	530					
Shale	Dark	S	530	575					
Shale	Red	S	575	590					
Shale	Dark	S	590	690					
Sand	Gray Close		690	725	Cow Run				
Shale	Black	H	725	735					
Shale	Red	S	735	740					
Lime Shells	Gray	H	740	790					
Sand,	Gray	H	790	808	2nd cow run				
Shale	White	S	808	825					
Shale	Dark	S	825	835					
Shale	White	S	835	850					
Gas Sand	Gray	H	850	860					
Shale	Gray	H	860	875					
Lime	Gray	H	875	895					
Shale	Light	S	895	900	6-5/8 casing	910			
1st salt Sand	Gray	H	900	1043					
Shale	White	S	1043	1064					
2nd Salt Sand	Gray	H	1064	1072					
Sand	Gray close		1072	1086	Oil show	1072-1086			
Sand	Gray	H	1086	1089					
Sand	Gray		1089	1103	Gas	1089-1103			
Sand	Gray	H	1103	1105					
Total Depth (still in sand)				1105					