


LATITUDE

39° 30'

81° 2' 30"

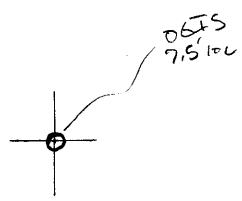

LONGITUDE

7.5 OGIS topo location

7.5' loc	<u>1.83 S</u>	15' loc	<u>1.83 S</u>
	<u>1.42 W</u>	(calc.)	<u>3.65 W</u>

Company _____

Farm _____


Quad Bens Run 7.5' (St Marys)

County Tyler NE

District Union

WELL LOCATION MAP

File No. 095-77

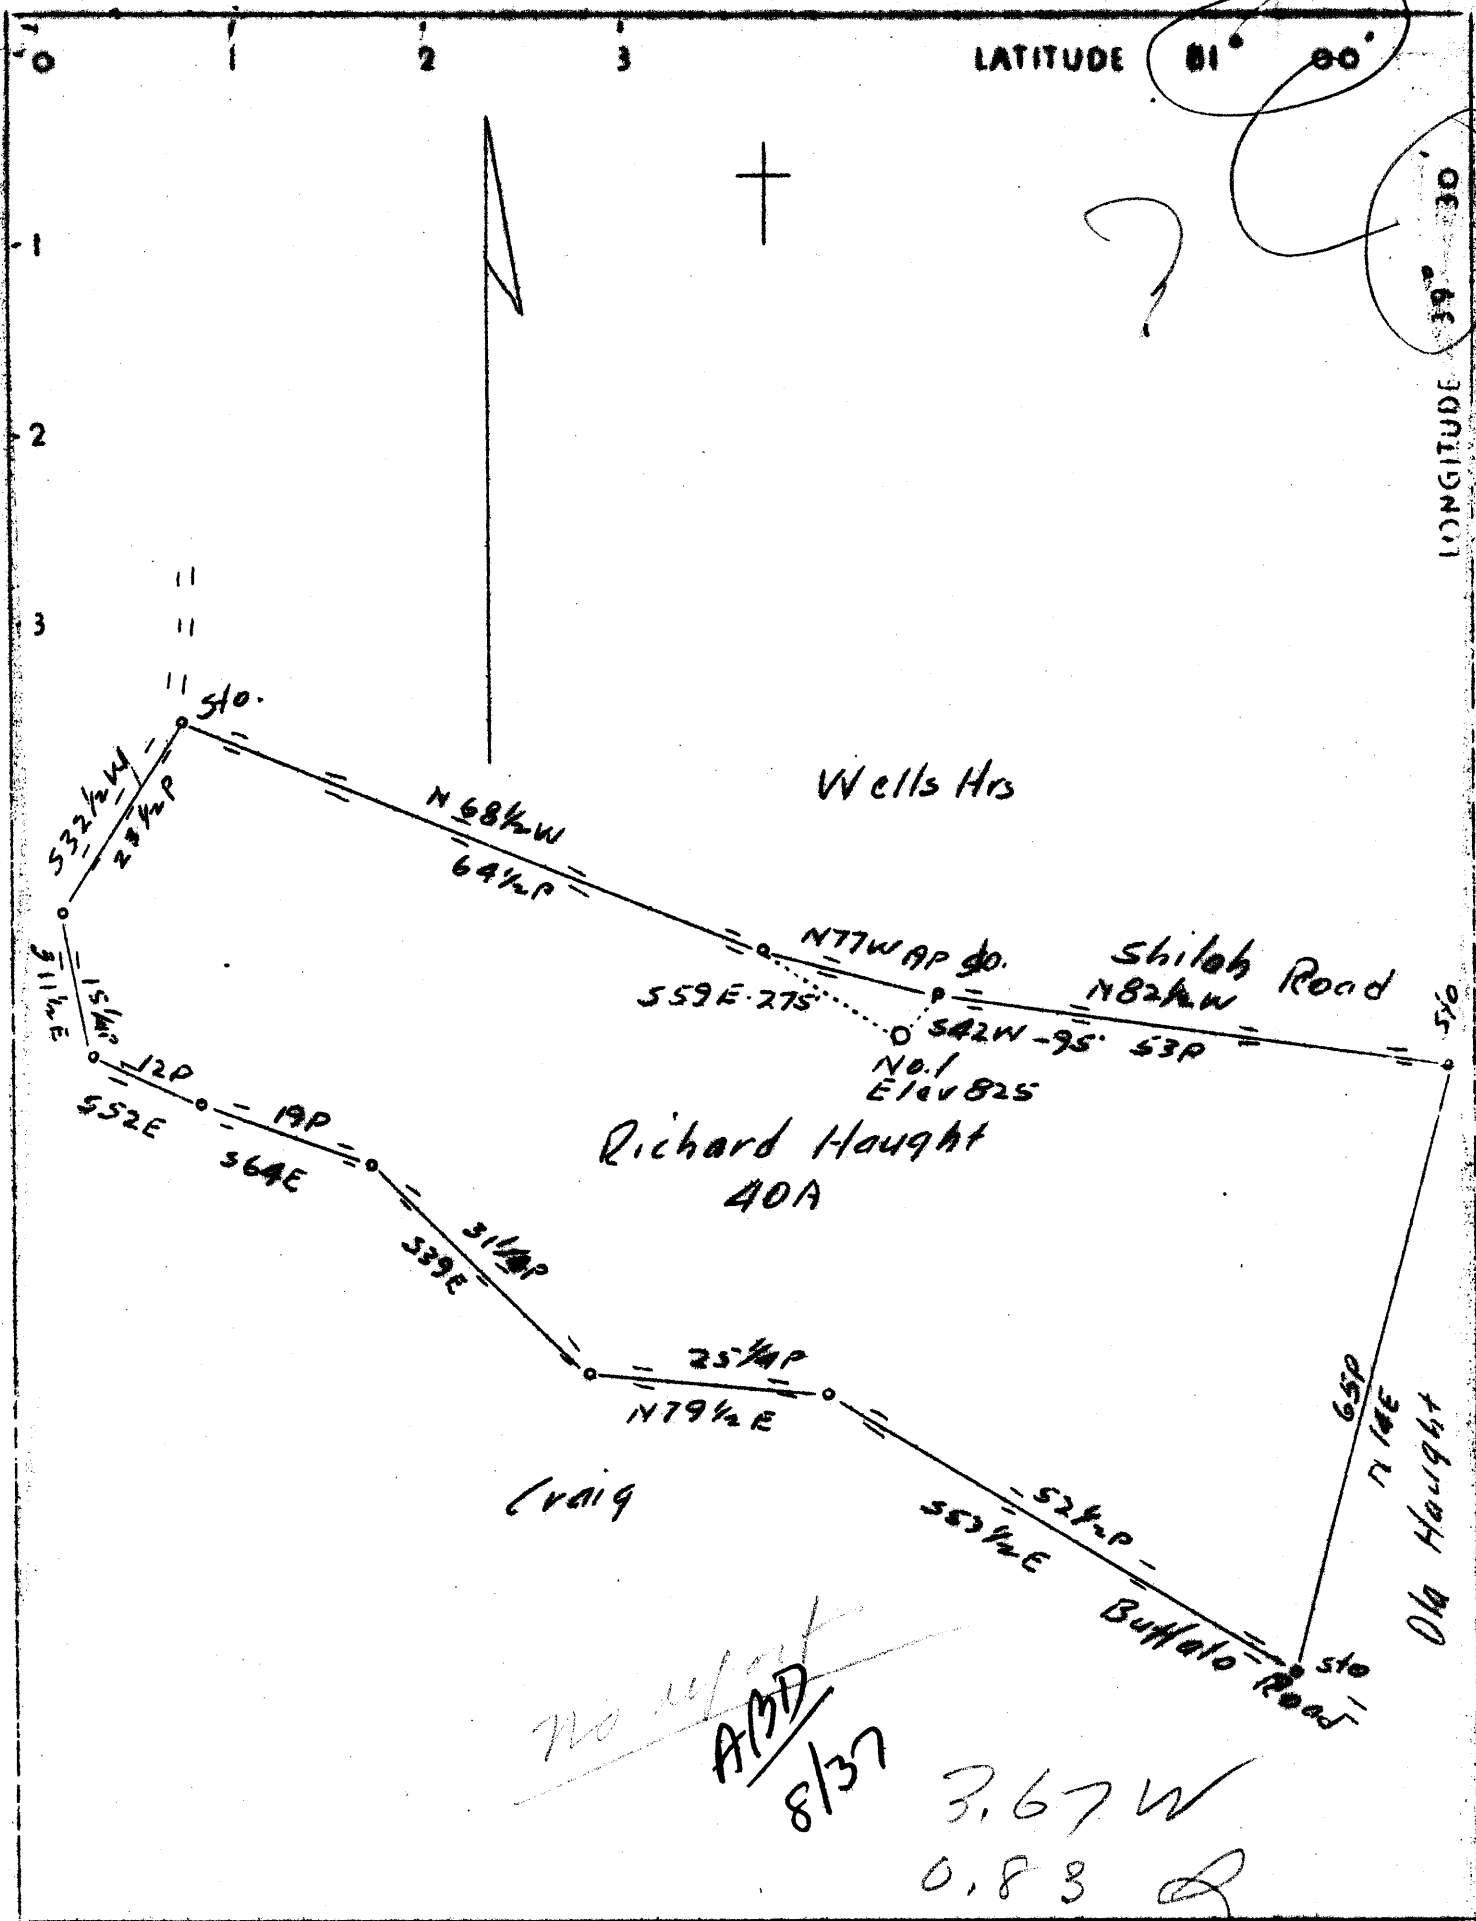

Company	L.C. White & Son
Address	Raven Rock, W. Va.
Farm	Richard Haught
Tract	1 Acres 40 Lease No. 1
Well (Farm) No.	1 Serial No.
Elevation	825
Quadrangle	St. Marys, W. Va. (N.E.)
County	Tyler District Union
Engineer	Parker E. Peters
Engineer's Registration No.	488
File No.	Drawing No.
Date	June 17, 1937 Scale 1"=20 Poles

STATE OF WEST VIRGINIA
 Department of Mines
 OIL AND GAS DIVISION
 CHARLESTON

WELL LOCATION MAP
 File No. TYL-77

NE + Denotes location of well on United States Topographic Maps, scale 1 to 62,500, latitude and longitude lines being represented by border lines as shown.

- Denotes one inch spaces on border line of original tracing.

WEST VIRGINIA DEPARTMENT OF MINES
OIL AND GAS DIVISION

WELL RECORD

Permit No. Ty 1-77

Oil or Gas Well Dry
(Kind)

Company <u>L.C. White and Son</u>	Casing and Tubing	Used in Drilling	Left in Well	Packers
Address <u>Raven Rock, W. Va.</u>	Size			
Farm <u>Richard Haught</u> Acres <u>40</u>	16			Kind of Packer
Location (waters)	18			
Well No. <u>One</u> Elev. <u>825</u>	10	<u>22ft.</u>		Size of
District <u>Union</u> County <u>Tyler</u>	8 1/4	<u>122</u>		Depth set
The surface of tract is owned in fee by <u>Richard Haught</u>	6 5/8	<u>854</u>		
<u>Paden City</u> Address <u>W. Va.</u>	5 3/16			Perf. top
Mineral rights are owned by <u>Same as Fee</u>	3			Perf. bottom
Address	2			Perf. top
Drilling commenced <u>July 10, 1937</u>	Liners Used			Perf. bottom
Drilling completed <u>August 11, 1937</u>				
Date shot <u>None</u> Depth of shot				
Open Flow /10ths Water in <u> </u> Inch				
/10ths Merc. in <u> </u> Inch				
Volume <u> </u> Cu. Ft.	CASING CEMENTED	SIZE	No. FT.	Date
Rock Pressure <u> </u> lbs. <u> </u> hrs.				
Oil <u> </u> bbls., 1st 24 hrs.	COAL WAS ENCOUNTERED AT	FEET	INCHES	
Fresh water <u> </u> feet <u> </u> feet		FEET	INCHES	FEET
Salt water <u>1255</u> feet <u>1235</u> feet		FEET	INCHES	FEET

Formation	Color	Hard or Soft	Top	Bottom	Oil Gas or Water	Depth Found	Remarks
		Fresh Water	15 ft.	100 ft.			
Big Red	Red	Soft	565	665			
Sand	Grey	Solid	1010	1060			
Shale	Black	" "	1060	1115			
Sand	Grey	" "	1115	1188			
Slate	Black	Soft	1188	1215			
Sand	Grey	Solid	1215	1292			
Shale	Black	Solid	1292	1325			
Sand	Grey	"	1325	1340			
Slate	Black	Soft	1340	1397			
Sand	Grey	Solid	1397	1485			
Maxon Sand	Grey	Solid	1515	1535			
Big Lime	Yellow	Hard	1594	1629			
Keener S.	Blue	Soft	1629	1660			
Slate	Black	Soft	1660	1673			
Big Injun	Mostly	Blue and Broken	1673	1845.			
Slate	1845	to 1865.					
Bottom hole	1865.						

