


John C. Ferrell

Albert Eastham

J. S. Roberts

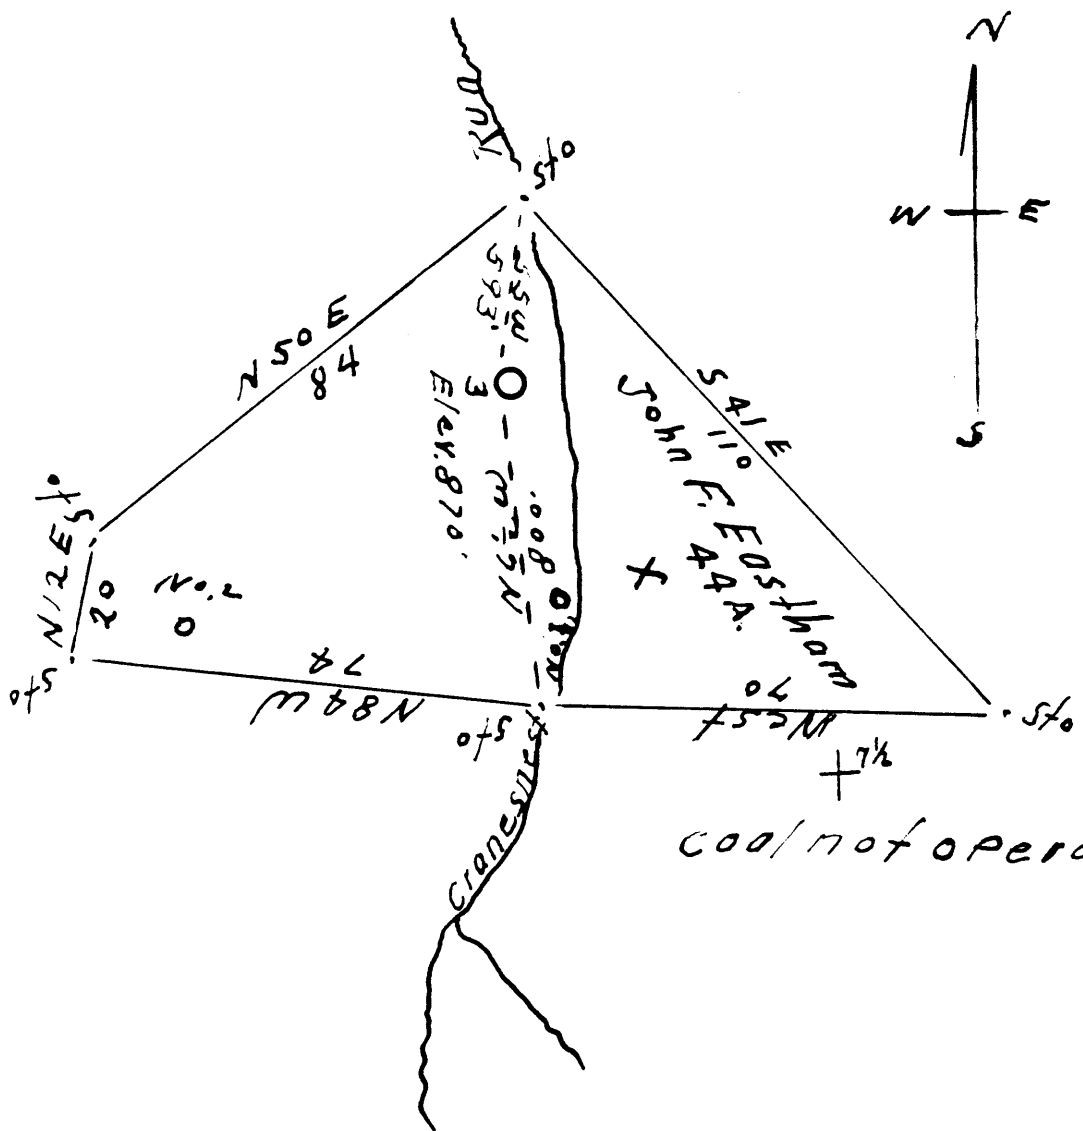

Nancy Ferrell Heirs

New Location   
 Drill Deeper   
 Abandonment  - 1/10/84

COMPANY Perkins Oil & Gas, Inc.  
 ADDRESS Rt. 2 - Pennsboro, W.Va. 26415  
 FARM John Eastham (Now: Dallas Huggins #3)

STATE OF WEST VIRGINIA  
 DEPARTMENT OF MINES  
 OIL AND GAS DIVISION  
 CHARLESTON

WELL LOCATION MAP  
 FILE NO. Ty1-144-P

Tract 1 Acres 44 Lease No. \_\_\_\_\_  
 Well (Farm) No. 3 Serial No. \_\_\_\_\_  
 Elevation (Spirit Level) 870'  
 Quadrangle New Martinsville  
 County Tyler District Elswoorth  
 Engineer J. M. Cochran  
 Engineer's Registration No. 60  
 File No. \_\_\_\_\_ Drawing No. H. H. Bell Co.  
 Date 8-1-1949 Scale 1" = 30' = 30' = 30'

+ Denotes location of well on United States Topographic Maps, scale 1 to 62,500, latitude and longitude lines being represented by border lines as shown.

- Denotes one inch spaces on border line of original tracing.

MAR 20 1950


Latitude 39 35

Longitude 80 08

John C. Ferrell

Albert Eastham

J. S. Roberts

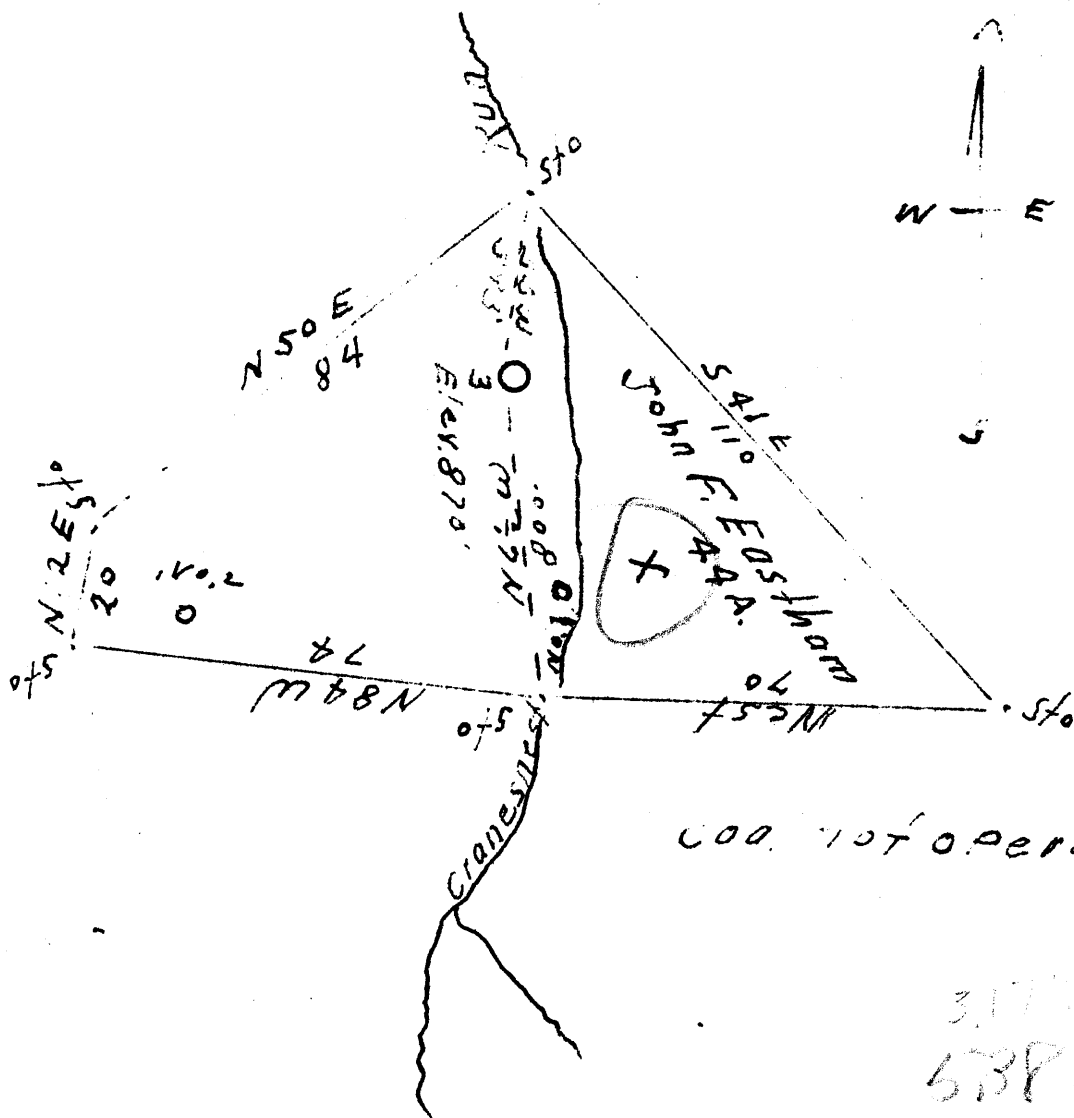

Nancy Ferrell Heirs

New Location X  
Drill Deeper  
Abandonment

Company Edgar Oil & Gas Co.  
 Address New Martinsville, W. Va.  
 Farm John F. Eastham  
 Tract 1 Acres 44 Lease No. \_\_\_\_\_  
 Well (Farm) No. 3 Serial No. \_\_\_\_\_  
 Elevation (Spirit Level) 870'  
 Quadrangle New Martinsville  
 County Tyler District Elsworth  
 Engineer J. M. Cochran  
 Engineer's Registration No. 60 Surveyor \_\_\_\_\_  
 File No. \_\_\_\_\_ Drawing No. Hitchell Co.  
 Date 8-1-1944 Scale 1" = 30 Feet

STATE OF WEST VIRGINIA  
DEPARTMENT OF MINES  
OIL AND GAS DIVISION  
CHARLESTON

WELL LOCATION MAP  
FILE NO. Tyl-144

+ Denotes location of well on United States Topographic Maps, scale 1 to 62,500, latitude and longitude lines being represented by border lines as shown.

- Denotes one inch spaces on border line of original tracing

JOHN P. EASTHAM NO. 3 WELL.

Ellsworth District, Tyler County, W. Va.  
 By Edger Oil & Gas Co., New Martinsville, W. Va.  
 Drilled under permit Tyl-24; New Martinsville Quadrangle.  
 On 44 acres, on Elk Fork. 144  
 Elevation, 870' L.  
 Surface owned by A. L. Eddy, Middlebourne, W. Va., and minerals by Fred Fiber, Middlebourne, W. Va. 144  
 Drilling commenced June 18, 1945; completed Sept. 13, 1945.  
 Open flow, 12/10ths.....  
 Volume, 25,000 cu. ft.  
 Oil, 1 bbl., 1st 24 hrs.  
 8" casing, 140' (pulled); 6", 1000' (200' left in); 5", 1767';  
 2" tubing, 1890'.  
 No coal was encountered.  
 Gas well. Record from Smith Jan. 29, 1946.

	Top.	Bottom.
All kind	0	885
✓ Little Dunkard Sand	885	900
Lime and shale	900	985
✓ Big Dunkard Sand	985	1025
Shale	1025	1050
Sand and shale	1050	1100
Sand	1100	1150
Lime and shale	1150	1250
Shale	1250	1350
✓ 1st Salt Sand	1350	1455
✓ 3rd Salt Sand	1455	1575
Sand and shale	1575	1666
✓ Norton Sand	1666	1736
✓ Big Lime	1736	1773
Sand and lime, (top of Keener, 1794')	1773	1794
✓ Keener Sand	1794	1850
✓ Sand (gas, 1875-1885') <i>cut</i>	1850	1875
✓ Sand	1885	1890
Oil sand	1890	1915
Sand (water)	1915	1935
Total depth		1936

1736  
 825  
 2825

WEST VIRGINIA DEPARTMENT OF MINES  
OIL & GAS DIVISION  
W E L L R E C O R D

Permit No. **Tyl-144**  
New Martinsville Quad.  
Company  
Address  
Farm  
Location  
Well No.  
District  
Surface  
Mineral  
Commenced  
Completed  
Open flow  
Volume  
Oil

Gas Well  
CASING & TUBING

Edgar Oil & Gas Co.  
New Martinsville, W.Va. 8 $\frac{1}{2}$  140 None  
Jno. F. Eastham Acres 6 5/8 1000 200  
Ellsworth Dis Elk Fork 5 3/16 1767 all  
3 Elev. -- 37 2 1890 all  
Ellsworth Tyler County  
A.L. Eddy, Middlebourne, W.Va. No coal  
Fred Fiber, Middlebourne, W.Va.  
June 18, 1945  
Sept. 13, 1945  
12.10ths  
25000 C.F.  
1 bbls. 1st 24 hrs.

All Kind	0	885
✓ Little Dunkard	885	900
Lime & Shale	900	985
✓ Big Dunkard	985	1025
Shale	1025	1050
Sand & Shale	1050	1100
Sand	1100	1150
Lime & Shale	1150	1200
Shale	1250	1350
✓ 1st Salt Sand	1350	1455
✓ 3rd Salt Sand	1455	1575
Sand & Shale	1575	1666
✓ Maxon Sand	1666	1736
✓ Big Lime	1736	1773
Sand & Lime Top of Koener 1794	1773	1794
✓ Keener Sand	1794	1850
✓ Sand BI	1850	1875
Gas	1875	1885
Sand	1885	1890
Oil Sand	1890	1915
Sand Water	1915	1935
Total Depth		1936

1736  
825  
826

18  
18

AFFIDAVIT OF PLUGGING AND FILLING WELL

AFFIDAVIT SHOULD BE MADE IN TRIPLICATE, one copy mailed to the Department, one copy to be retained by the Well Operator and the third copy (and extra copies if required) should be mailed to each coal operator at their respective addresses.

None  
Coal Operator or Owner

None  
Address

None  
Coal Operator or Owner

Address

Dallas Higgins  
Lease or Property Owner

111 Lebourne, WV  
Address

Perkins Oil and Gas, Inc.  
Name of Well Operator

St. 2, Lebourne, WV 26101  
Complete Address

1984  
WELL AND LOCATION

Illwaco District

Boyer County

WELL NO. 3

Dallas Higgins Farm

Robert Lowrey

STATE INSPECTOR SUPERVISING PLUGGING

AFFIDAVIT

STATE OF WEST VIRGINIA,  
County of Mitchell ss:

Donald Paul Kinney and Robert Lowrey

being first duly sworn according to law depose and say that they are experienced in the work of plugging and filling oil and gas wells and were employed by Perkins Oil and Gas, Inc., well operator, and participated in the work of plugging and filling the above well, that said work was commenced on the 15th day of April, 19 84, and that the well was plugged and filled in the following manner:

Sand or Zone Record Formation	Filling Material	Plugs Used Size & Kind	Casing	
			CSG PULLED	CSG LEFT IN
Line and band	Cement 10-17-18		1090	0
Inside pipe	Line 2 1/2" 1720-800		800	0
No record	Cement 800-700			
	Line 2 1/2" 700-150			
	Cement 150-2 1/2"			
	All plugs set with State inspectors approval.			
Coal Seams <u>None</u>			Description of Monument	
(Name)			10" steel conductor pipe	
(Name)			with a 7" steel pipe	
(Name)			cemented in.	
(Name)				

**RECEIVED**  
MAY 16 1984

OIL & GAS DIVISION  
DEPT. OF MINES

*[Handwritten signature]*

and that the work of plugging and filling said well was completed on the 15th day of April, 19 84.

And further deponents saith not.

Donald P. Kinney  
Robert Lowrey

Sworn to and subscribed before me this 11th day of May, 19 84.

Daryl L. Perkins  
Notary Public

My commission expires:  
April 10, 1994