


M

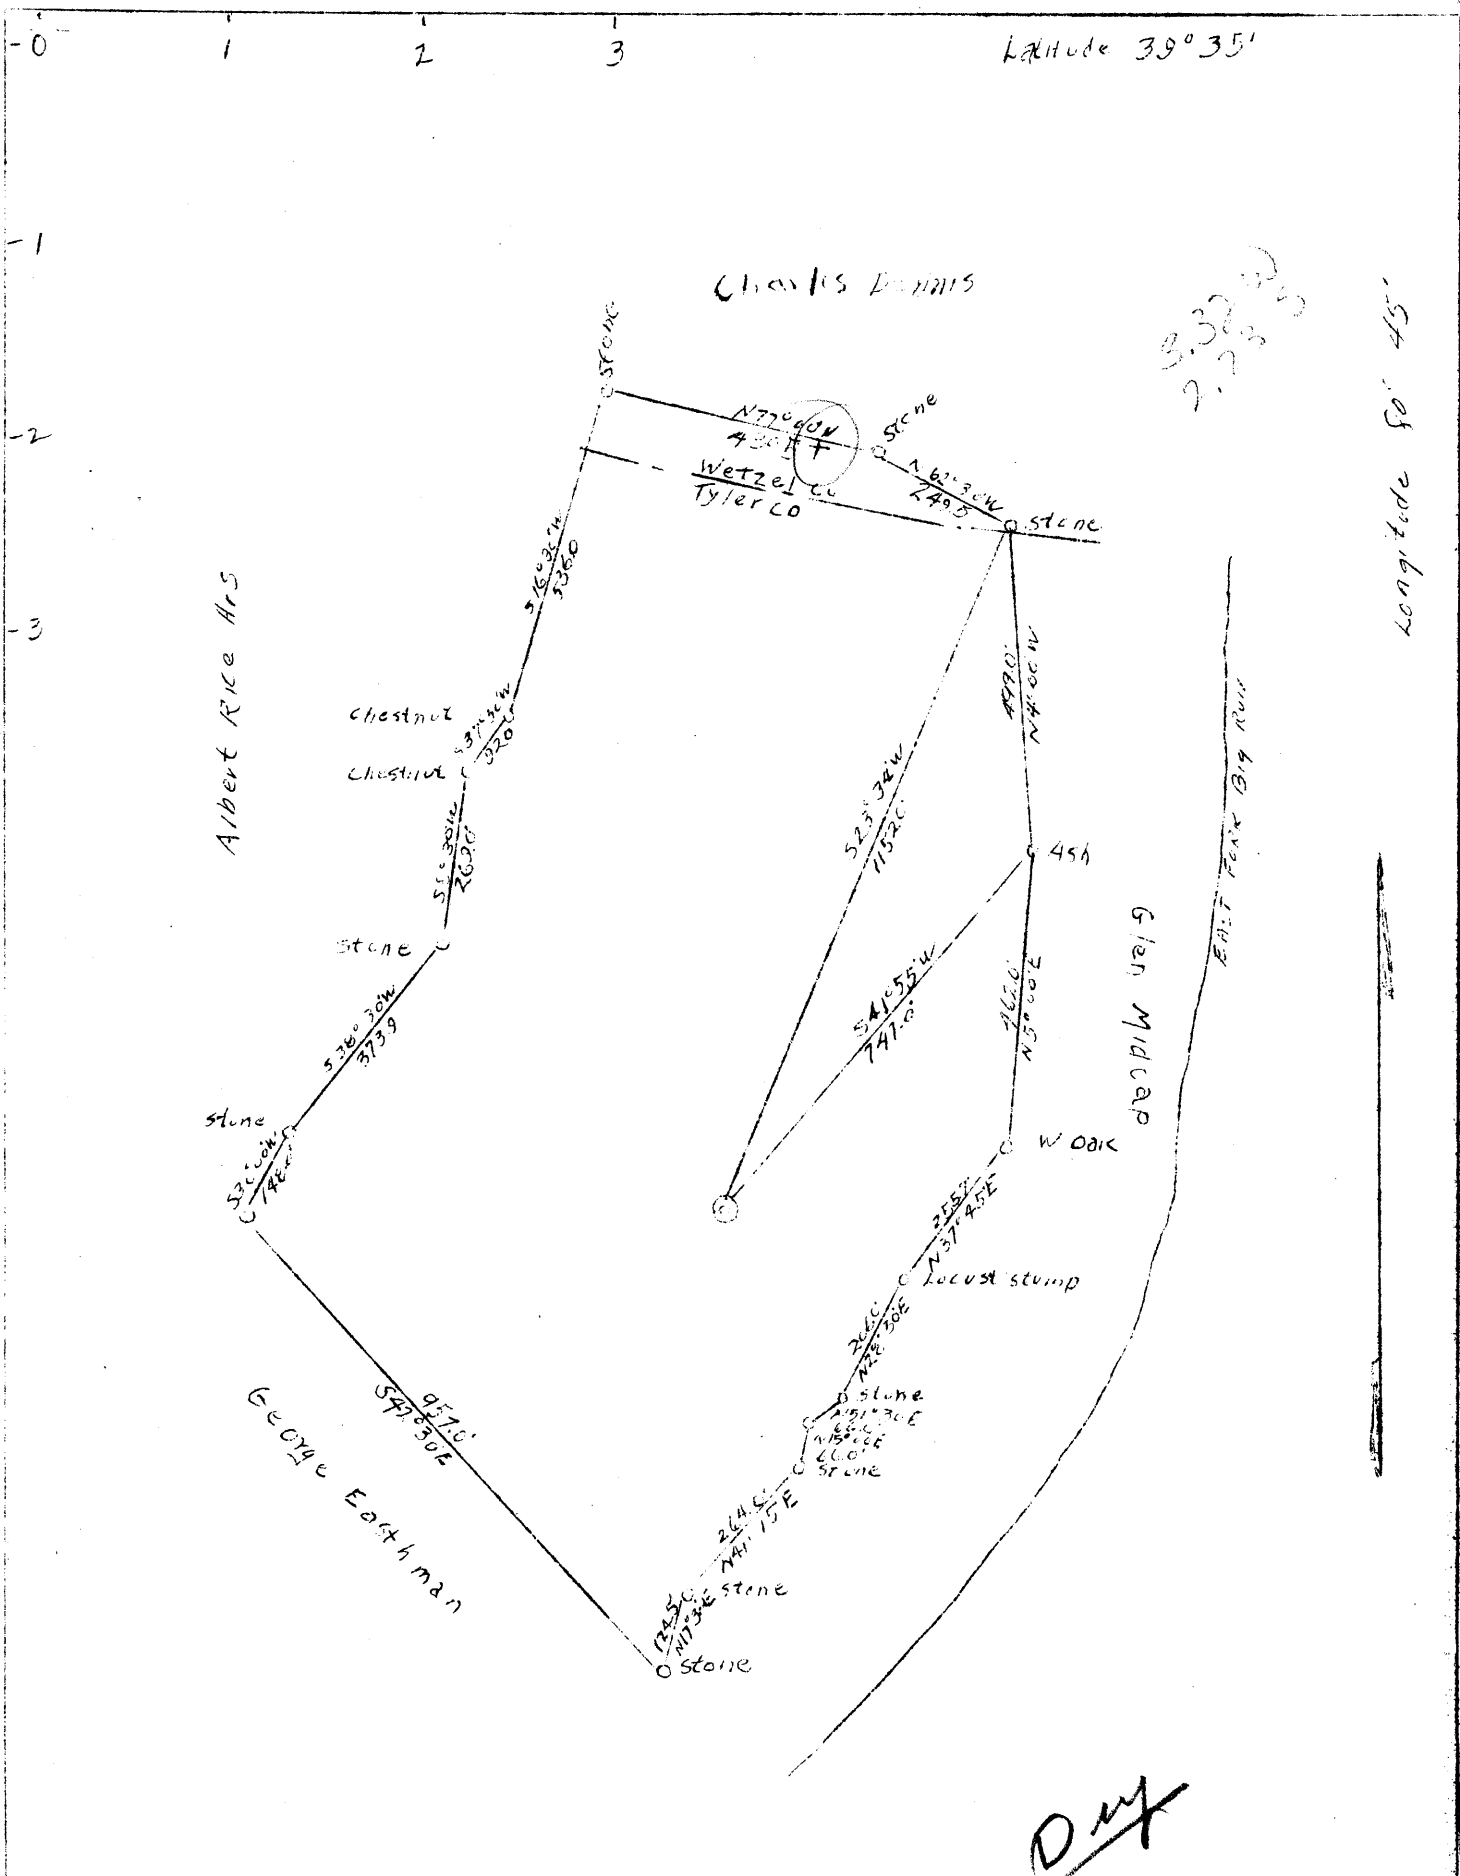

NEW LOCATION

COMPANY	METZ OIL CO.
ADDRESS	BOX 118 BEECH BOTTOM, W. VA.
FARM	WILEY MIDCAP
TRACT	ACRES 33 LEASE NO. ONE
WELL (FARM) NO.	ONE SERIAL NO.
ELEVATION (SP. LVL.)	1100'
QUADRANGLE	NEW MARTINSVILLE SE
COUNTY	TYLER DIST. ELLSWORTH
ENGINEER.	G. L. MC INTIRE
ENGINEER'S REG. NO.	1187
FILE NO.	DRAWING NO.
DATE	5/23/49 SCALE 1"=300'

STATE OF WEST VIRGINIA  
 DEPARTMENT OF MINES  
 OIL AND GAS DIVISION  
 CHARLESTON

WELL LOCATION MAP  
 FILE NO. TYL - 165

+ DENOTES LOCATION OF WELL ON U.S. TOPOGRAPHIC MAPS, SCALE 1 TO 62,500, LATITUDE AND LONGITUDE LINES BEING REPRESENTED BY BORDER LINES AS SHOWN.

→ DENOTES ONE INCH SPACES ON BORDER LINE OF ORIGINAL TRACING.

6-6 30

WEST VIRGINIA DEPARTMENT OF MINES  
OIL & GAS DIVISION  
W E L L R E C O R D

Permit No. Tyl 165  
New Martinsville Quad.  
Company  
Address  
Farm  
Location  
Well No.  
District  
Surface  
Mineral  
Commenced  
Completed  
Water

Metz Oil Company  
Henry Metz, 113 Baech Bottom, W.Va.  
Wiley Midcap Acres 33  
1 Elev. 1100'  
Ellsworth Tyler County

Gas Well  
CASING & TUBING

	10	180	180
	8 $\frac{1}{2}$	840	840
	6 5/8	1240	1240
		Coal at 580'	1"
		815'	1"

Aug. 10, 1949  
Sept. 20, 1949  
70' ; 710' ; 2065'

Soil	Y	S	0	12
Red Rock		S	12	22
Sand	Wh	S	30	52
Red Rock		S	52	72
Slate	Wh	S	72	130
Red Rock		S	130	160
Slate	Dk	S	160	220
Red Rock		S	220	280
Lime	Wh	H	280	300
Slate	Gr	S	300	440
Lime	Wh	H	440	460
Slate	Gr	S	460	550
Slate	Blk	S	550	580
Coal	Blk	S	580	581
Lime	Wh	H	581	600
Slate	Dk	S	600	700
Sand	Wh	S	700	730
Lime	Wh	H	730	760
Slate	Wh	S	760	800
Lime	Wh	H	800	815
Coal	Blk	S	815	816
Lime	Wh	H	816	866
Sand	Wh	S	866	930
Rock	Pink	S	930	970
Red Rock		S	970	1000
Slate	Wh	S	1000	1100
Lime	Wh	H	1100	1150
Slate	Wh	S	1150	1200
Red Rock		S	1200	1230
Sand	Wh	H	1230	1270
Slate	Wh	S	1270	1350
Sand	Wh	H	1350	1380
Slate	Wh	S	1380	1420
Sand	Wh	S	1420	1800
Slate	Blk	S	1800	1830
Slate	Dk	S	1830	1900
Sand	Wh	H	1900	1940
Lime	Dk	H	1940	1942
Slate	Wh	S	1942	1949
Lime	Wh	H	1949	2050
Sand	Wh	H	2050	2070
Gas 2056				

1949  
1100  
849