

0 1 2 3

Latitude 39 30

1


2

3



1.515
0.76W

Longitude 81 05'

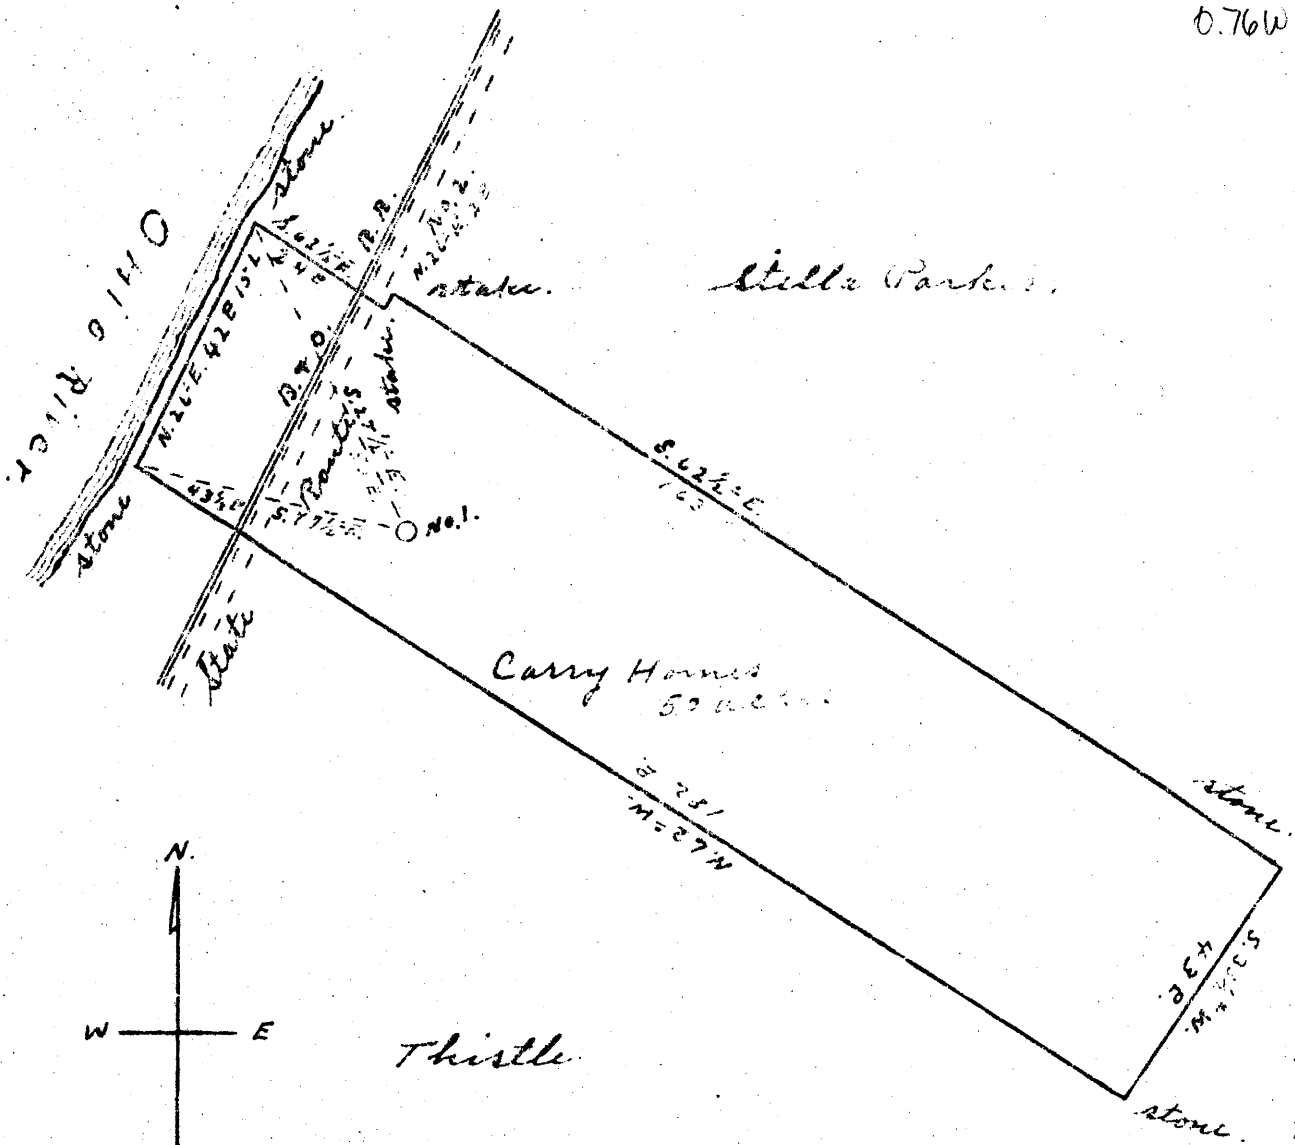

New Location
 Drill Deeper
 Abandonment

DMT

plugged 1950?

Company Doty & McElroy
 Address 322 blocking av. Sistrerville, W.Va.
 Farm Carry Hornes
 Tract _____ Acres 50 Lease No. _____
 Well (Farm) No. 1 Serial No. _____
 Elevation (Spirit Level) 648'
 Quadrangle St. Mar. 19. N
 County Tyler District Union
 Engineer Robert P. Anderson
By Geo. T. ...
 Engineer's Registration No. 296
 File No. _____ Drawing No. _____
 Date July 2 1949 Scale 1" = 30 P.

STATE OF WEST VIRGINIA
 DEPARTMENT OF MINES
 OIL AND GAS DIVISION
 CHARLESTON

WELL LOCATION MAP

FILE NO. JYL-167

+ Denotes location of well on United States Topographic Maps, scale 1 to 62,500, latitude and longitude lines being represented by border lines as shown.

- Denotes one inch spaces on border line of original tracing.